


Lloyd's Register of Shipping.

Ship's Name OKSYWIE


Official No.

Memorandum of alterations reported since ship was surveyed for assignment of Load Lines
in Abu on 28th February 1938.

4 Trimming hatchways, $2P \times 2S$, in way of $N^o 112$ Hatchways on the
Freeboard deck forward, fitted on some previous occasion, have ^{now} been
fitted with coaming $9' \times 3\frac{1}{2}' \times .40$ L, 2 cleats each side + end, battens +
2 tarpaulins + $2\frac{1}{2}'$ wood covers to
each hatchway and rest^{ing} bar.

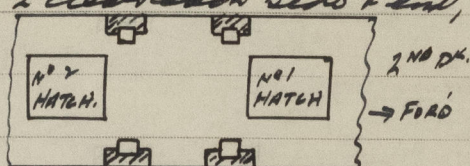

a doubling as shown in sketch has
also been fitted in way of each latching.

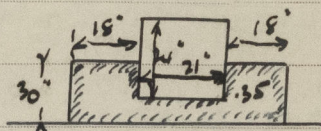

J. M. C.
 20th May 1940

toled
27/5/40