


12.7.12
14.10.12
27.10.12

DETAIL AT A, B, C & D PINTLES

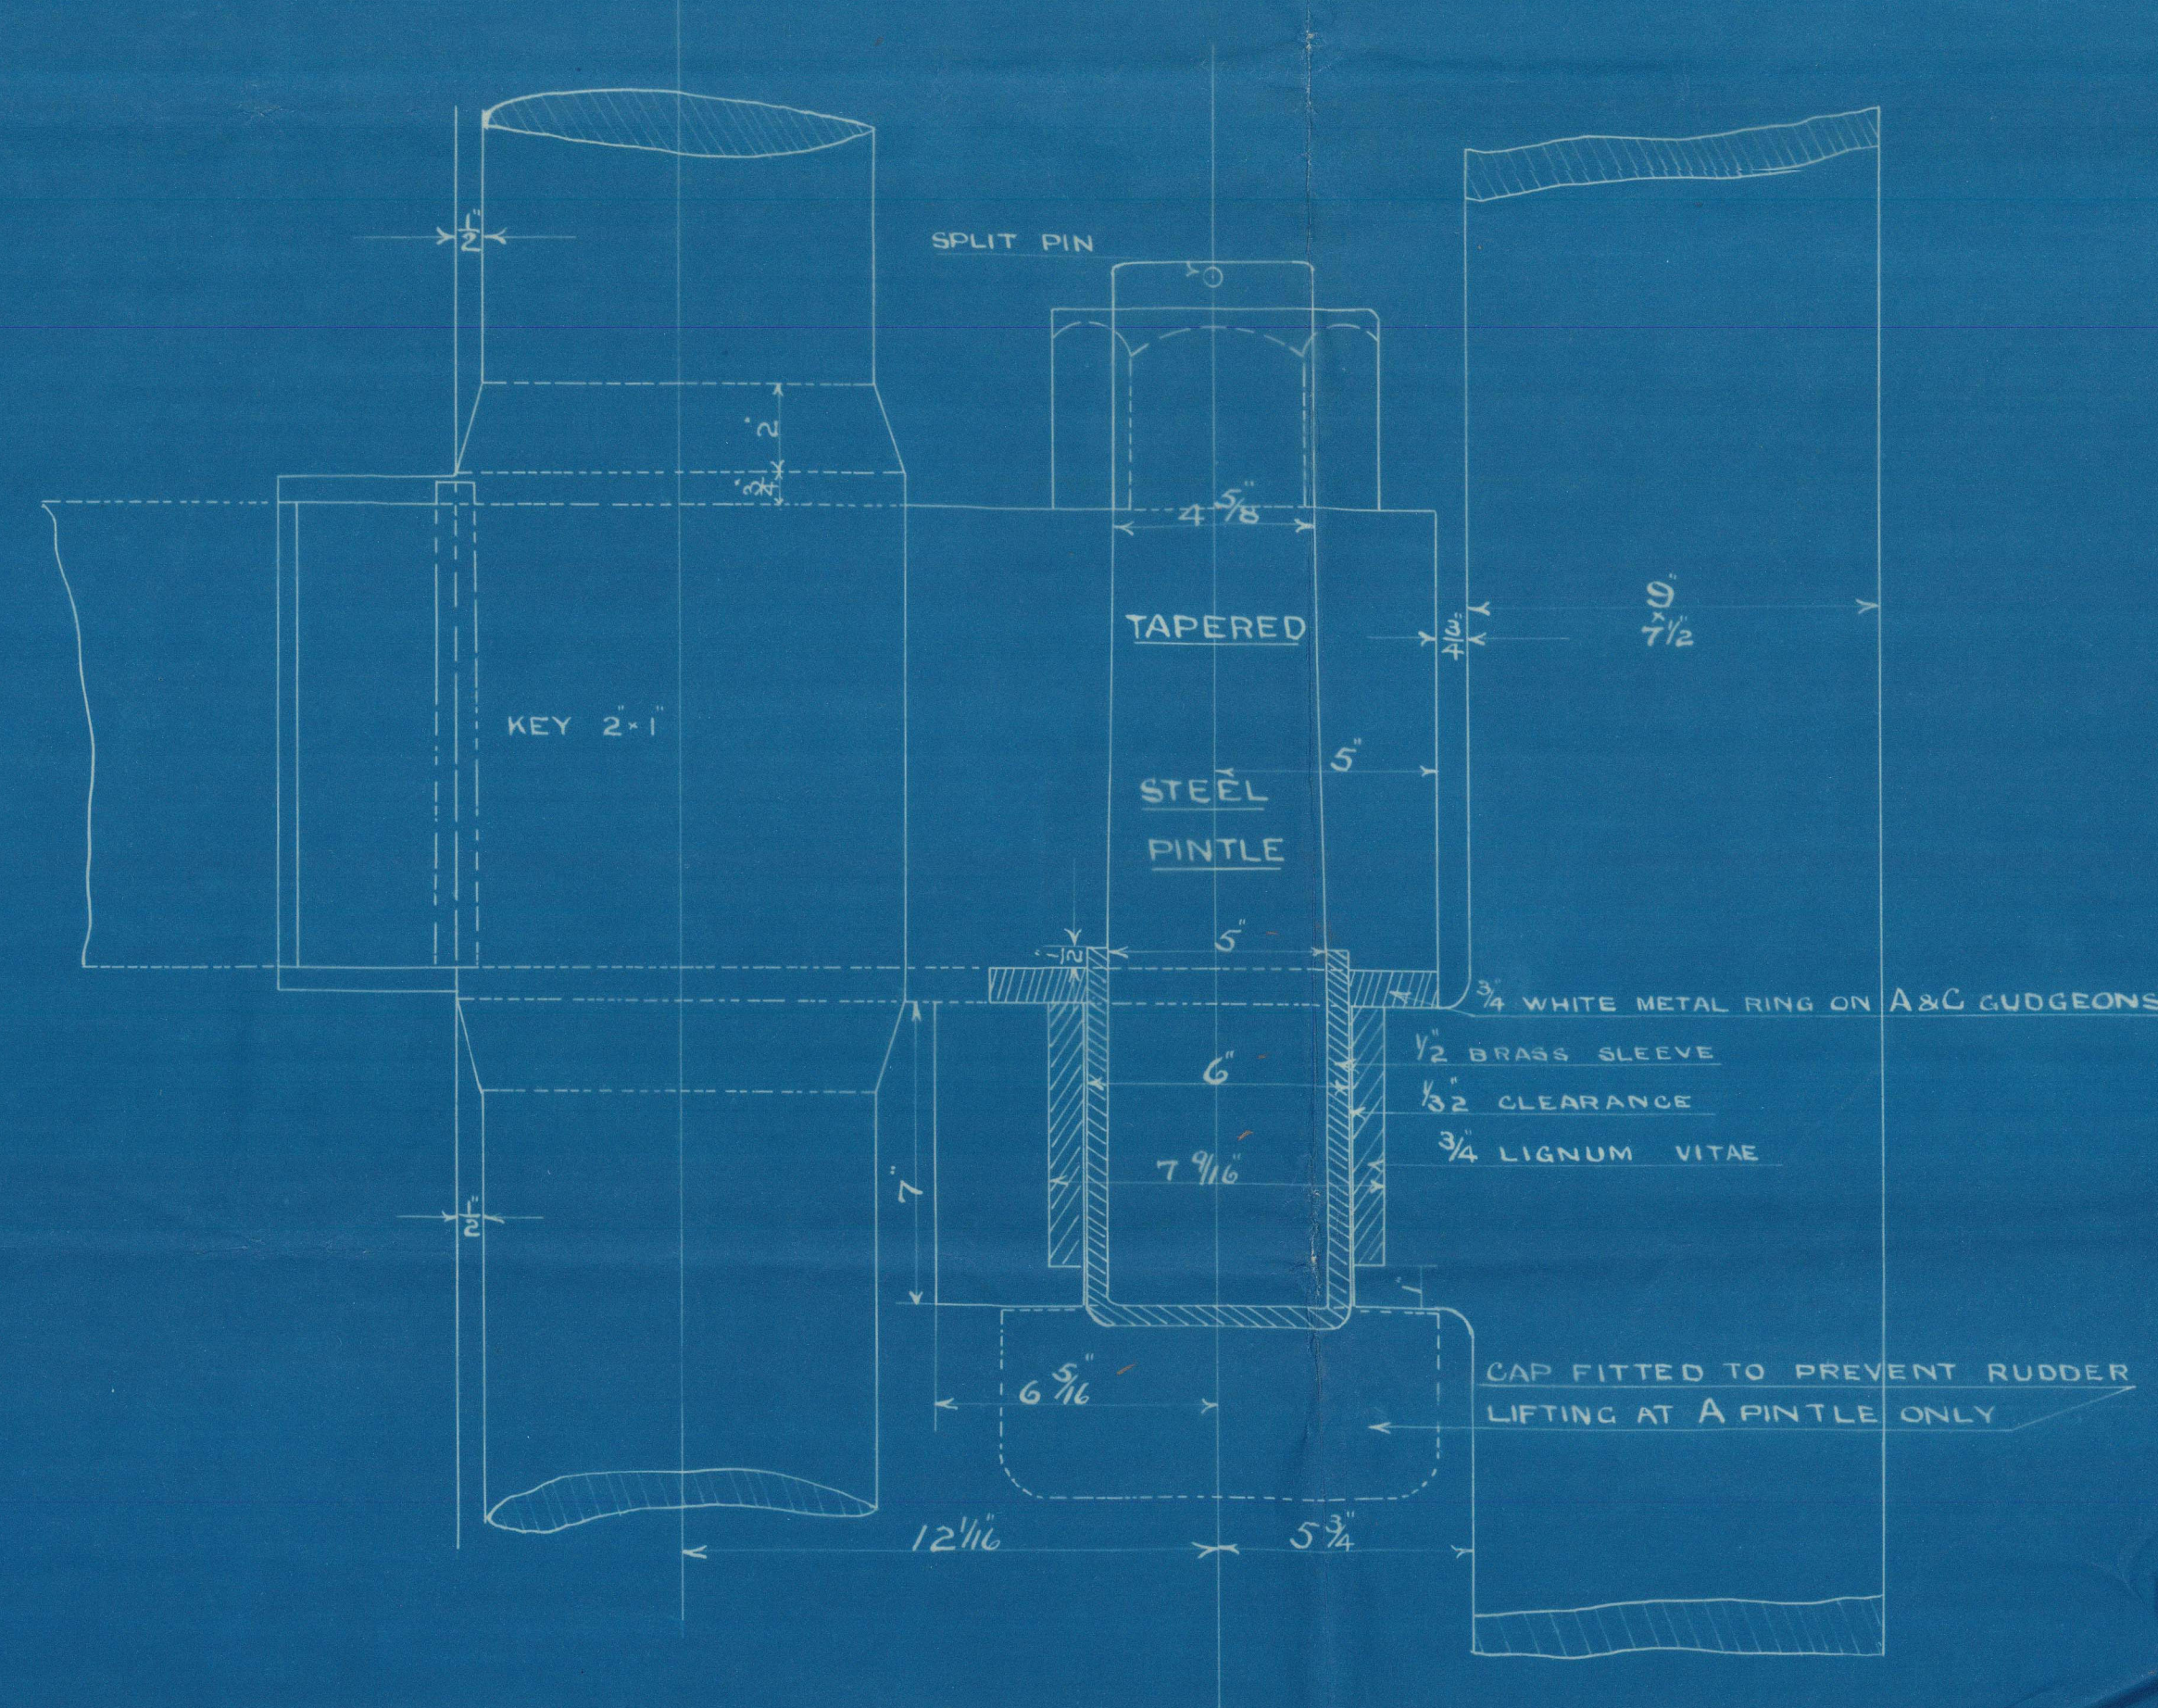


Sternpost & Rudder

Messrs A. Mc Millan & Son, Ltd.

S. S. No. 448 & 451.



"Tonegawa Maru"

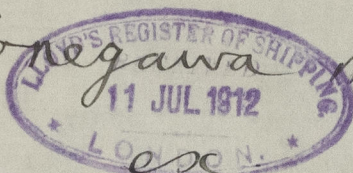

448

"Ceylon"

GLASGOW REPORT No. 33026.

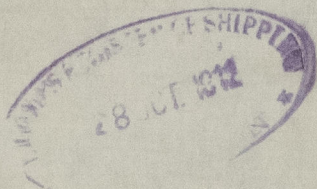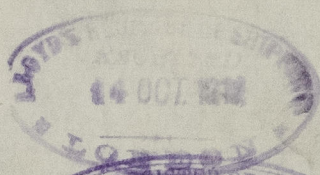

451 5/5 "Strabo"

GLASGOW REPORT No. 33284.



© 2020

Lloyd's Register
Foundation

007072-007077-0089

48
10
5
10
10

104