


18.10.13


T.S.S. No 259
PROFILE AND DECK PLAN
TO CLASS A-IRISH CHANNEL *Section No 2* CERT. B.O.T. LIMITED

SCALE - 1/4" = 1 FOOT

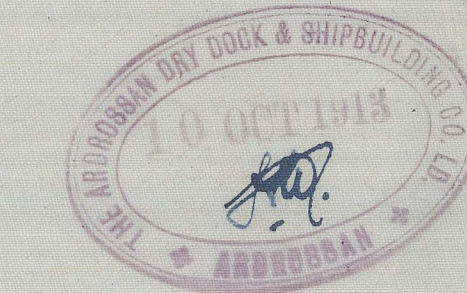


DIMENSIONS	
LENGTH B.P.	160' 0"
BREADTH M.P.	26' 0"
DEPTH	9' 6"
MAIN DECK TO PROMENADE DECK (Beam to Beam)	7' 0"
LOWER DECK AIR? (" ")	7' 0"

CASING AND HOUSES ON MAIN DECK	
COAMING	30"
SIDES	24"
STIFFENERS SPACED 30" APART	2 1/2" x 2 1/2" x 24"

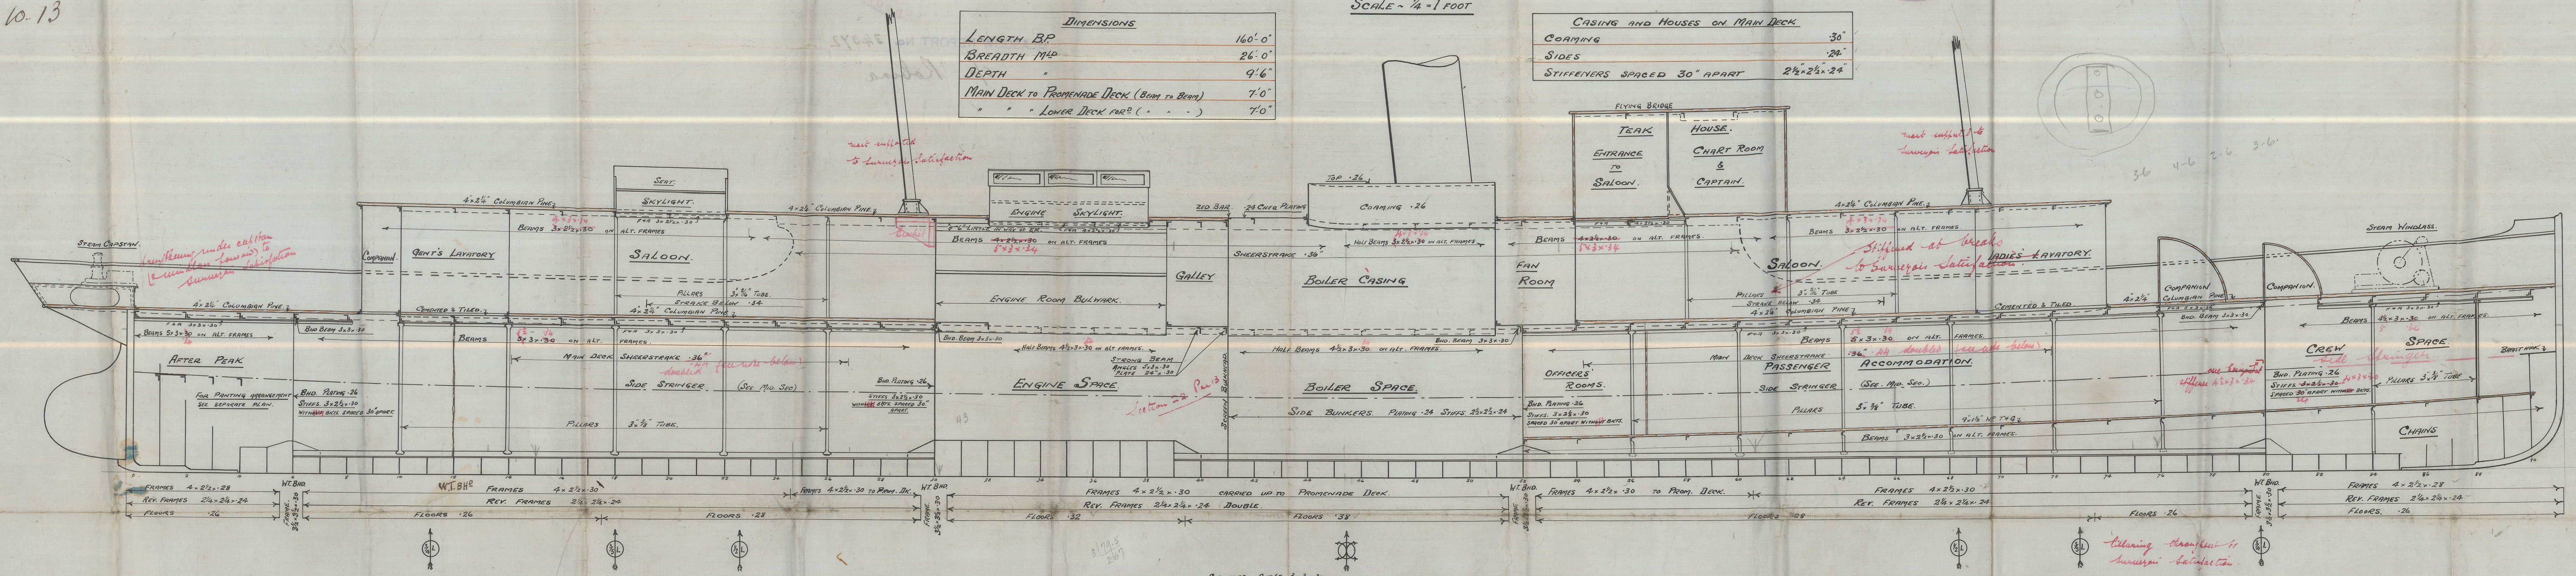

PLAN OF PROMENADE DECK

PLAN OF MAIN DECK

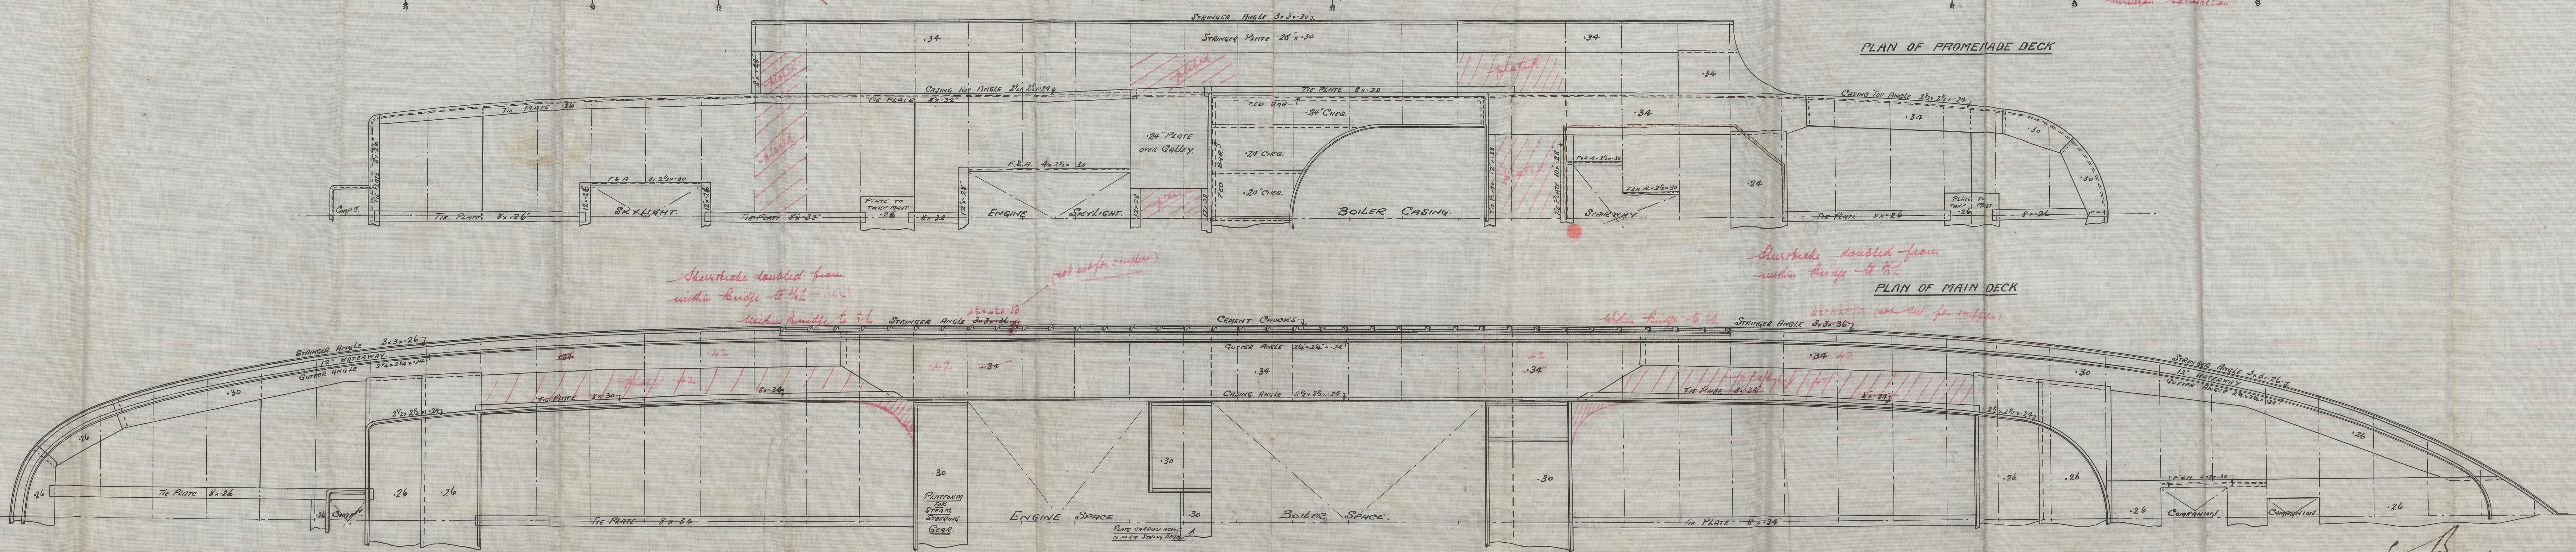


C.B.
17.10.13

Androman Shp. Coys
No 259
Profile & Decks

GLASGOW REPORT No. 34072

s/s "Robina"

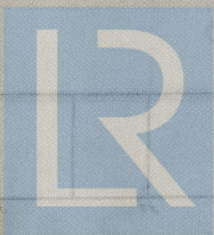

© 2021

Lloyd's Register
Foundation