


◦ S. S. N^o 259 ◦

ROSSAN DRY DOCK & SHIPBUILDING
10 OCT 1913
ROSSAN

TO CLASS - A - "IRISH CHANNEL" ^{Scheme} No 2 CERT. B.O.T. LIMITED.

© SCALE $\frac{1}{2}" = \text{ONE FOOT}$ ©

LLOYOS NOS TO MAIN D ^K	LLOYOS NOS TO BRIDGE D ^K	EQUIPMENT NO
B+D = 35.5 = 1 ST NO ✓	B+D = 42.5 = 1 ST NO ✓	LONG ^L NO 5680
L(B+D) = 5680 = 2 ND NO ✓	L(B+D) = 6800 = 2 ND NO ✓	BRIDGE 325
$\frac{L}{D} = 16.85$ to main deck	$\frac{L}{D} = 9.7$ to bridge deck	ERECTIONS 224
d = 8.37	d = 8.37	6229

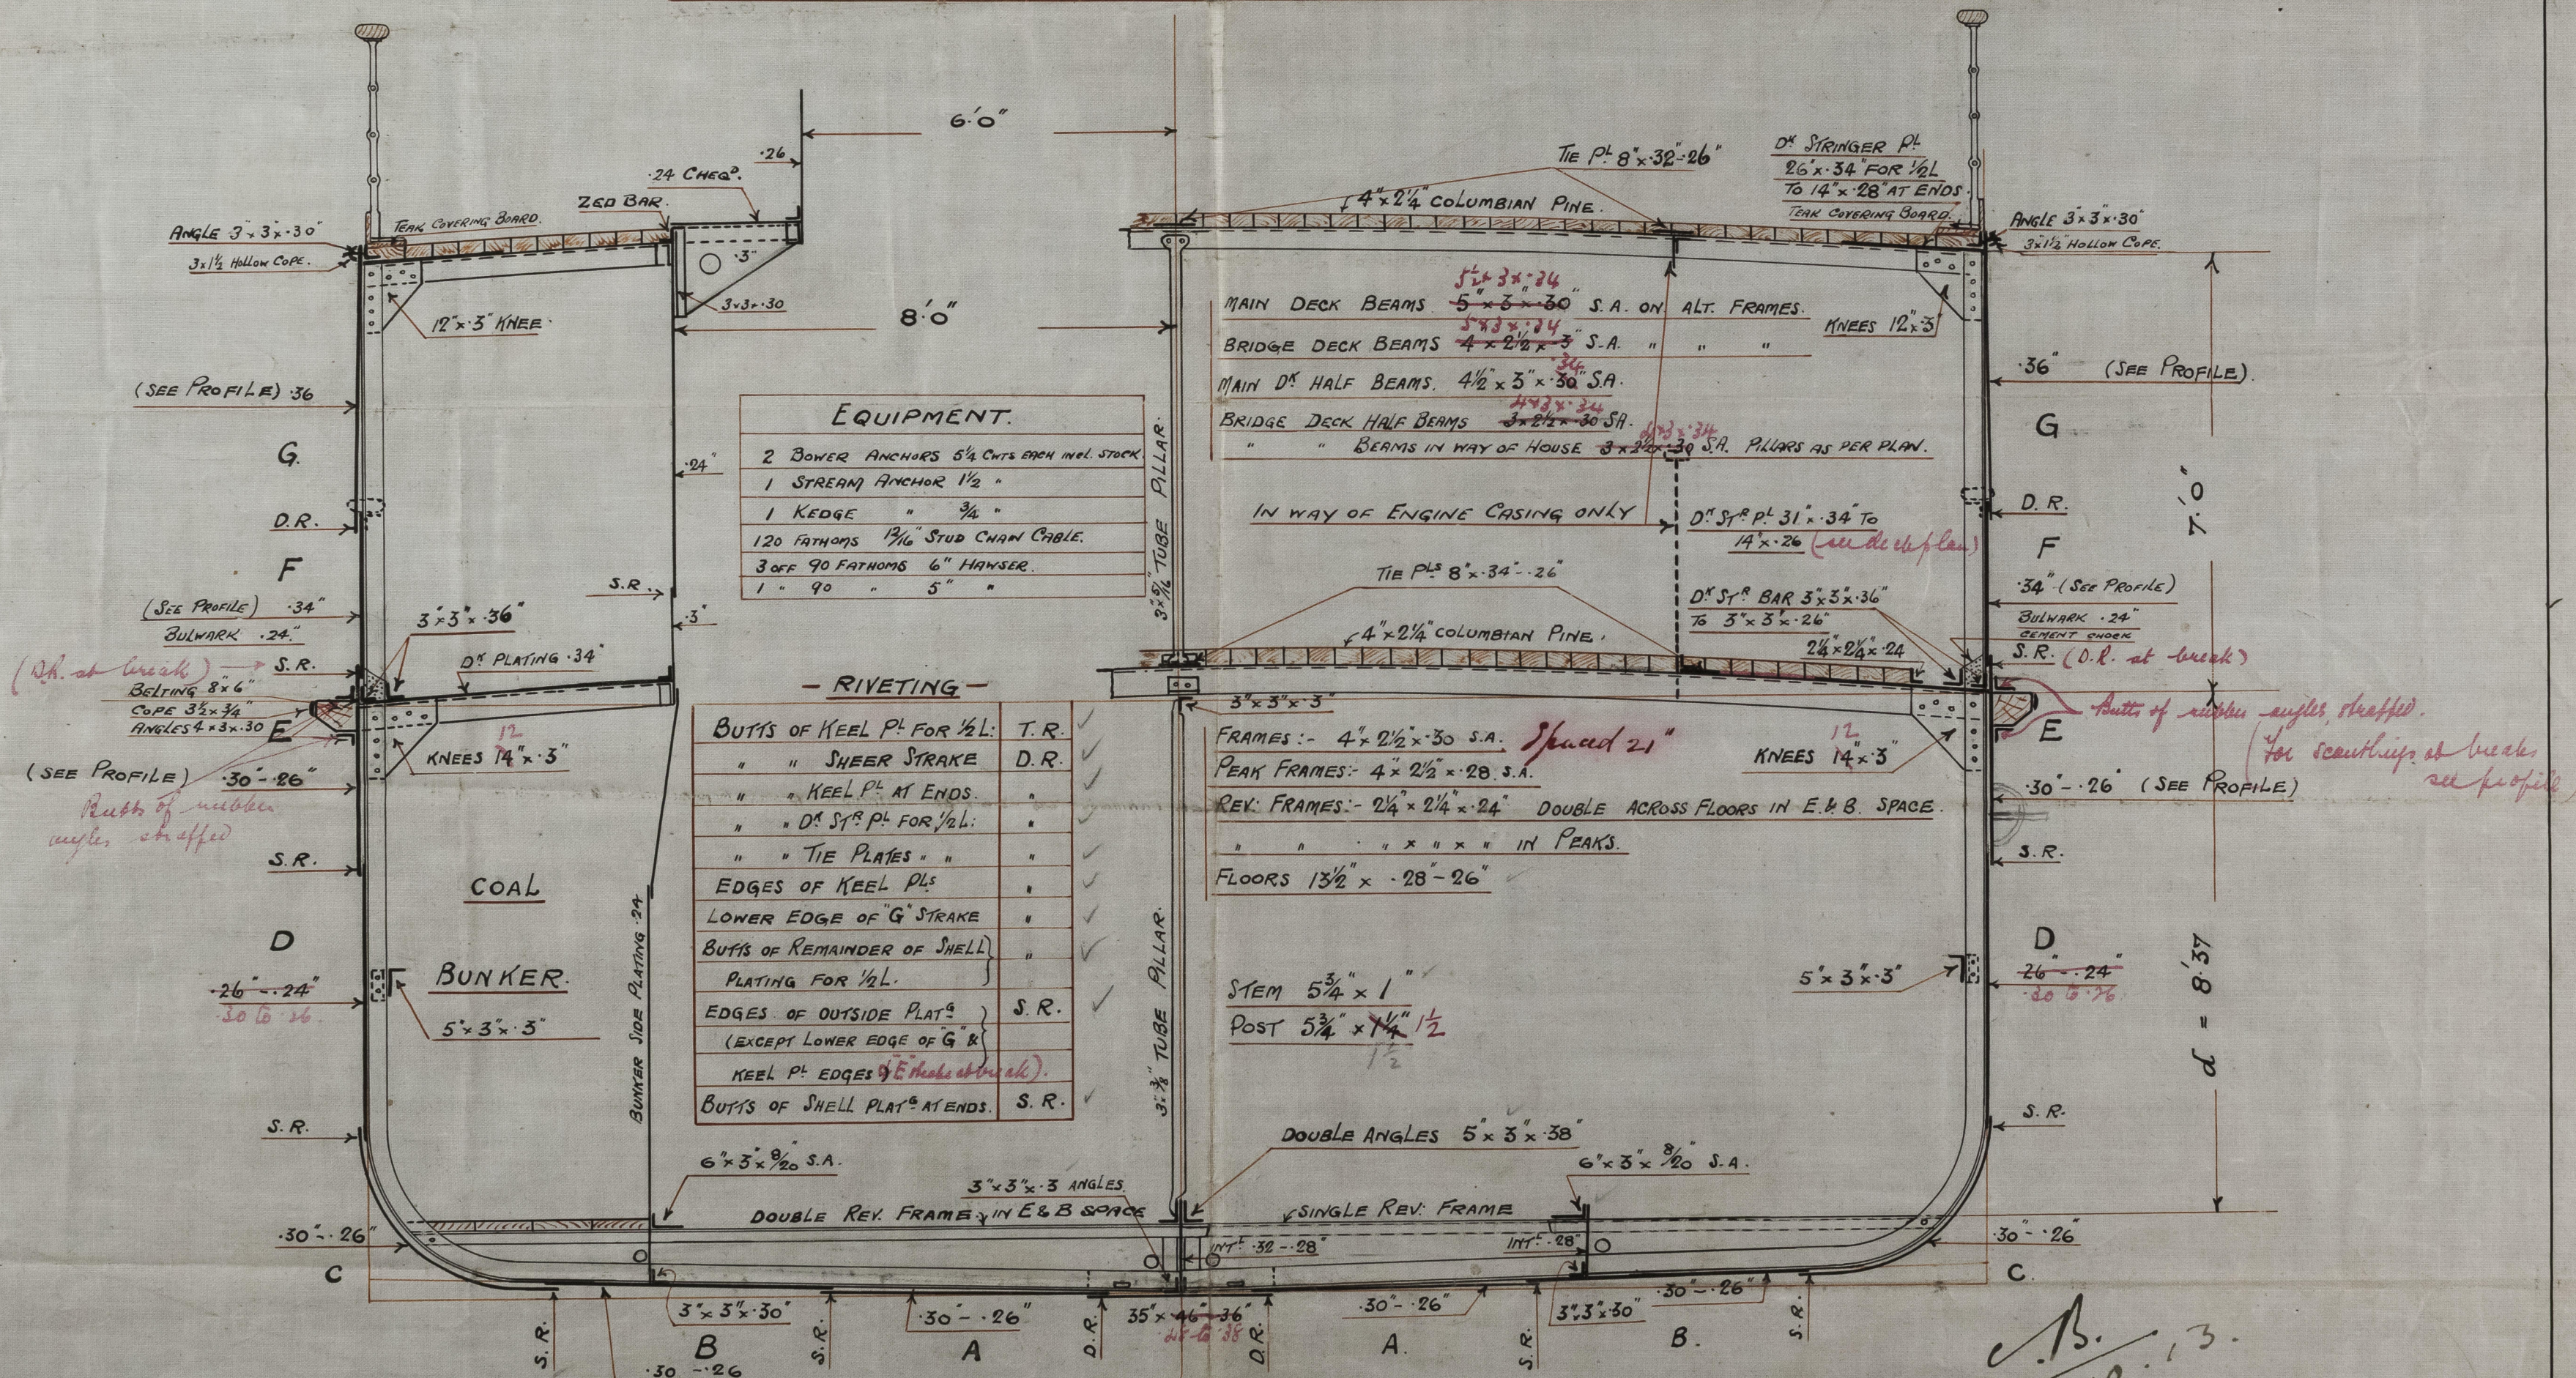

c.B.
17.10.13.

Archibornan Shy. Cep
No 259
Midship Section

GLASGOW REPORT No. 34072.
s/s "Robina"



© 2021

Lloyd's Register
Foundation

007078-007027-0089