

Rpt. C.II. **DISCLOSED SECTION**

25 MAR 1946
Index No. 23698
(For London Office only)


Lloyd's Register of Shipping.

No. 424
Jhr 6223

SURVEYS FOR FREEBOARD.
(CONDITIONS OF ASSIGNMENT.)

Ship's Name **T.S.S. "ROBINA"** Port of Survey **LIVERPOOL**
Official Number **135726** Surveyor's Signature *Amish C. Murray*
Nationality and Port of Registry **BRITISH FALMOUTH** Date of Survey **16th, 19th & 21st March, 1946.**

Disposition and dimensions of superstructures, trunks, deckhouses and machinery casings to be inserted in the diagrams and tabular statement: --

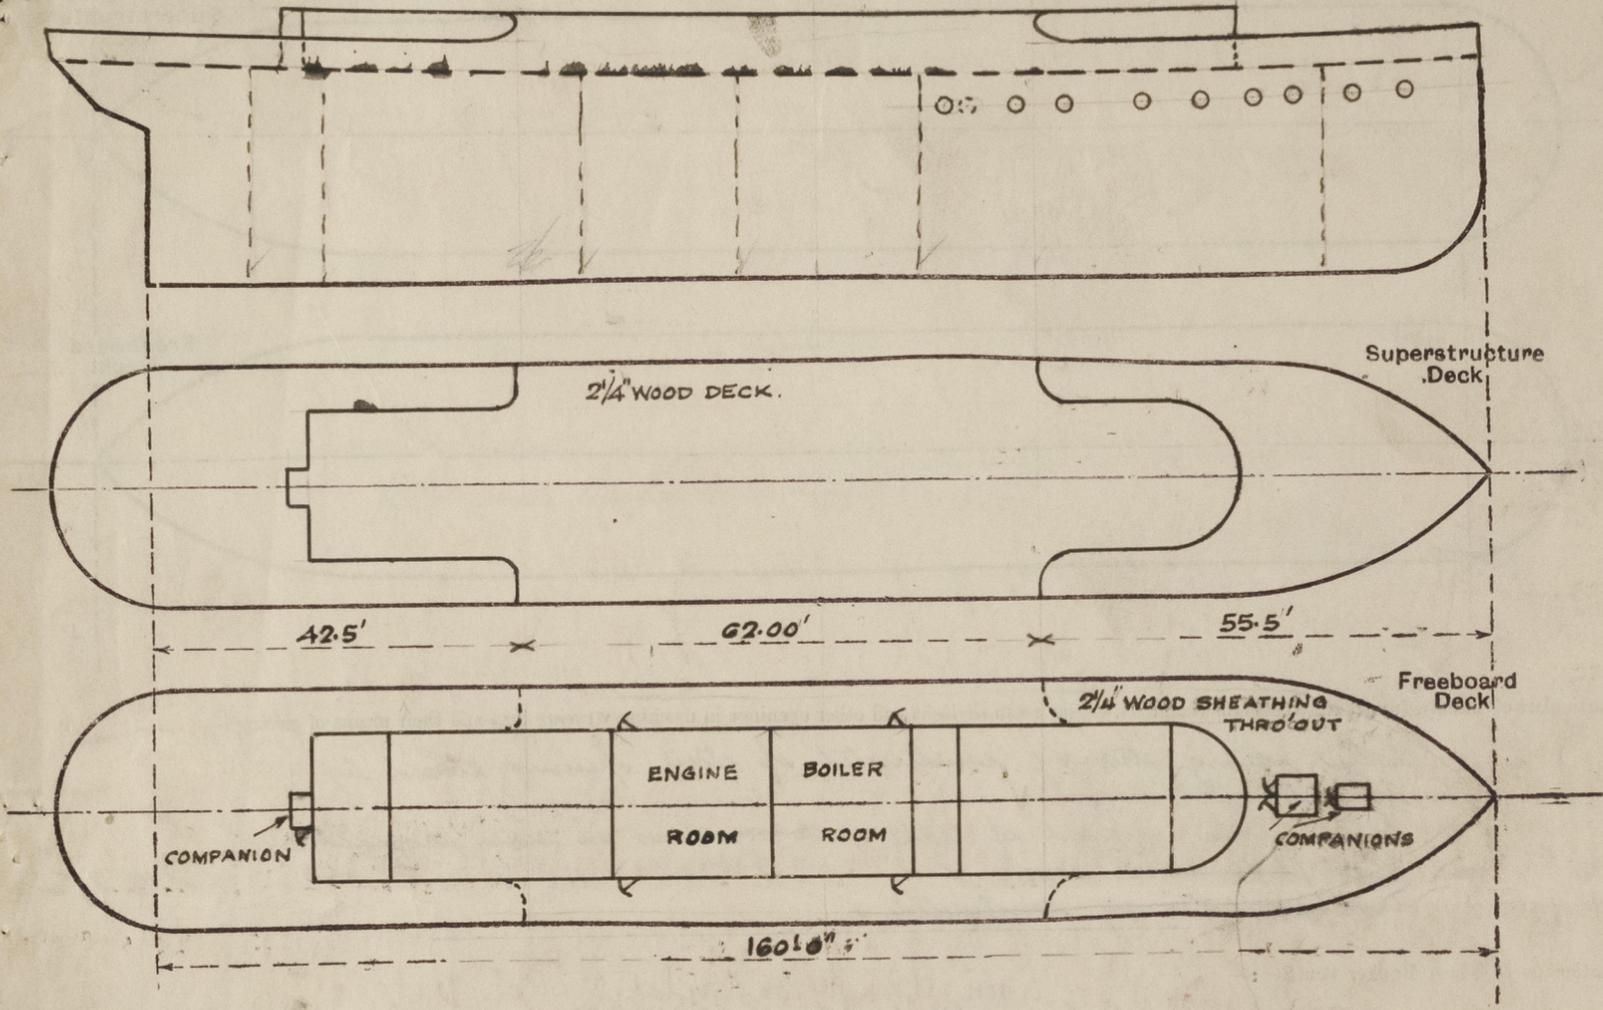

Particulars of Superstructures, Trunks, Casings, Deckhouses.								
	Coaming	Plating	Stiffeners	Spacing	End Attachments of Stiffeners	Size of Openings	Height of Sills	Height of Casings
Poop Bulkhead ...								
Raised Quarter Deck Bulkhead ...								
Bridge, After Bulkhead ...	OPEN							
Bridge, Forward Bulkhead ...								
Forecastle Bulkhead ...								
Trunk, Aft ...								
Trunk, Forward ...								
Exposed Machinery Casings on Freeboard or Raised Quarter Decks ...								
Exposed Machinery Casings on Superstructure Decks26"				NONE		2.5'
Machinery Casings within Superstructures not fitted with Class I Closing Appliances30	.25	2 1/2 x 2 1/2 x 5/16"	27"	NONE	5'-0" x 2'-0"	13"	7.0'
Deckhouses on Flush Deck Ships ...								

Particulars of Closing Appliances (state if capable of being manipulated from both sides).	
Poop Bulkhead ...	
Raised Quarter Deck Bulkhead ...	
Bridge, After Bulkhead ...	OPEN ✓
Bridge, Forward Bulkhead ...	
Forecastle Bulkhead ...	
Exposed Machinery Casings on Freeboard or Raised Quarter Decks ...	
Exposed Machinery Casings on Superstructure Decks ...	
Machinery Casings within Superstructures not fitted with Class I Closing Appliances ...	No openings 2 Hinged teak doors to Engine Room 2 Hinged steel doors to Boiler Room } operated from both sides ✓
Deckhouses on Flush Deck Ships ...	

1/2 8800-180700-24000



PARTICULARS OF PROTECTION TO OPENINGS, ETC.

HATCHWAYS ON FREEBOARD AND SUPERSTRUCTURE DECKS.											
Description of Hatchway	
Dimensions of Hatchway	
COAMINGS	} Height above Deck	...	} Sides	...	} Ends	...	} Stiffeners	...	} Brackets, Stays
		
		
		
HATCH BEAMS	} Number	...	} Spacing	...	} Scantling and Sketch	...	} Bearing Surface	...	}
		
FORE AND AFTERS	} Number	...	} Spacing	...	} Unsupported Lengths	...	} Scantling* and Sketch	...	} Bearing Surface
		
HATCH COVERS	} Material	...	} Thickness	...	} How fitted	...	} Bearing Surface	...	}
		
		
		
Spacing of Cleats		...									
Number of Tarpaulins		...									
<p>*Are wood fore and afters steel shod at all bearing surfaces ?</p> <p>Are battens and wedges efficient and in good condition ?</p> <p>Are tarpaulins in good condition and in accordance with rule requirements ?</p> <p>Are lashings provided in accordance with rule requirements ?</p>											

HATCHWAYS ✓

No

Particulars of any special features :—

Endorsement at first survey and at surveys for renewal of Certificate :—

The fittings and appliances are in accordance with the particulars shown on this form (or as now modified) and are in good condition.

Sanjay B. Murray

om

