


## SS N° 30

WRITTEN DIMENSIONS ONLY TO BE TAKEN

PLAN OF RUDDER STOPPER

—SKETCH OF GUDGEON & PINTLE—

SCALE 3" = 1 FOOT

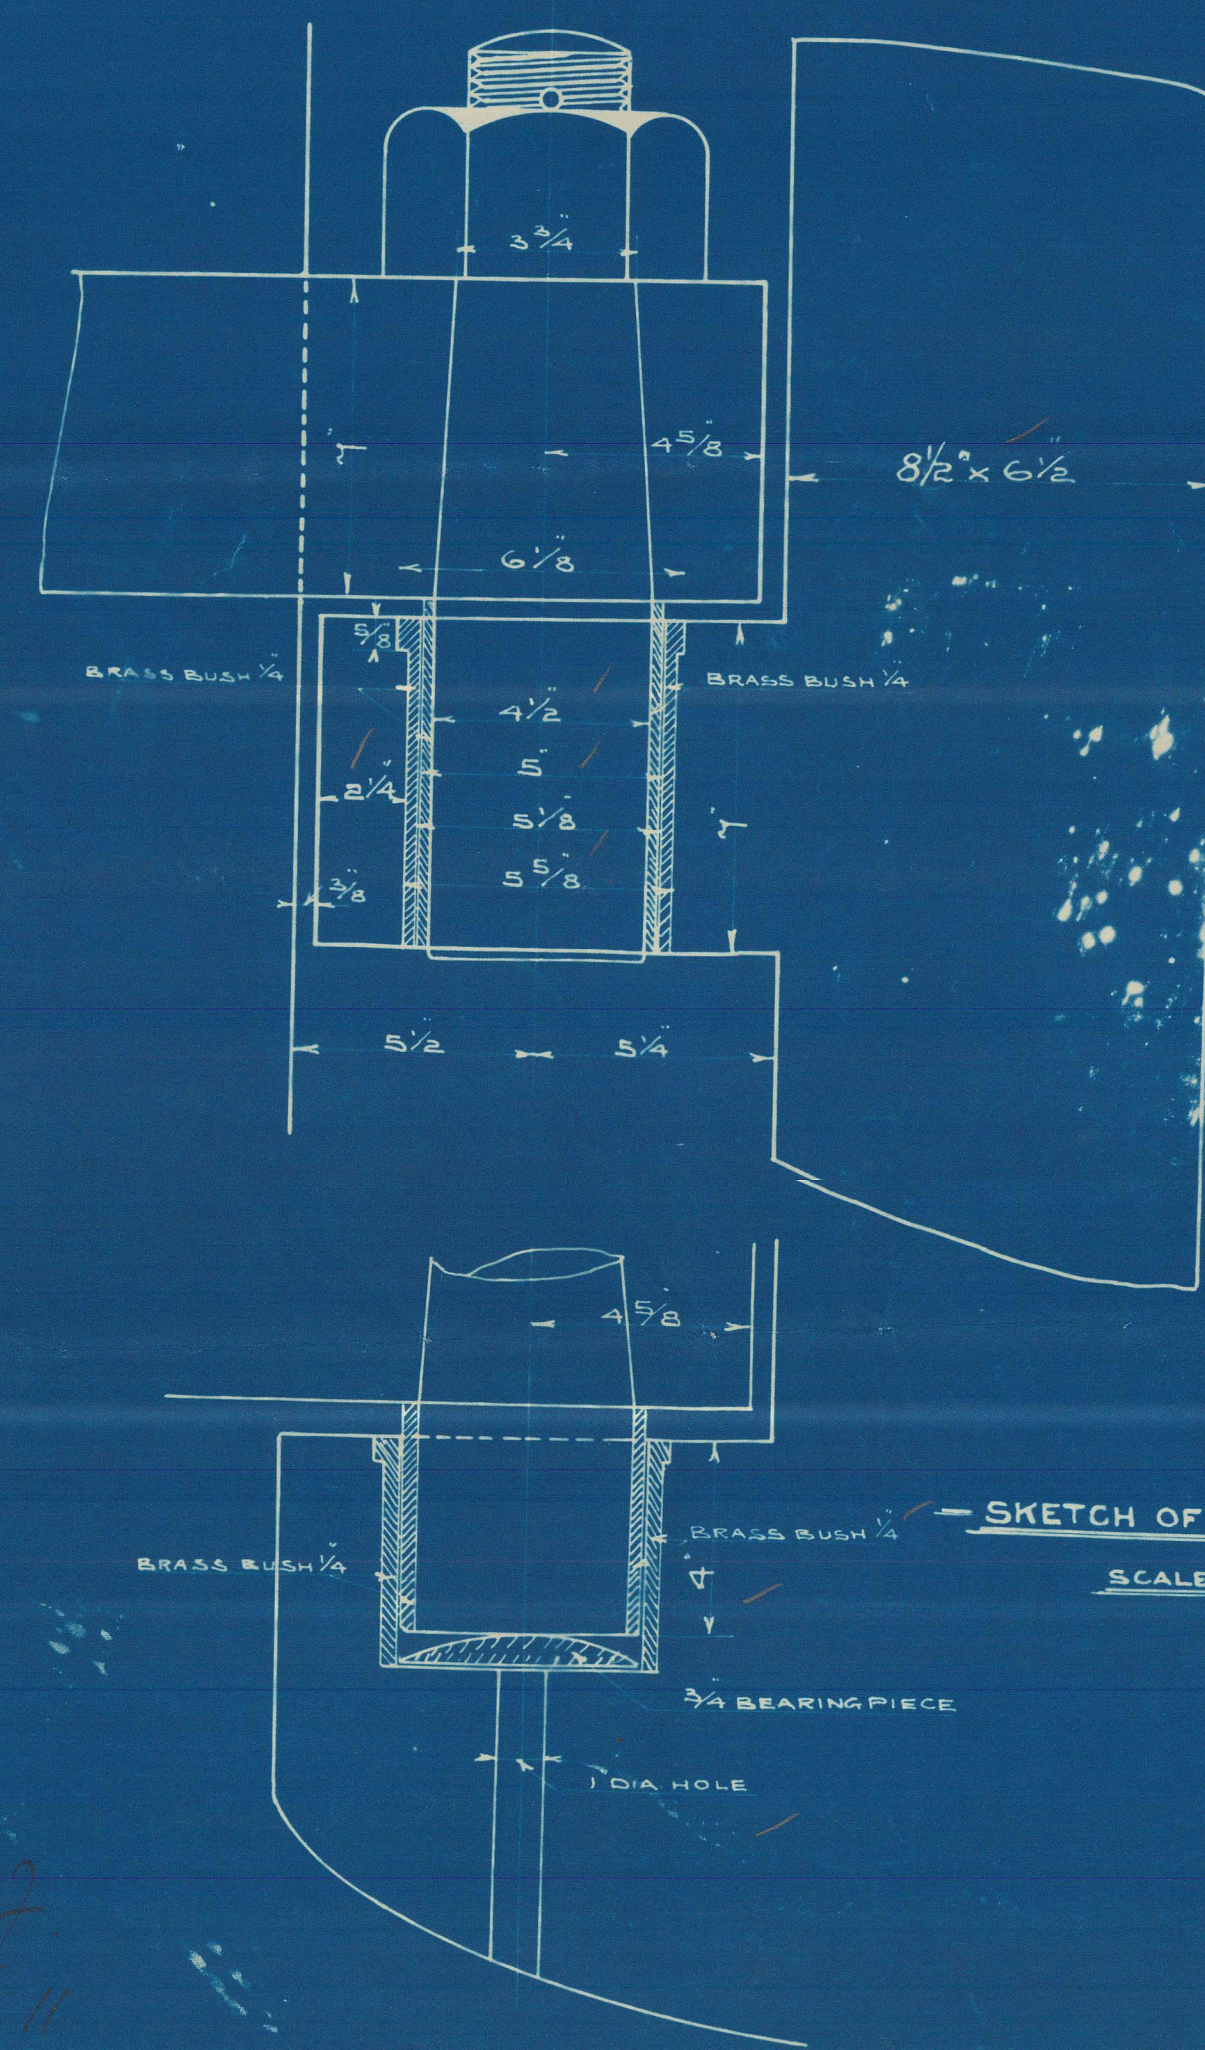

SKETCH OF BOTTOM GUDGEON.


SCALE 3"=1FOOT

Plan of. Rudder and Sternframe

J. P. Cooldyk

Edam report. no = 7671<sup>2</sup>  
10057<sup>2</sup>

<sup>n</sup> Agnes <sup>r</sup>

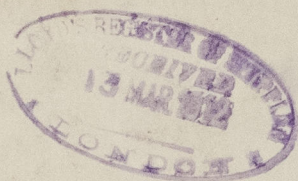


© 2021

Lloyd's Register  
Foundation

007078-007087-0254

Rov & Achterhoven

N<sup>o</sup> 30

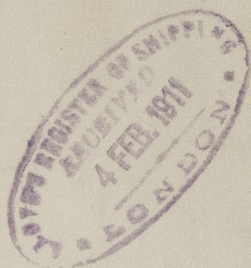

007078-007087-0254



© 2021

Lloyd's Register  
Foundation