

NO 8. MIDSHIP SECTION.

SCALE $\frac{1}{2}$ INCH TO ONE FOOT.

270'-0" X 39'-0" X 23'-11"

(造船規程第壹級船)

LLOYD'S 100.A.I.






"Sapporo Mass No 8"
Yka 2658.



© 2020

Lloyd's Register
Foundation

007100-007115-0160

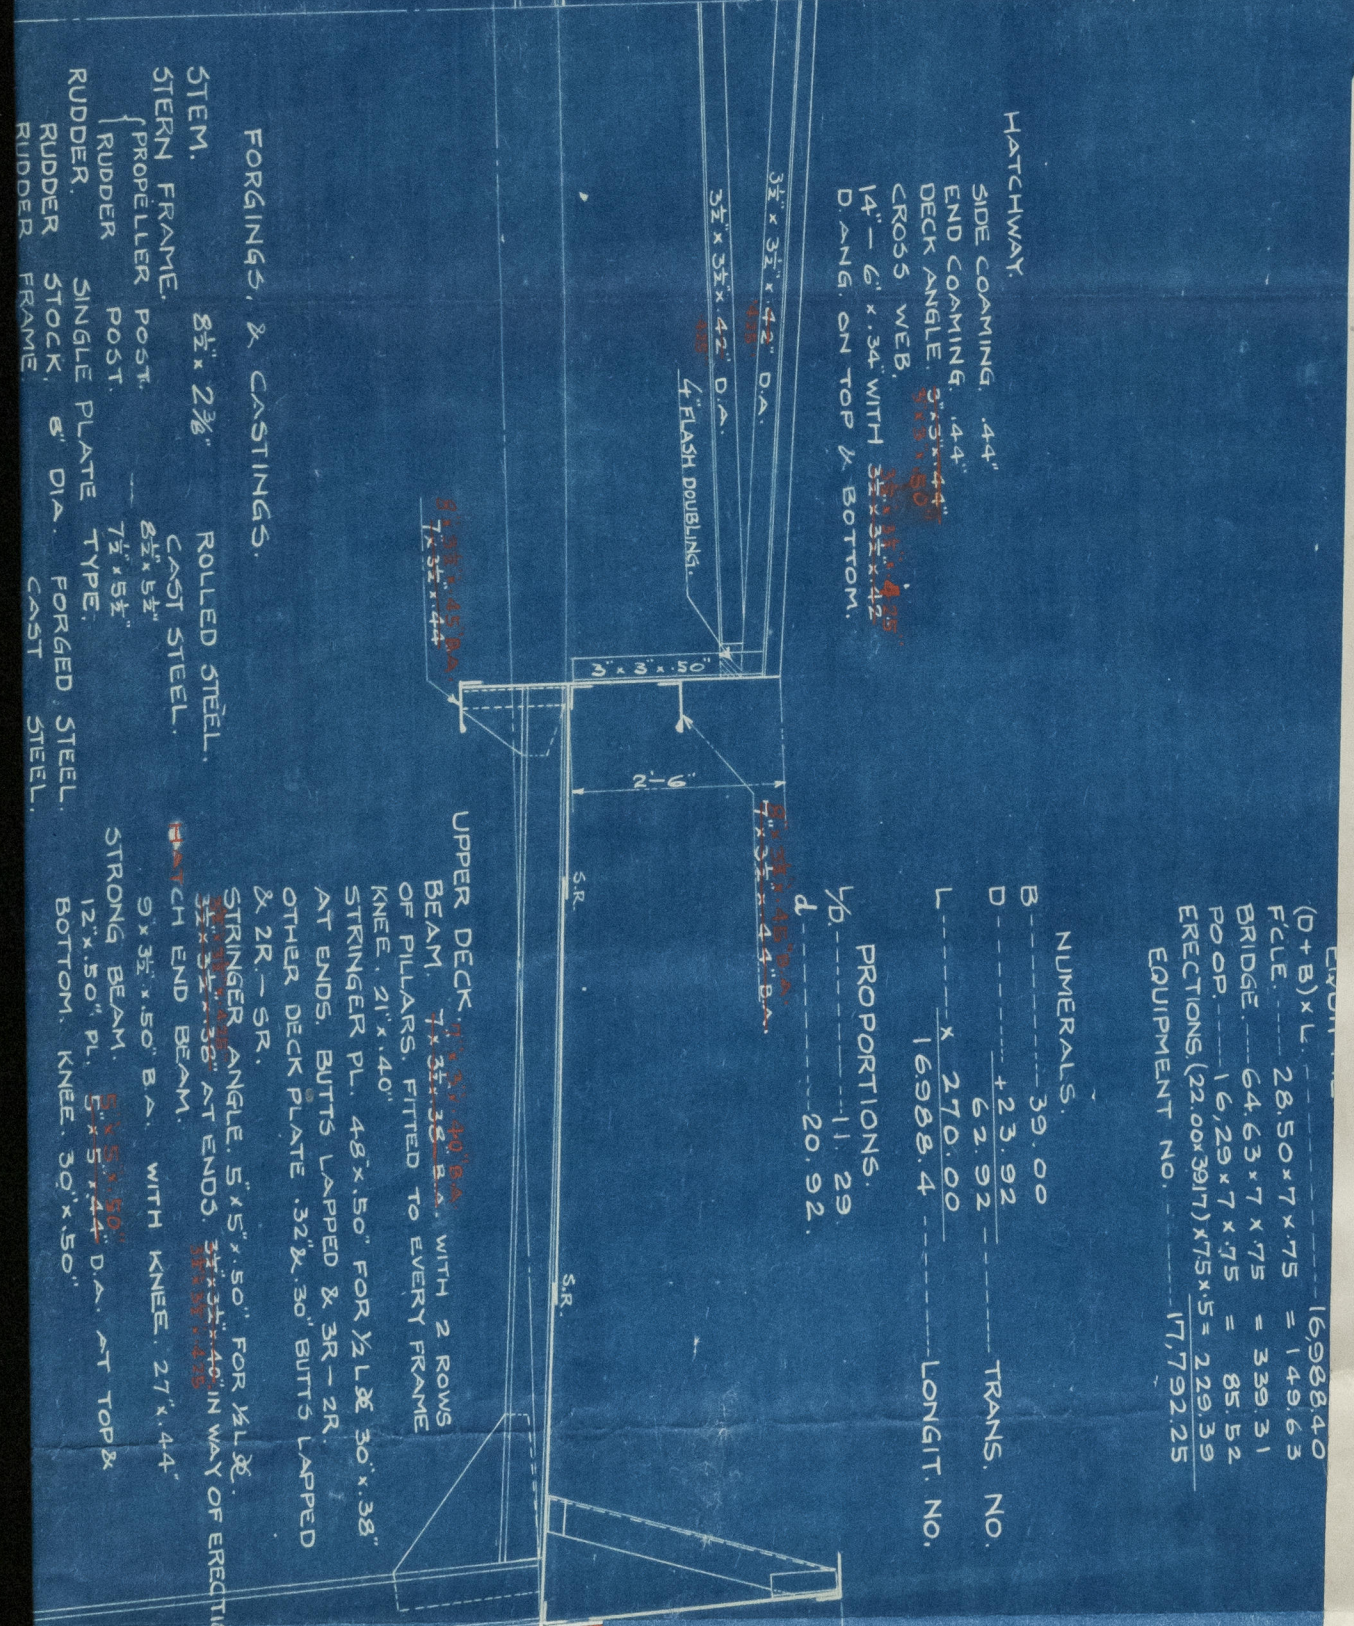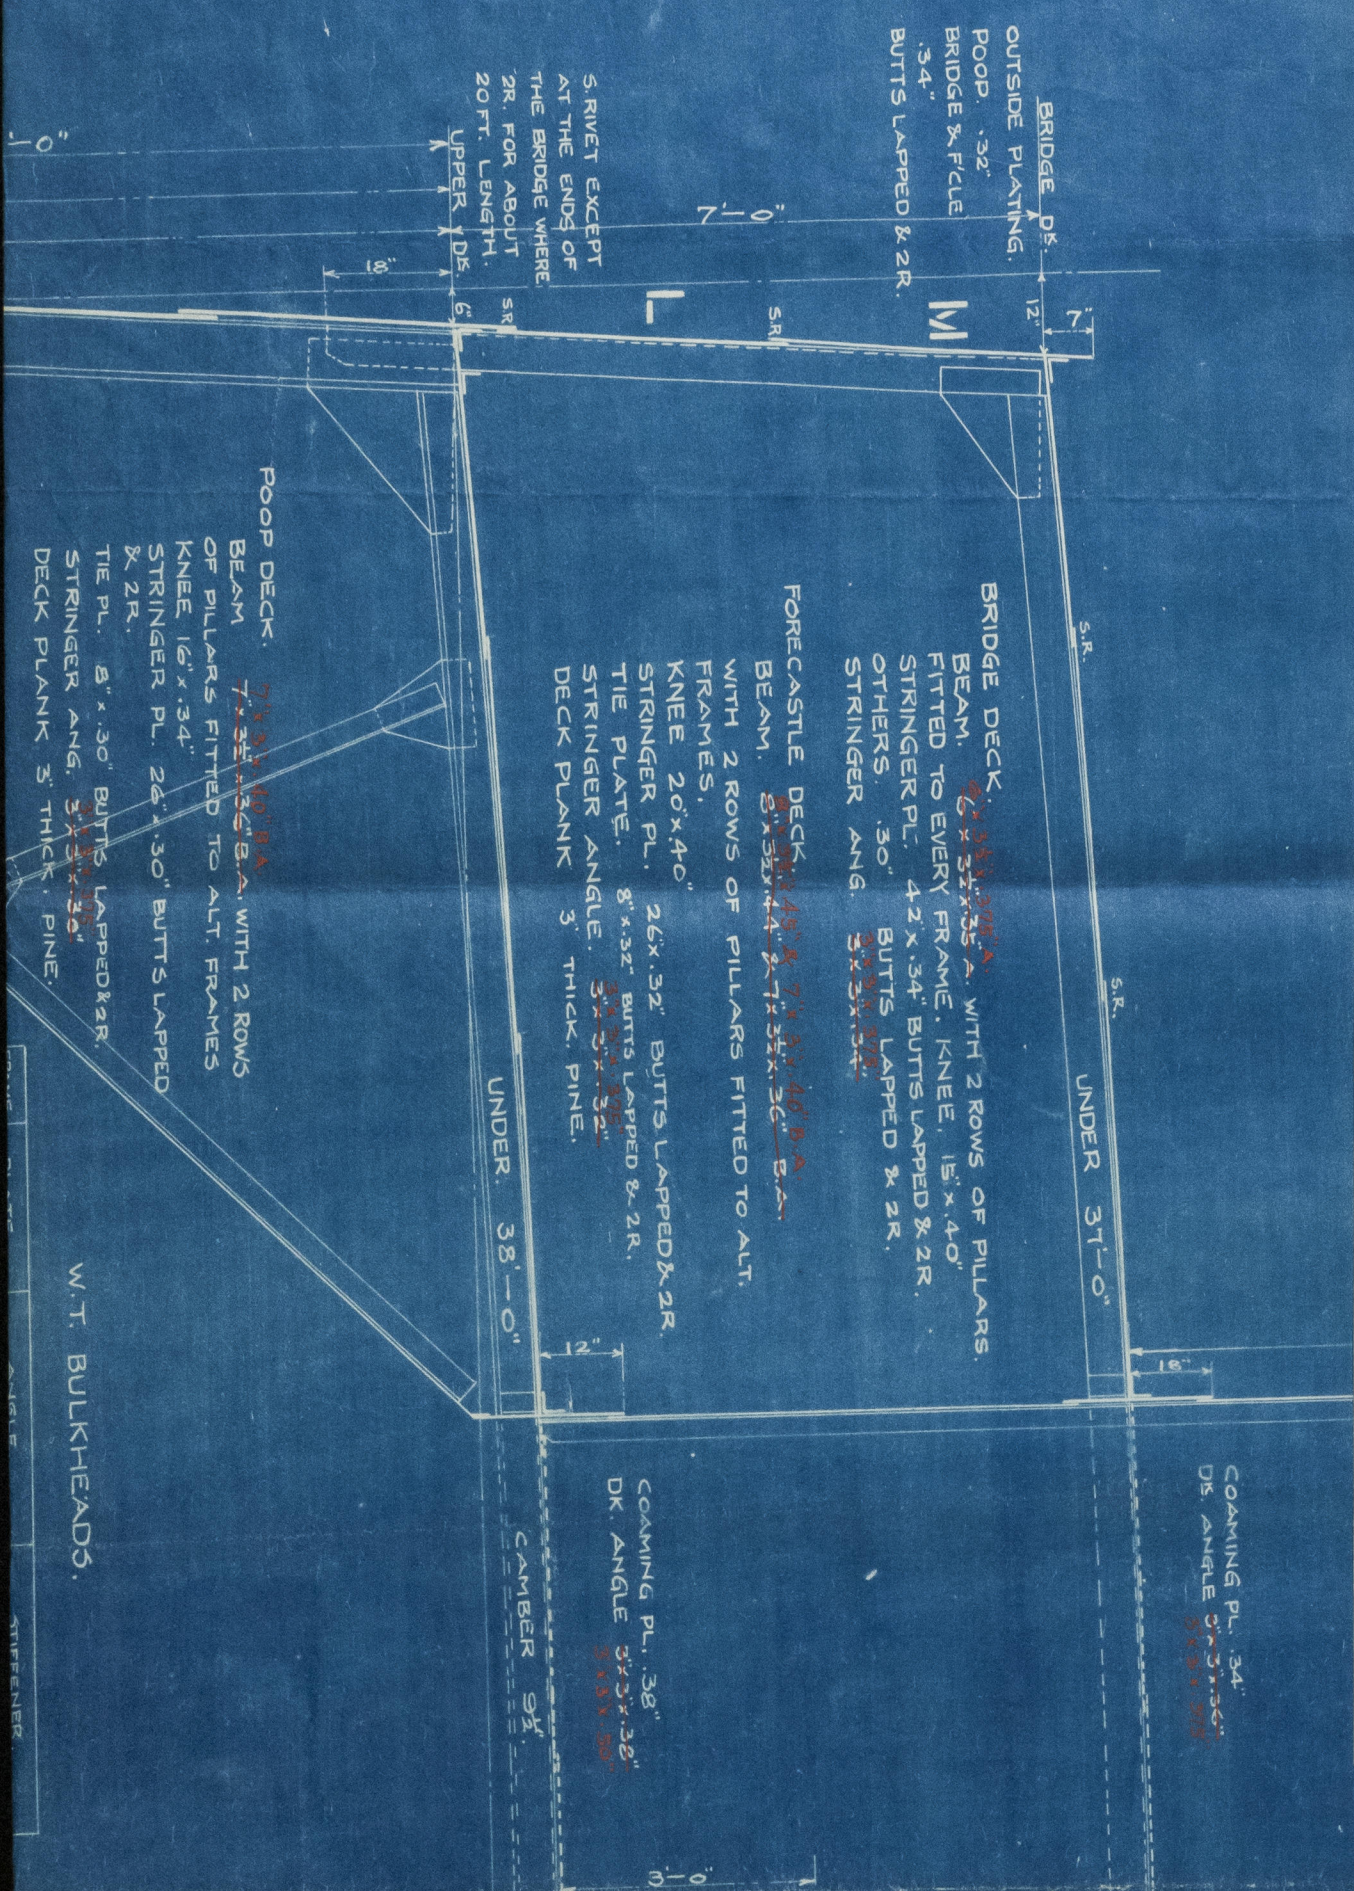

NUMERALS.

B	39.00	TRANS. NO.
D	62.92	
L	270.00	LONGIT. NO.
16988.4		

PROPORTIONS.



48.78
1.78
1.00
2.08

0910-51400-00160