

MIDSHIP SECTION

"ELITE" N°282

SCALE $\frac{1}{2}$ " = 1 FOOT.

WORKING PLAN.


STEEL SCREW STEAM FLEETERS TO CLASS 100 A.1. AT LLOYDS.

DIMS 108'6" B.R. x 21'5" M.D. BREADTH x 11'6" M.D. DEPTH.

NUMERALS	
HALF MOULDED BREADTH	10.70
DEPTH TOP OF KEEL (NORMAL)	11.95
HALF MIDSHIP GIRTH	18.33
FIRST NUMERAL	40.98
LENGTH AS PER RULE	107.34
SECOND NUMERAL	4398.79

PROPORTIONS	
$\frac{L}{D} = 8.98$	$\frac{L}{B} = 5.01$

EQUIPMENT	
NUMBER	4398.79
ANCHOR	1 1/4 CUTS EX STOCK
1 "	4 1/2 "
1 "	2 1/2 "
40 FATHOMS	1 5/16" SHORT LINK CHAIN
60 "	5 1/2" HAWSER
60 "	4" WARP

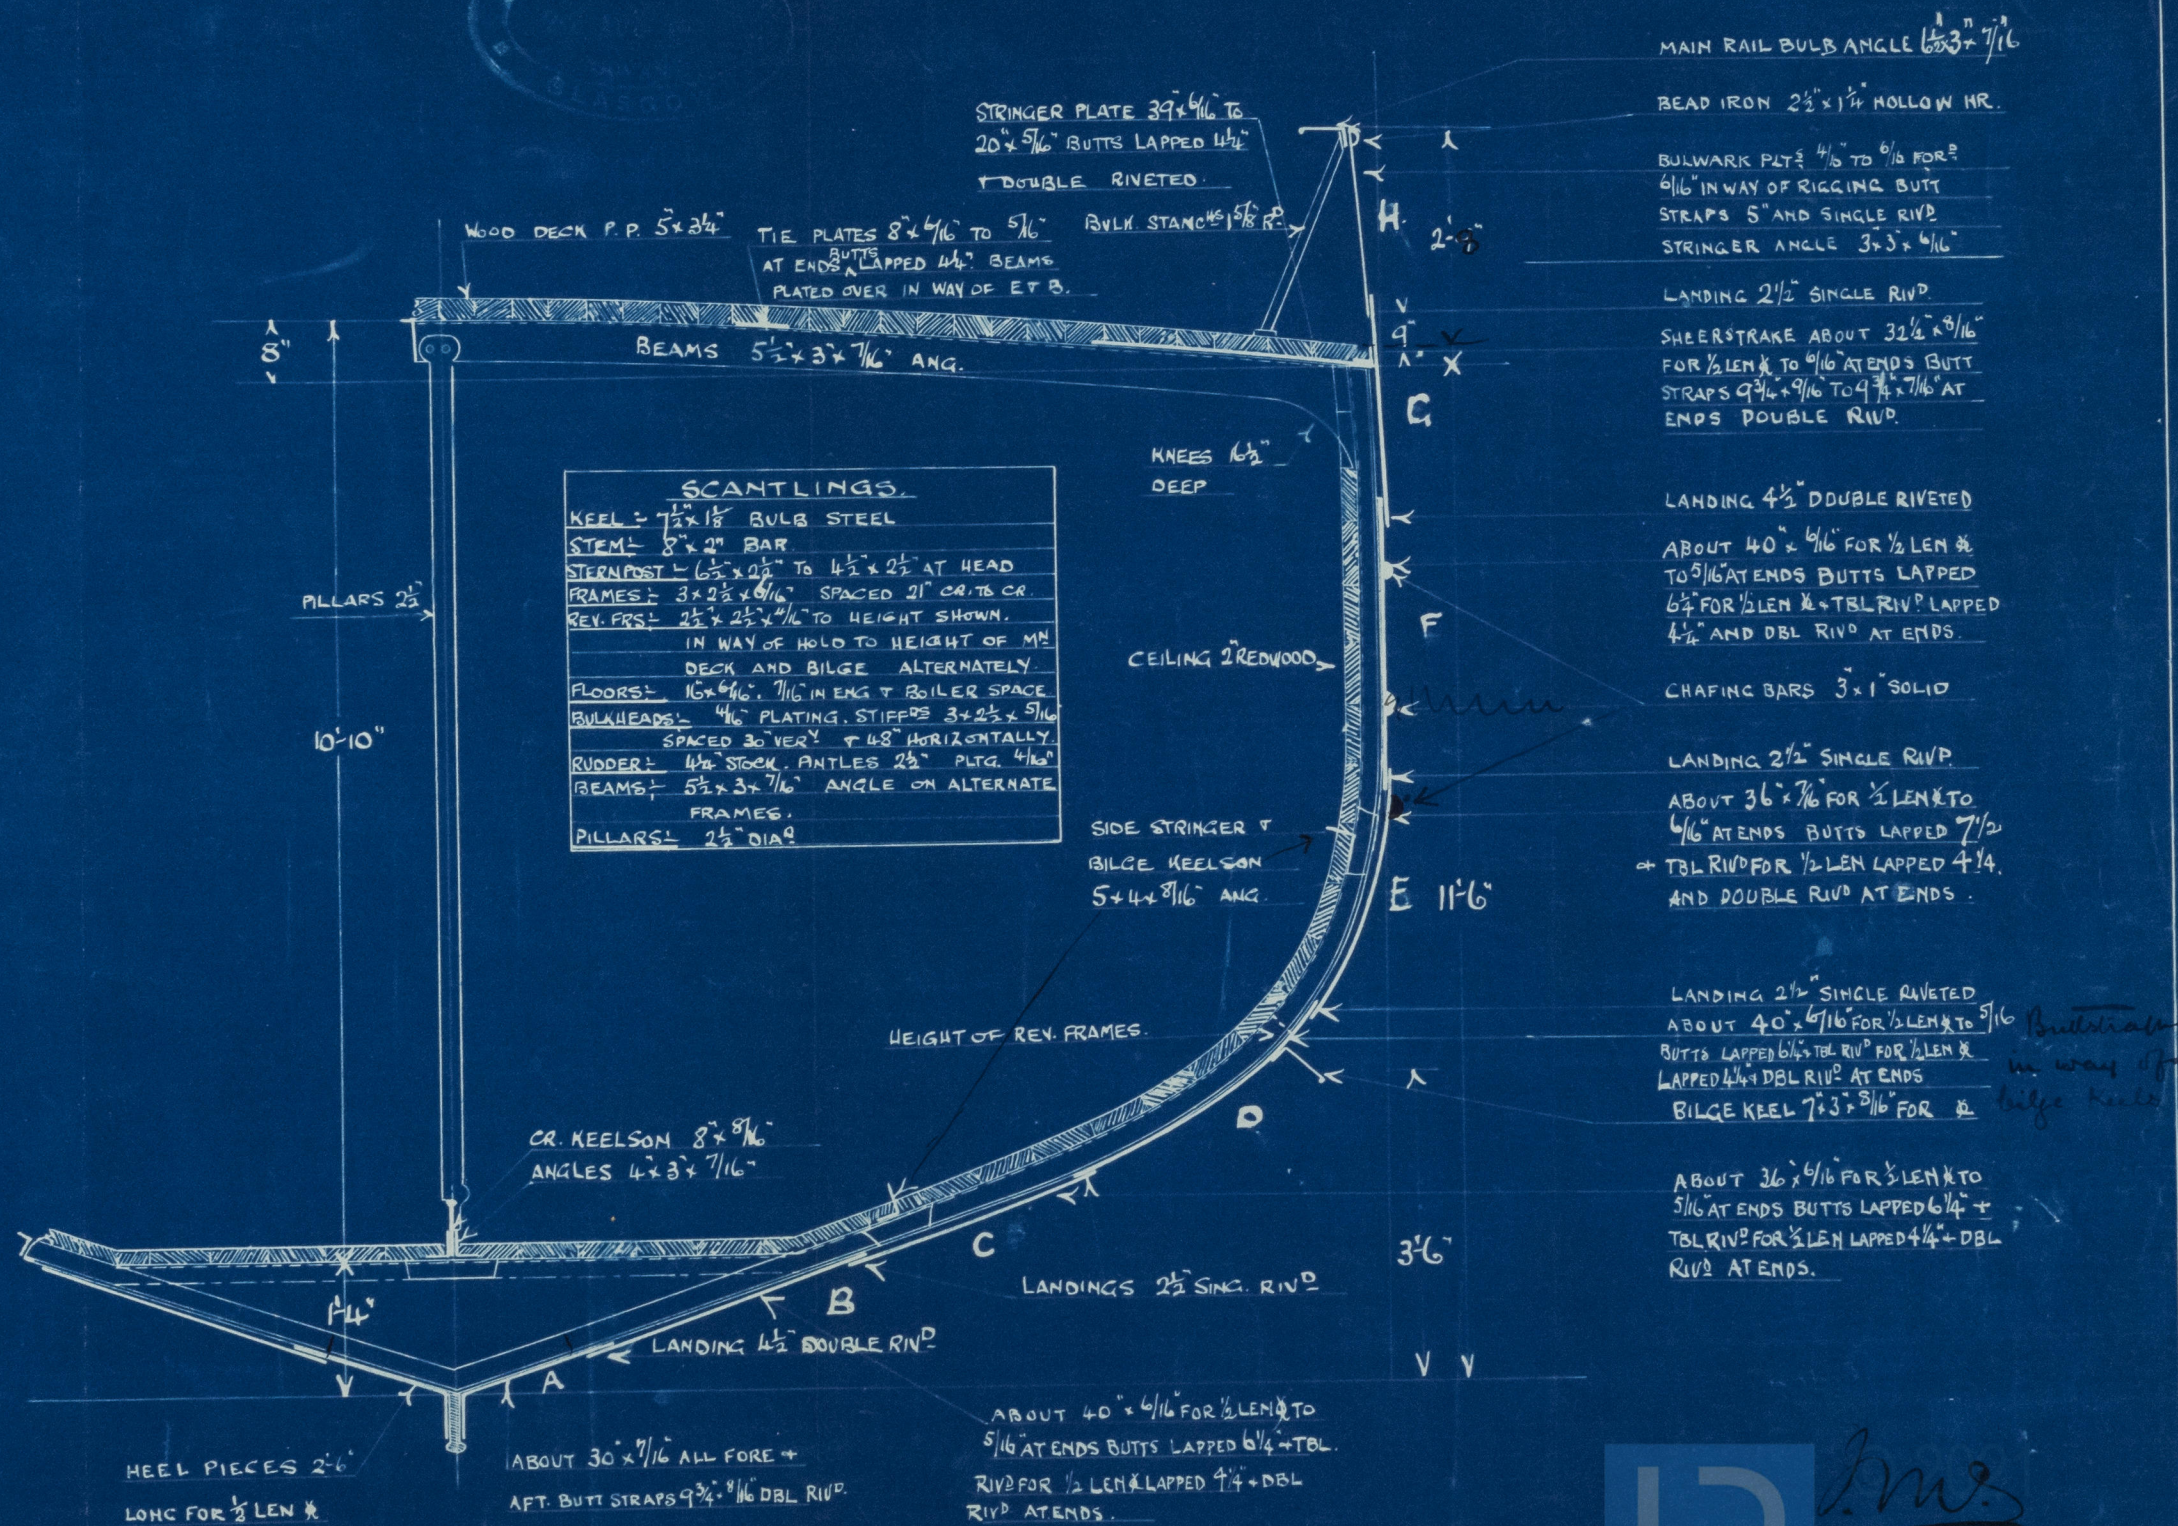

J.M.S.
7/1/03

Inackie T. Thomson
No 282 Elike
Glasgow No 20479



© 2021

Lloyd's Register
Foundation

007116-007128-0107