
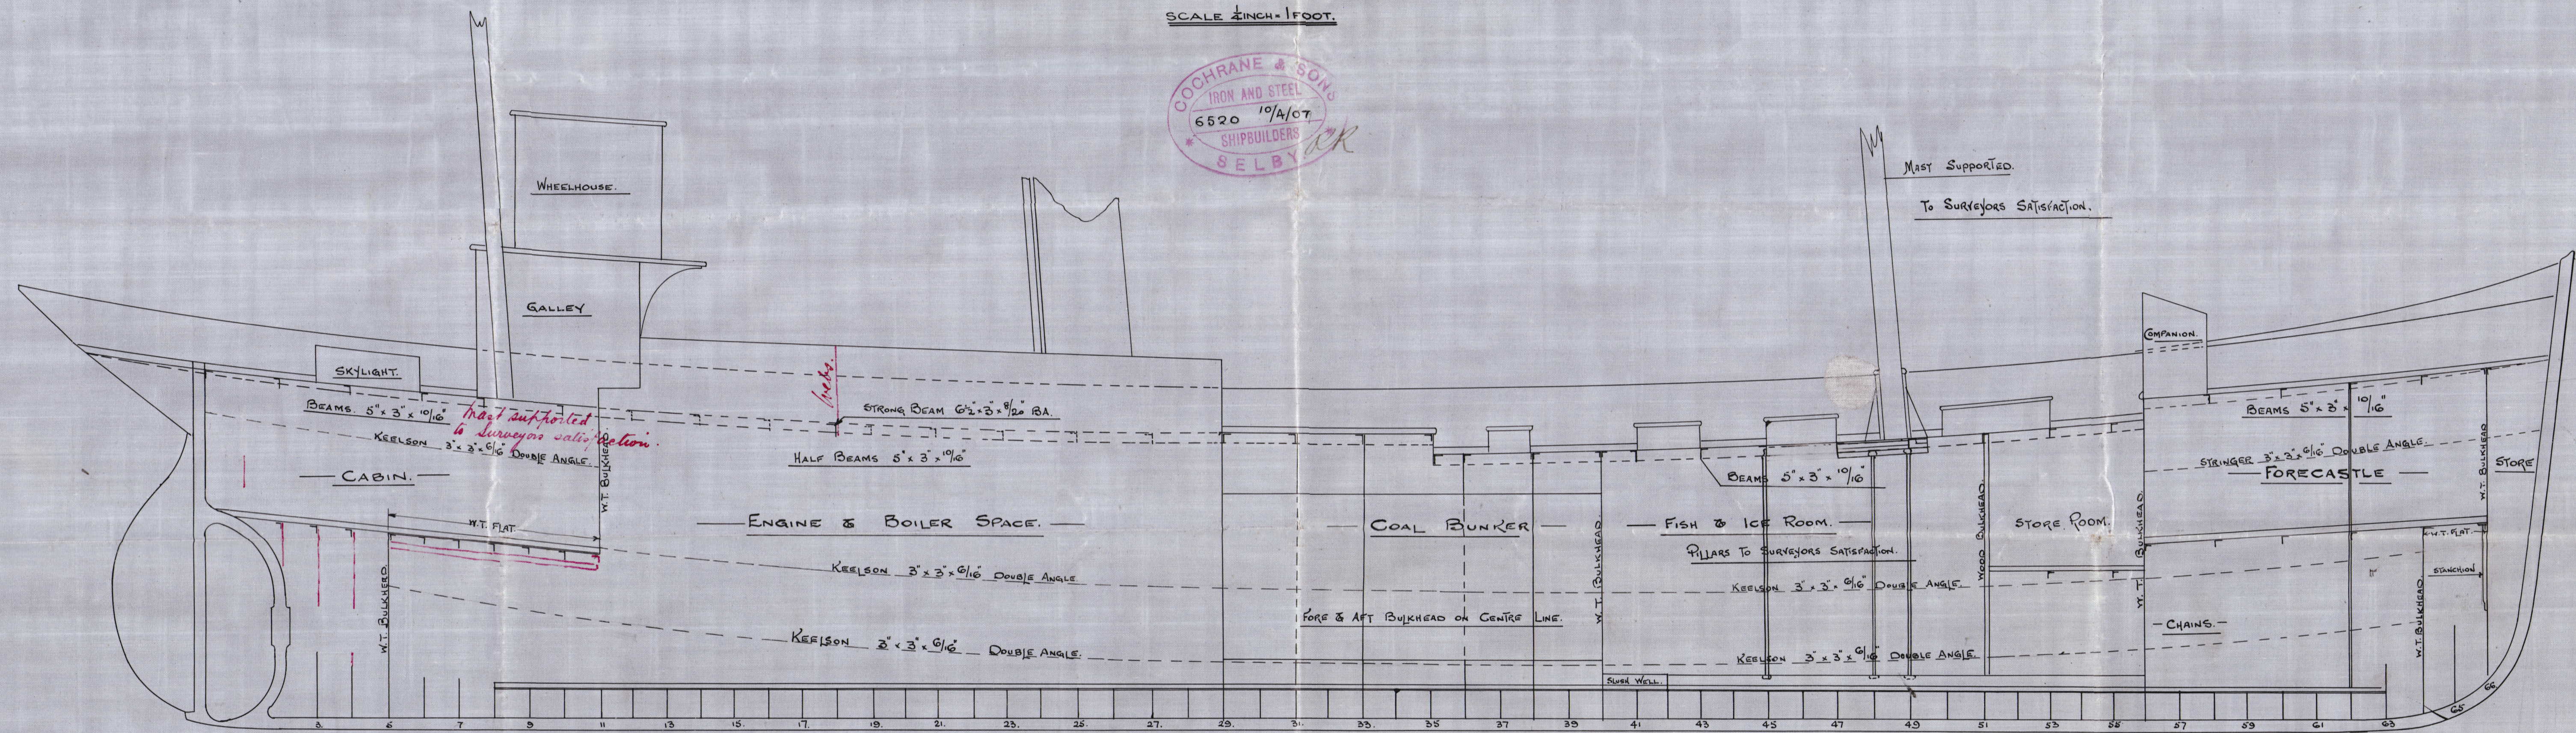


12.4.07.


— PROFILE & DECK PLAN —  
— STEEL SCREW TRAWLERS N<sup>os</sup> 414 AND 415. —

— DIMENSIONS 115'0" x 21'6" x 12'3" MOULDED. —

SCALE 1/4" = 1 FOOT.

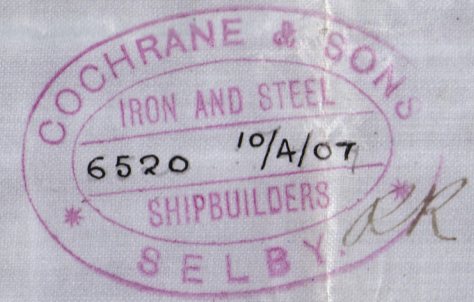

*Pillaring throughout to Surveyors satisfaction.*

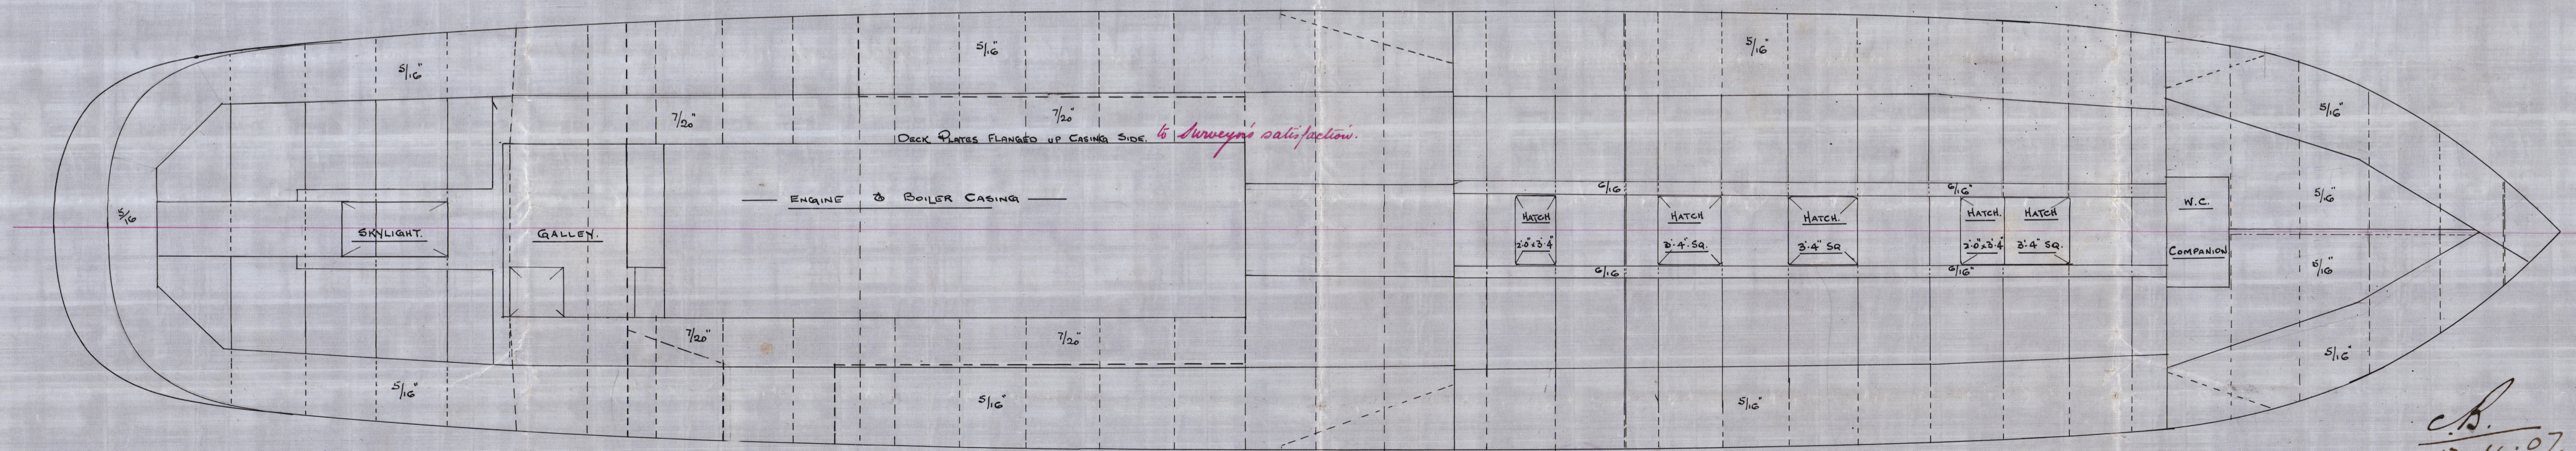

C.B.  
12.4.07.

Profile -

Cochrane & Sons  
Selby

No 414 & 415 -



s/s Marlborough  
Hull Report No. 19545

s/s Rose  
Hull Report No.



© 2021

007115-007128-0235

Lloyd's Register  
Foundation