



SCALE $\frac{3}{4}" = 1 \text{ FOOT.}$

$1\frac{3}{16}$ " HOLES FOR $\frac{3}{4}$ " RIVETS SPACED 5 DIA^s APART.


NUMERAL FOR RUDDER 71-98

SIDE PLATES 28" THICK.

SPEED 10/12 KNOTS

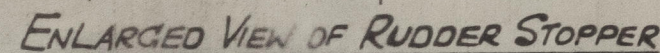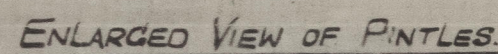

RUDDER TO HEEL OVER TO AN ANGLE OF 45° EXACTLY.

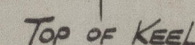



SUBMITTED TO LLOYDS 1915
APPROVED BY LLOYDS 1915

COOK, WELTON & GEMMELL LTD
SHIPBUILDERS
BEVERLEY.

007129-007138-0165

SCALE $\frac{3}{4}" = 1 \text{ FOOT.}$

1 1/16" HOLES FOR 1" RIVETS 5 DIA^s APART, 1 3/4" 2"
FROM INNER EDGE OF POST

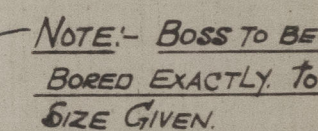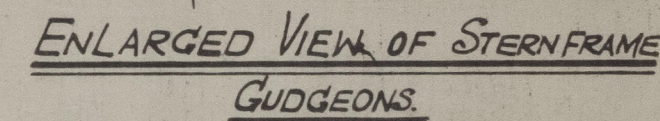

CC.
17.6.15.

N^{OS}₁ 347 & 8.

N^o 347-8

STERN FRAME & RUDDER.

COOK WELTON & GEMMELL



347 ⁵/₁₅ * SARPEDON "HULL R^{ET} N^o 29692.
348 ⁵/₁₅ " JERIA "HULL R^{ET} N^o 29735.

007129-007138-0165



© 2021

Lloyd's Register
Foundation