


17.6.15.

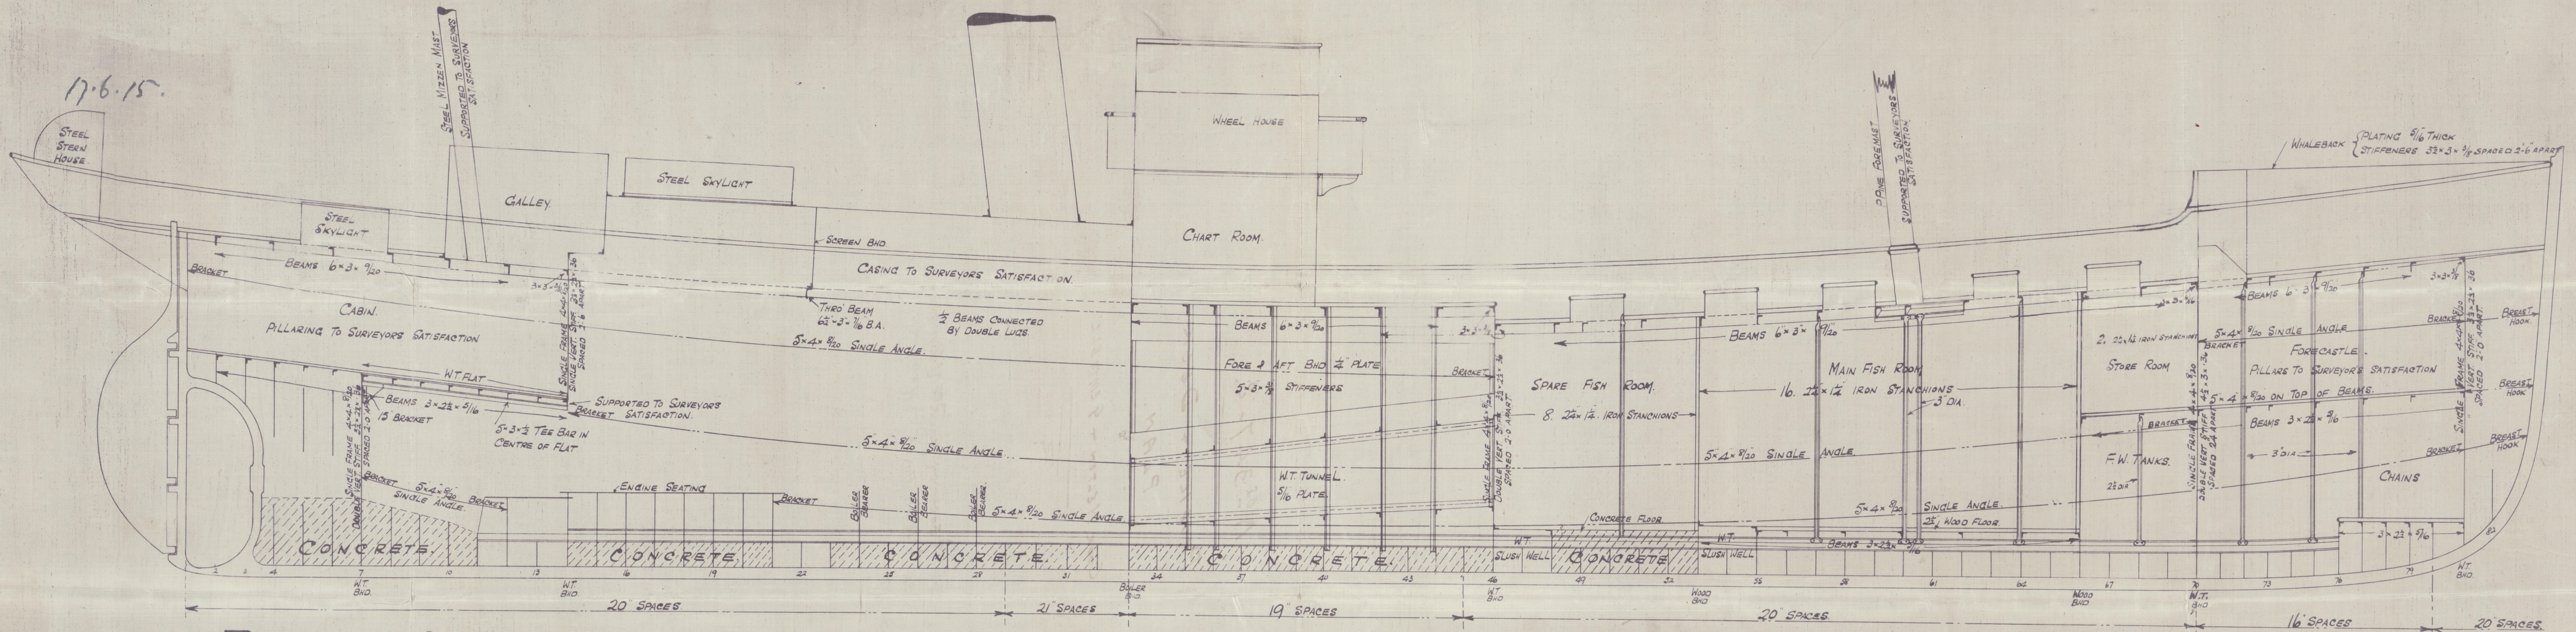


BEAM ARRANGEMENT.

PILLARING THROUGHOUT TO SURVEYORS SATISFACTION.
SCALE 1/4" = 1 FOOT

SUBMITTED TO LLOYDS 1915
APPROVED BY LLOYDS 1915

N^{OS} 347 & 8.

COOK, WELTON & GEMMELL LTD
SHIPBUILDERS
BEVERLEY

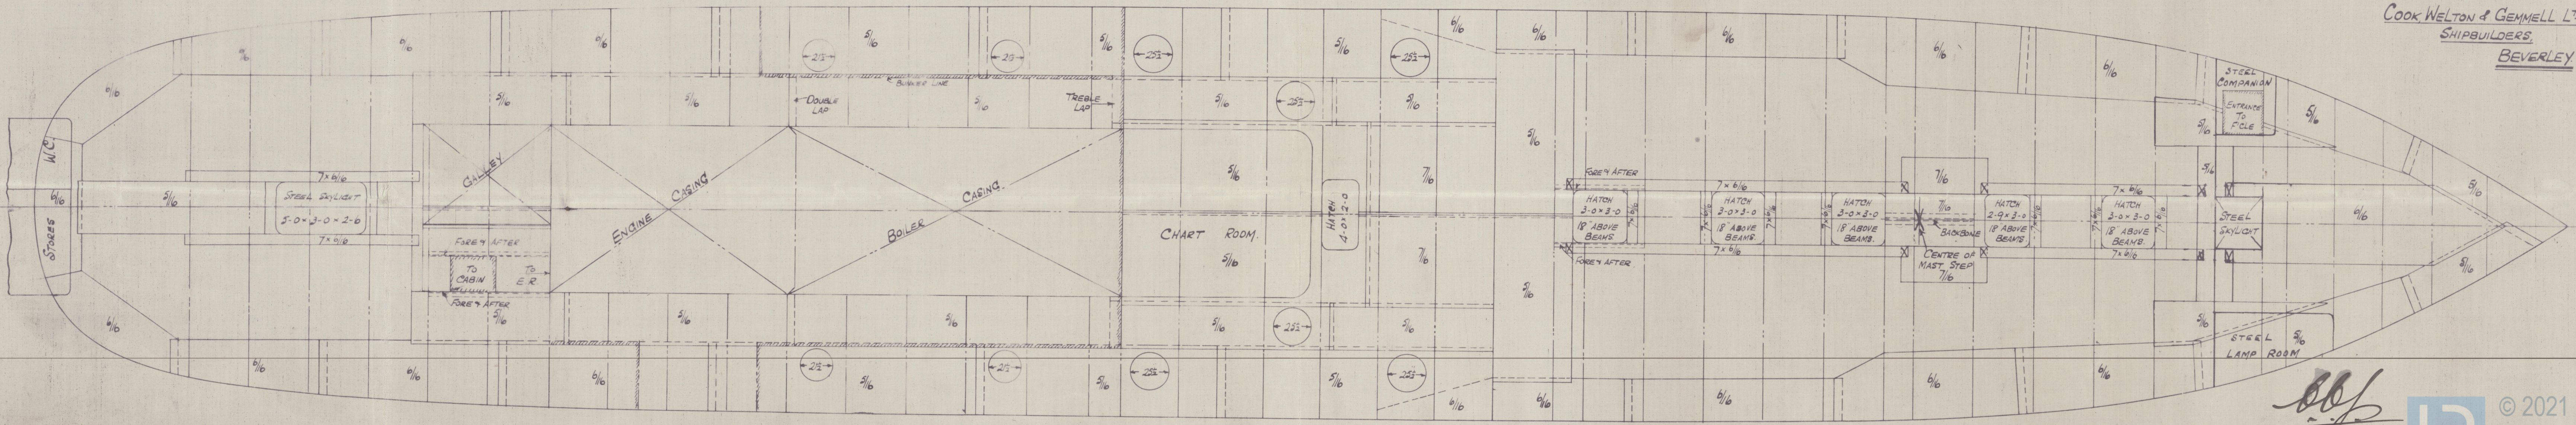

17.6.15.

N^{os} 347-8.

PROFILE + DECK
PLAN.

COOK WELTON + GEMMELL



347) ⁵/₅" SARPEDON "HULL R^{PT} N^o 29692
(348) ⁵/₅" JERIA "HULL R^{PT} N^o 29735.



© 2021

Lloyd's Register
Foundation

007129-007138-0166