
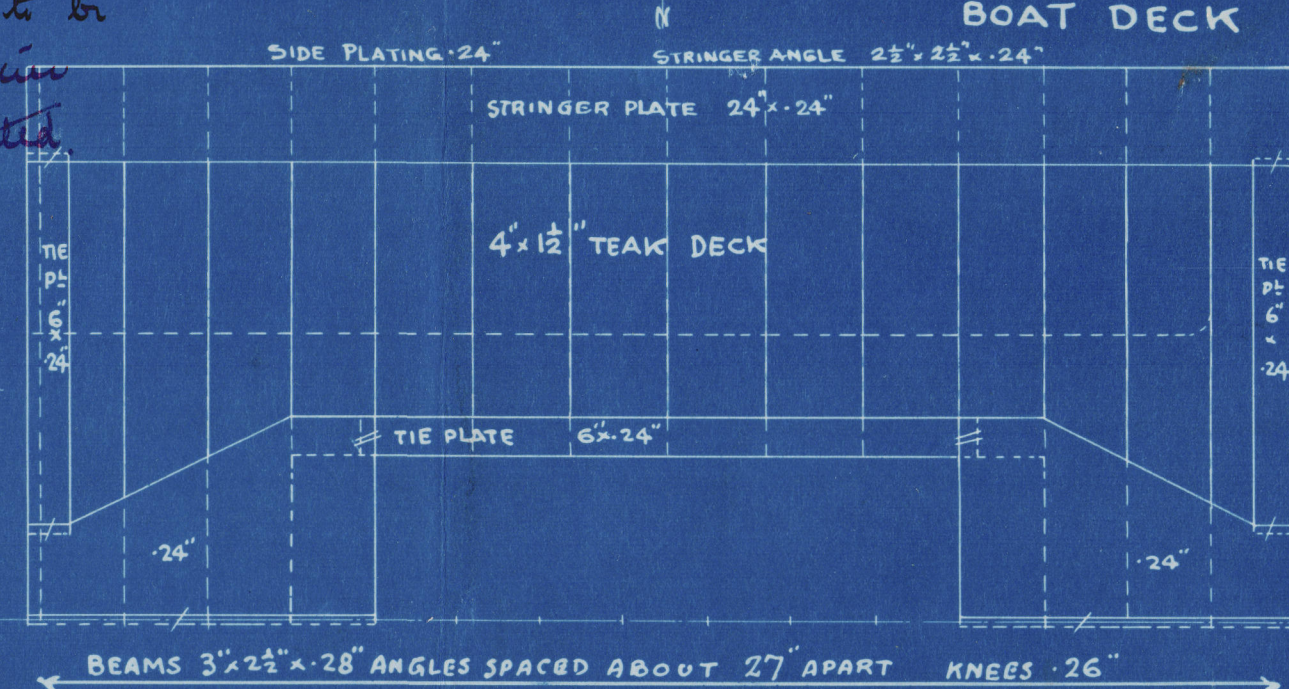


YARD No 691.
PROFILE & DECK





STEEL SINGLE SCREW MOTOR CARGO VESSEL.

DIMS:- 125'0" B.P. x 24'0" M.D. x 8'0" M.D.

SCALE 1/4" = 1 FOOT.

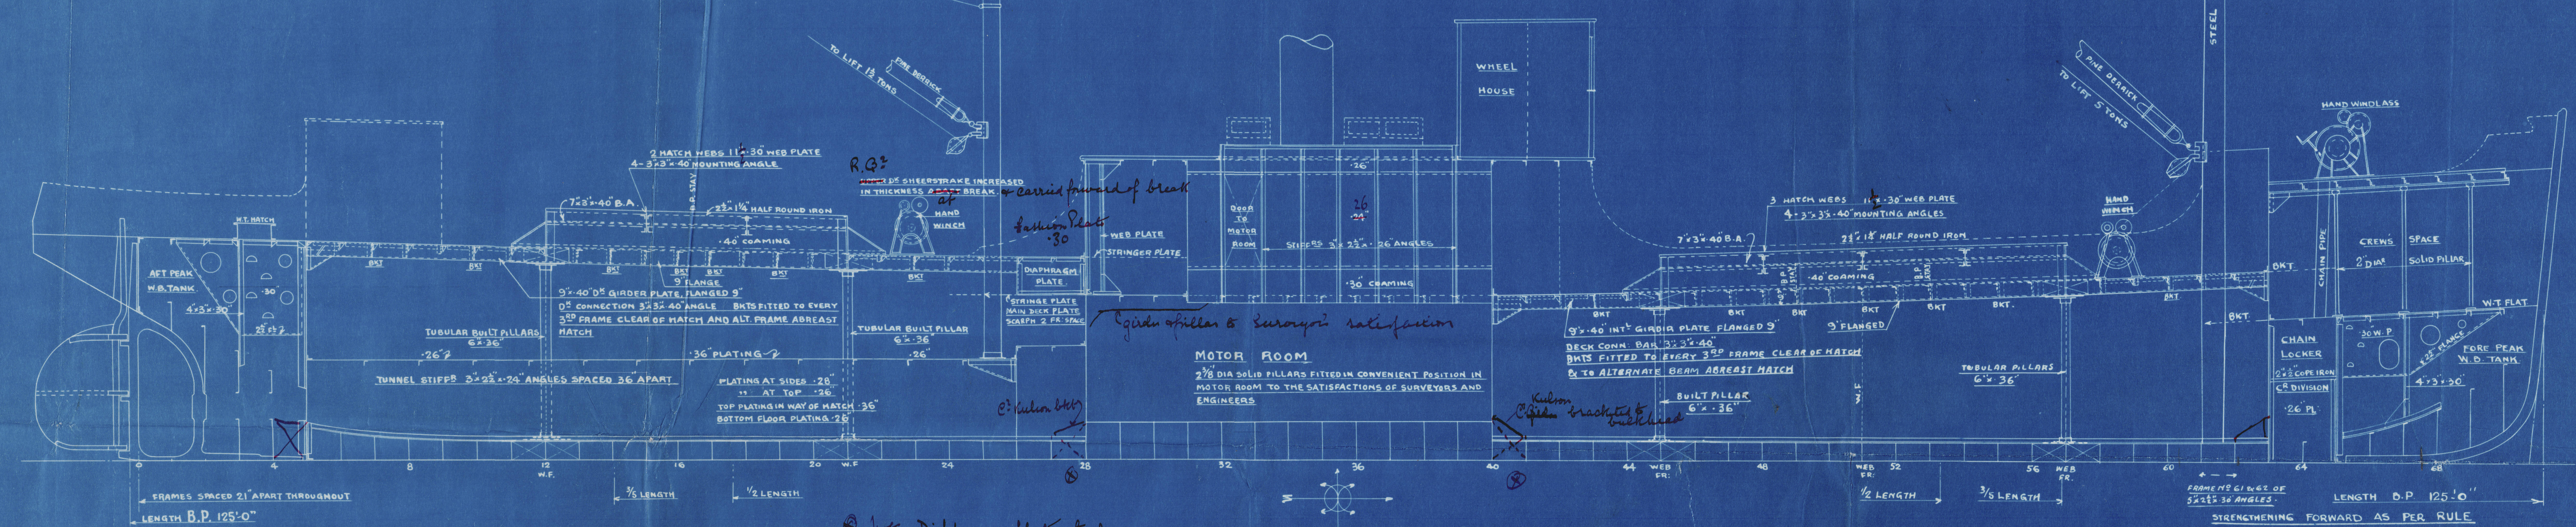

W.T. BULKHEAD PLAN & PILLARS & GIRDERS PLAN
TO BE SUBMITTED FOR APPROVAL

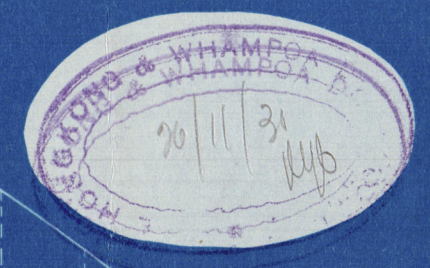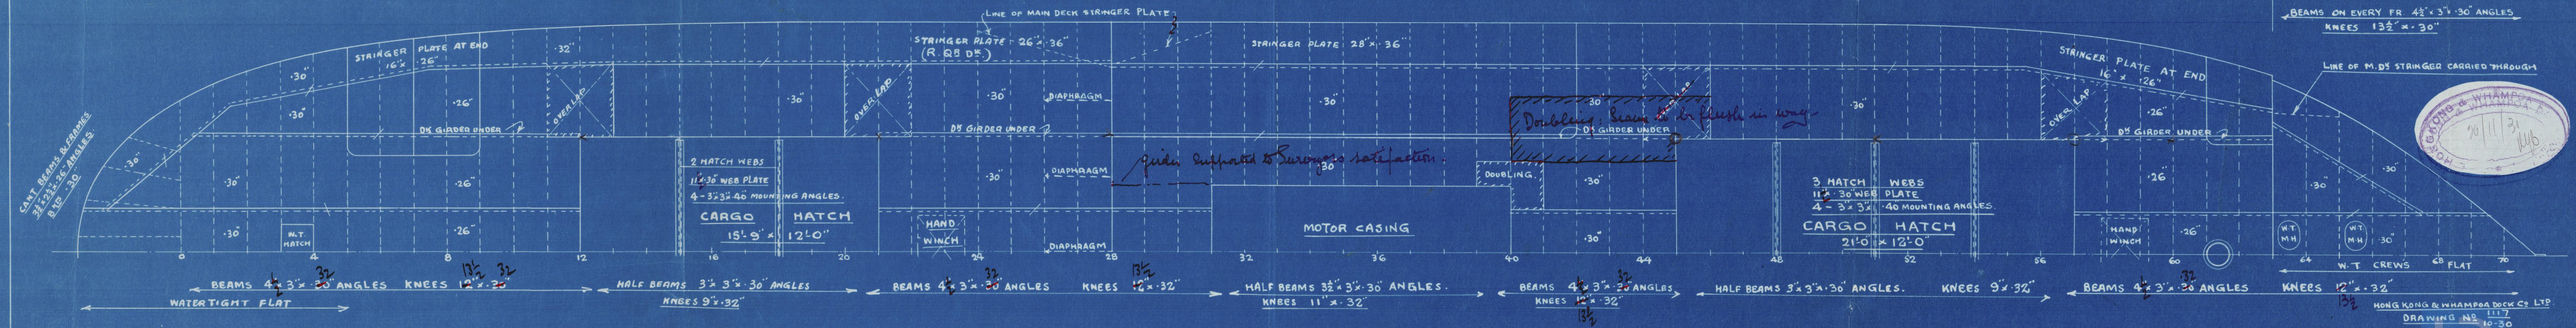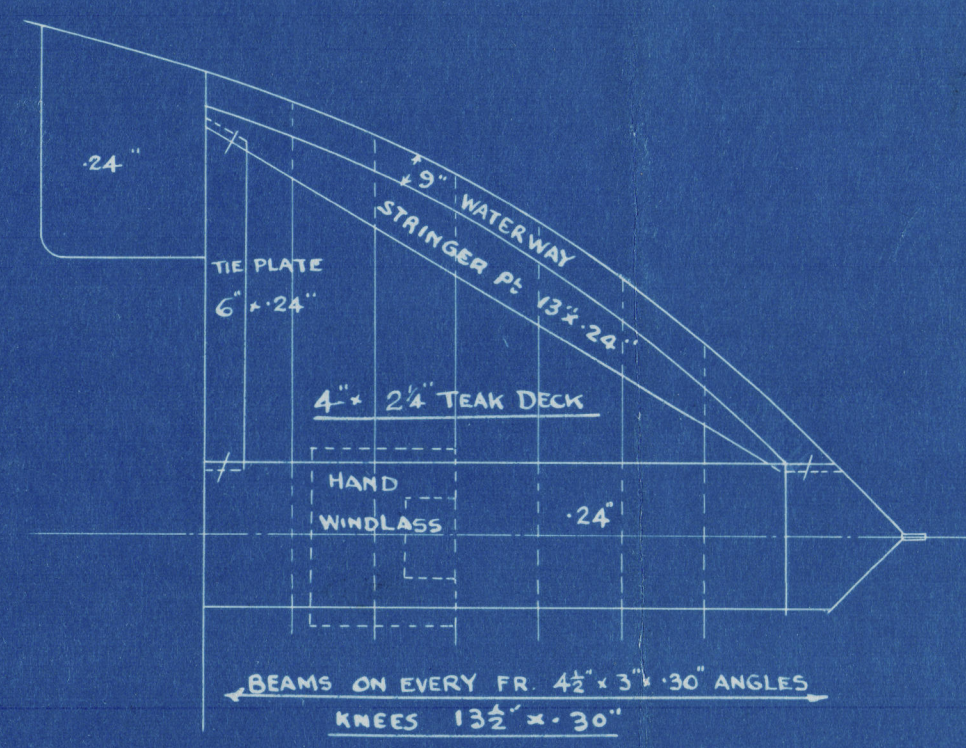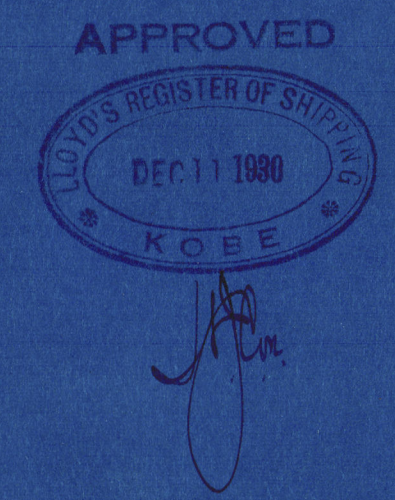

S S MANAPLA H. Kg. 6712.
Prohite + deek

S/S 691.

GEN. BOX N^o 893

Prof. van



© 2020

Lloyd's Register
Foundation

007161-007167-0111