



*May 7<sup>th</sup> 06.*

— N<sup>o</sup> 527. S/S —

AMENDED HEIGHTS OF  
STERN FRAME + RUDDER

— COUPLING —

— SCALE  $\frac{1}{2}$ " = 1 FOOT. —

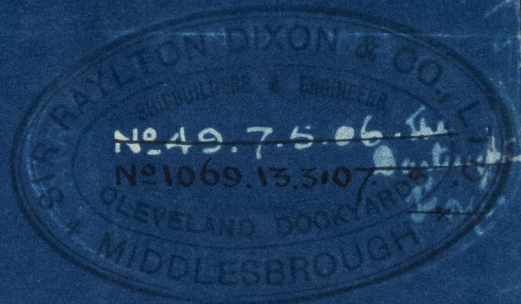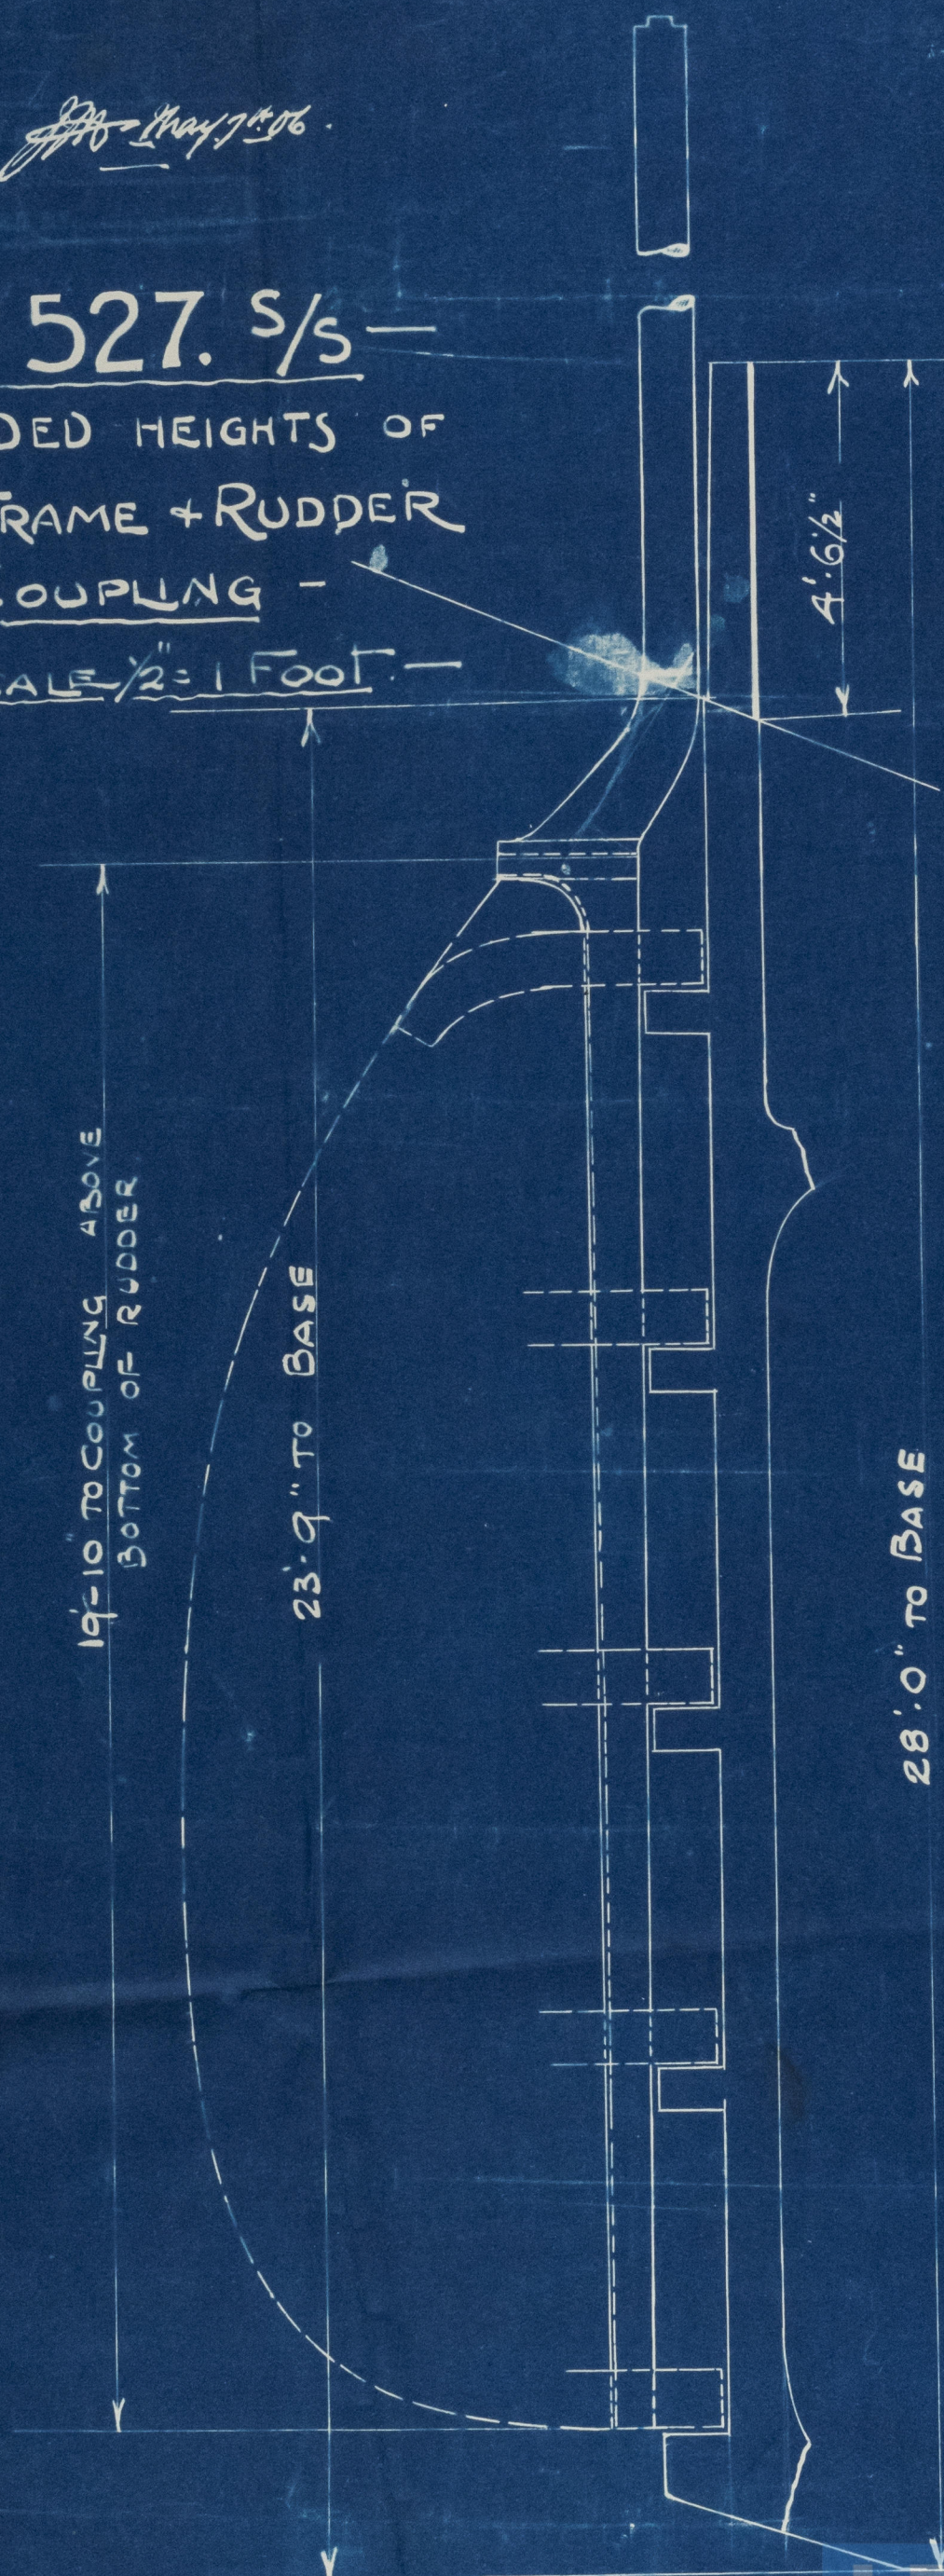

Copyrighted  
Material  
007168-007175-0088.1