



9.2.05

— No 772 —  
— PROFILE & DECK PLAN —  
— SCALE 1/4" = 1 FT. —  
— To CLASS 100A.1 AT LLOYDS. —

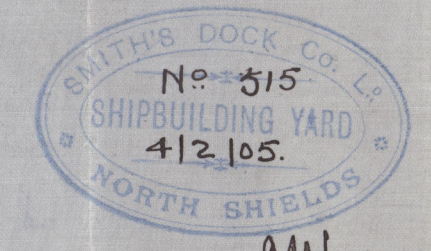

2nd class Dock Co's  
No 772  
PROFILE

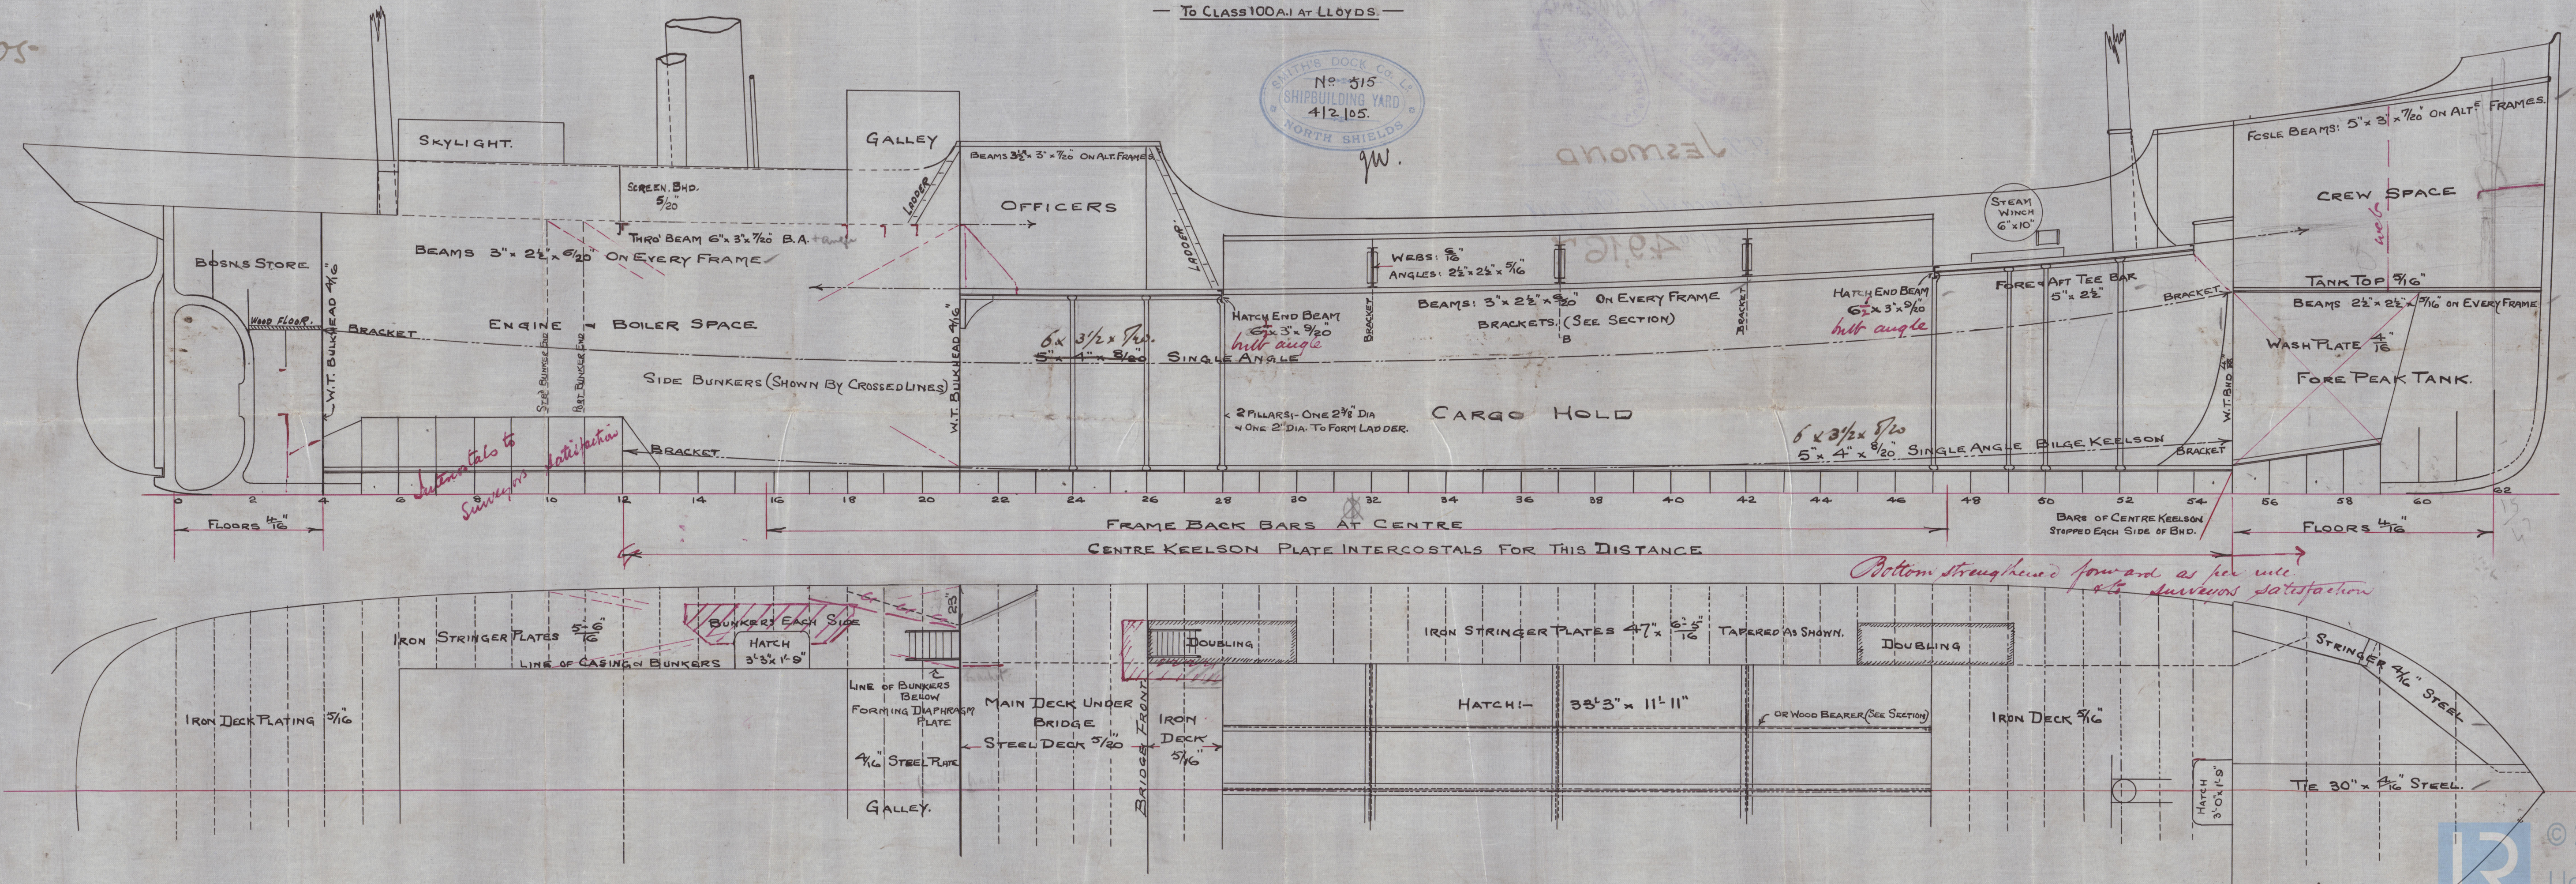

*Instrumentals to  
Surveyors  
Satisfaction*

*Bottom strengthened forward as per rule  
&c. Surveyors satisfaction*

24  
9.6  
11.2

*J. 24/05*



SMITHS DOCK CO LD

Nº 772


PROFILE

*Jesmond*

J. J. **JESMOND**

Newcastle Report

Nº 49,167

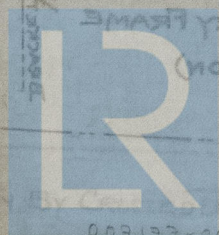

© 2021

Lloyd's Register  
Foundation

009197-00710-000