

S.S. No 772 91H201M

LLOYDS NUMERALS

$\frac{1}{2}$  GIRTH-----18.50.

$\frac{1}{2}$  BEAM-----10.00.

DEPTH-----10.08.

1<sup>ST</sup> NUMBER---38.58 ✓

LENGTH-----110.80.

2<sup>ND</sup> NUMBER 4274.66.

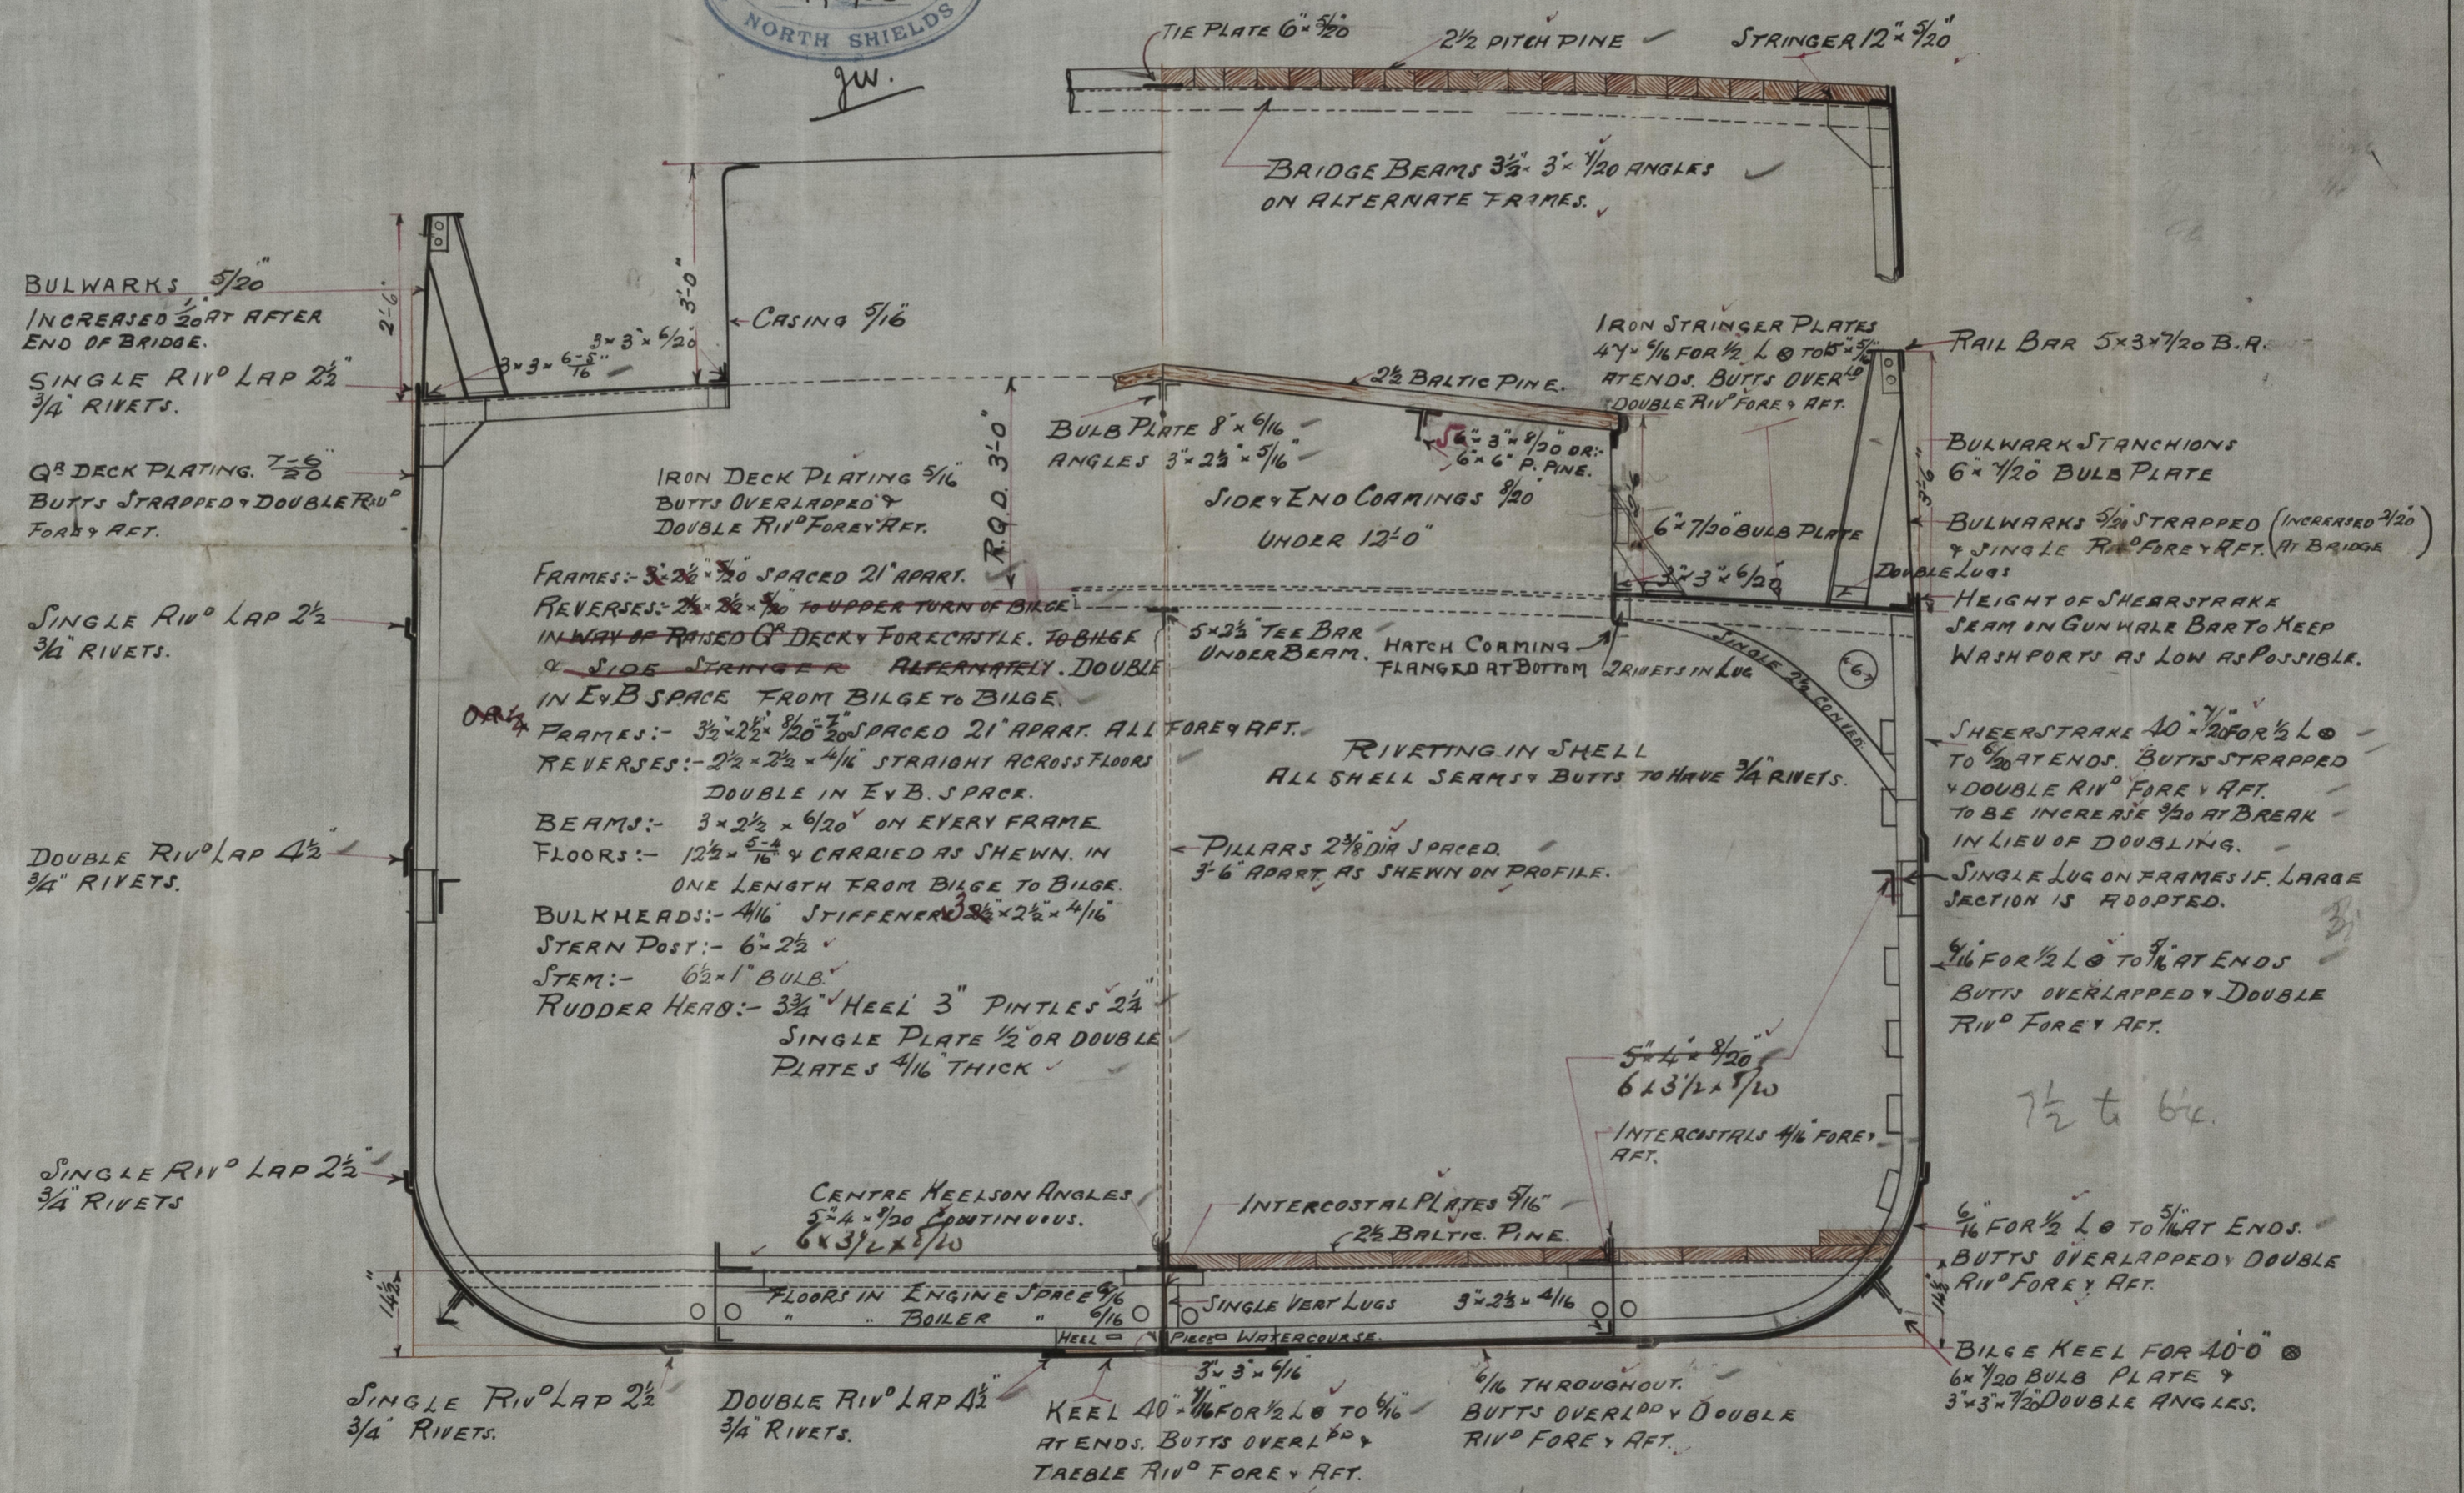
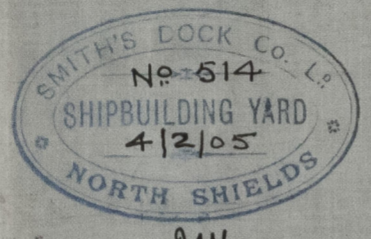
$\frac{1}{D} = 10.99 \checkmark \frac{1}{B} = 5.54. \checkmark$

MIDSHIP SECTION OF A STEEL SCREW STEAMER.  
TO CLASS 100A1 AT LLOYDS

DIMENSIONS.  
 LENGTH B.P.-----112'-0".  
 BREADTH M<sup>LD</sup>-----20'-0".  
 DEPTH M<sup>LD</sup>-----9'-8".

EQUIPMENT NUMBER 4785.

1	BOWER	6 1/4 CWT	(STOCKLESS)
1	"	"	"
1	STREAM	1 3/4"	(EX. STOCK.)
1	KEDGE	3/4"	" "
1	35 FATHOMS	13/16"	STUD LINK CHAIN CABLE
75	"	3"	MANILLA
90	"	4"	"
75	"	2 1/2"	WIRE
1	30	3"	FLEXIBLE STEEL HAWSER.


$$\frac{8\frac{1}{2} - 7\frac{1}{2}}{20}$$

SMITHS DOCK CO. L<sup>D</sup>.

N<sup>o</sup> 772

# MIDSHIP SECTION

Tesmond

hwc 49167

20Y011A00

24012

0-5 ENGLISH

0-054-47-9

8-6-57

15 FEB 1956

ON ALTERNATE FRAMES

Lloyd's Register  
Foundation

007173-007190-0020