

N^{os} 348 to 351

OF 4

TO CLASS 100A1 LLOYDS

DIMENSIONS - 120'-0 BP x 22'-0 EXT x 12'-6 MLD.


SCALE $\frac{1}{2}'' = 1 \text{ FOOT.}$

1 ANCHOR	✓	6 $\frac{1}{2}$ " STOCKLESS	✓
1 "	✓	6" "	✓
1 "	✓	2 $\frac{1}{2}$ EX STOCK.	✓
50 FATHOMS	✓	1" STUD LINK CABLE	✓
60 "	✓	6 HAWSER	✓
60 "	✓	4 $\frac{1}{2}$ WARP	✓

<u>$\frac{1}{2}$ BEAM</u>	10.93 ✓
<u>DEPTH</u>	12.96 ✓
<u>$\frac{1}{2}$ GIRTH</u>	19.92 ✓
<u>1ST NUMBER</u>	43.81 ✓
<u>LENGTH</u>	118.87 ✓
<u>2ND NUMBER</u>	5207.69 ✓

$$\frac{L}{B} = 5.44 \quad \frac{L}{D} = 9.17$$

PRINT N° 94

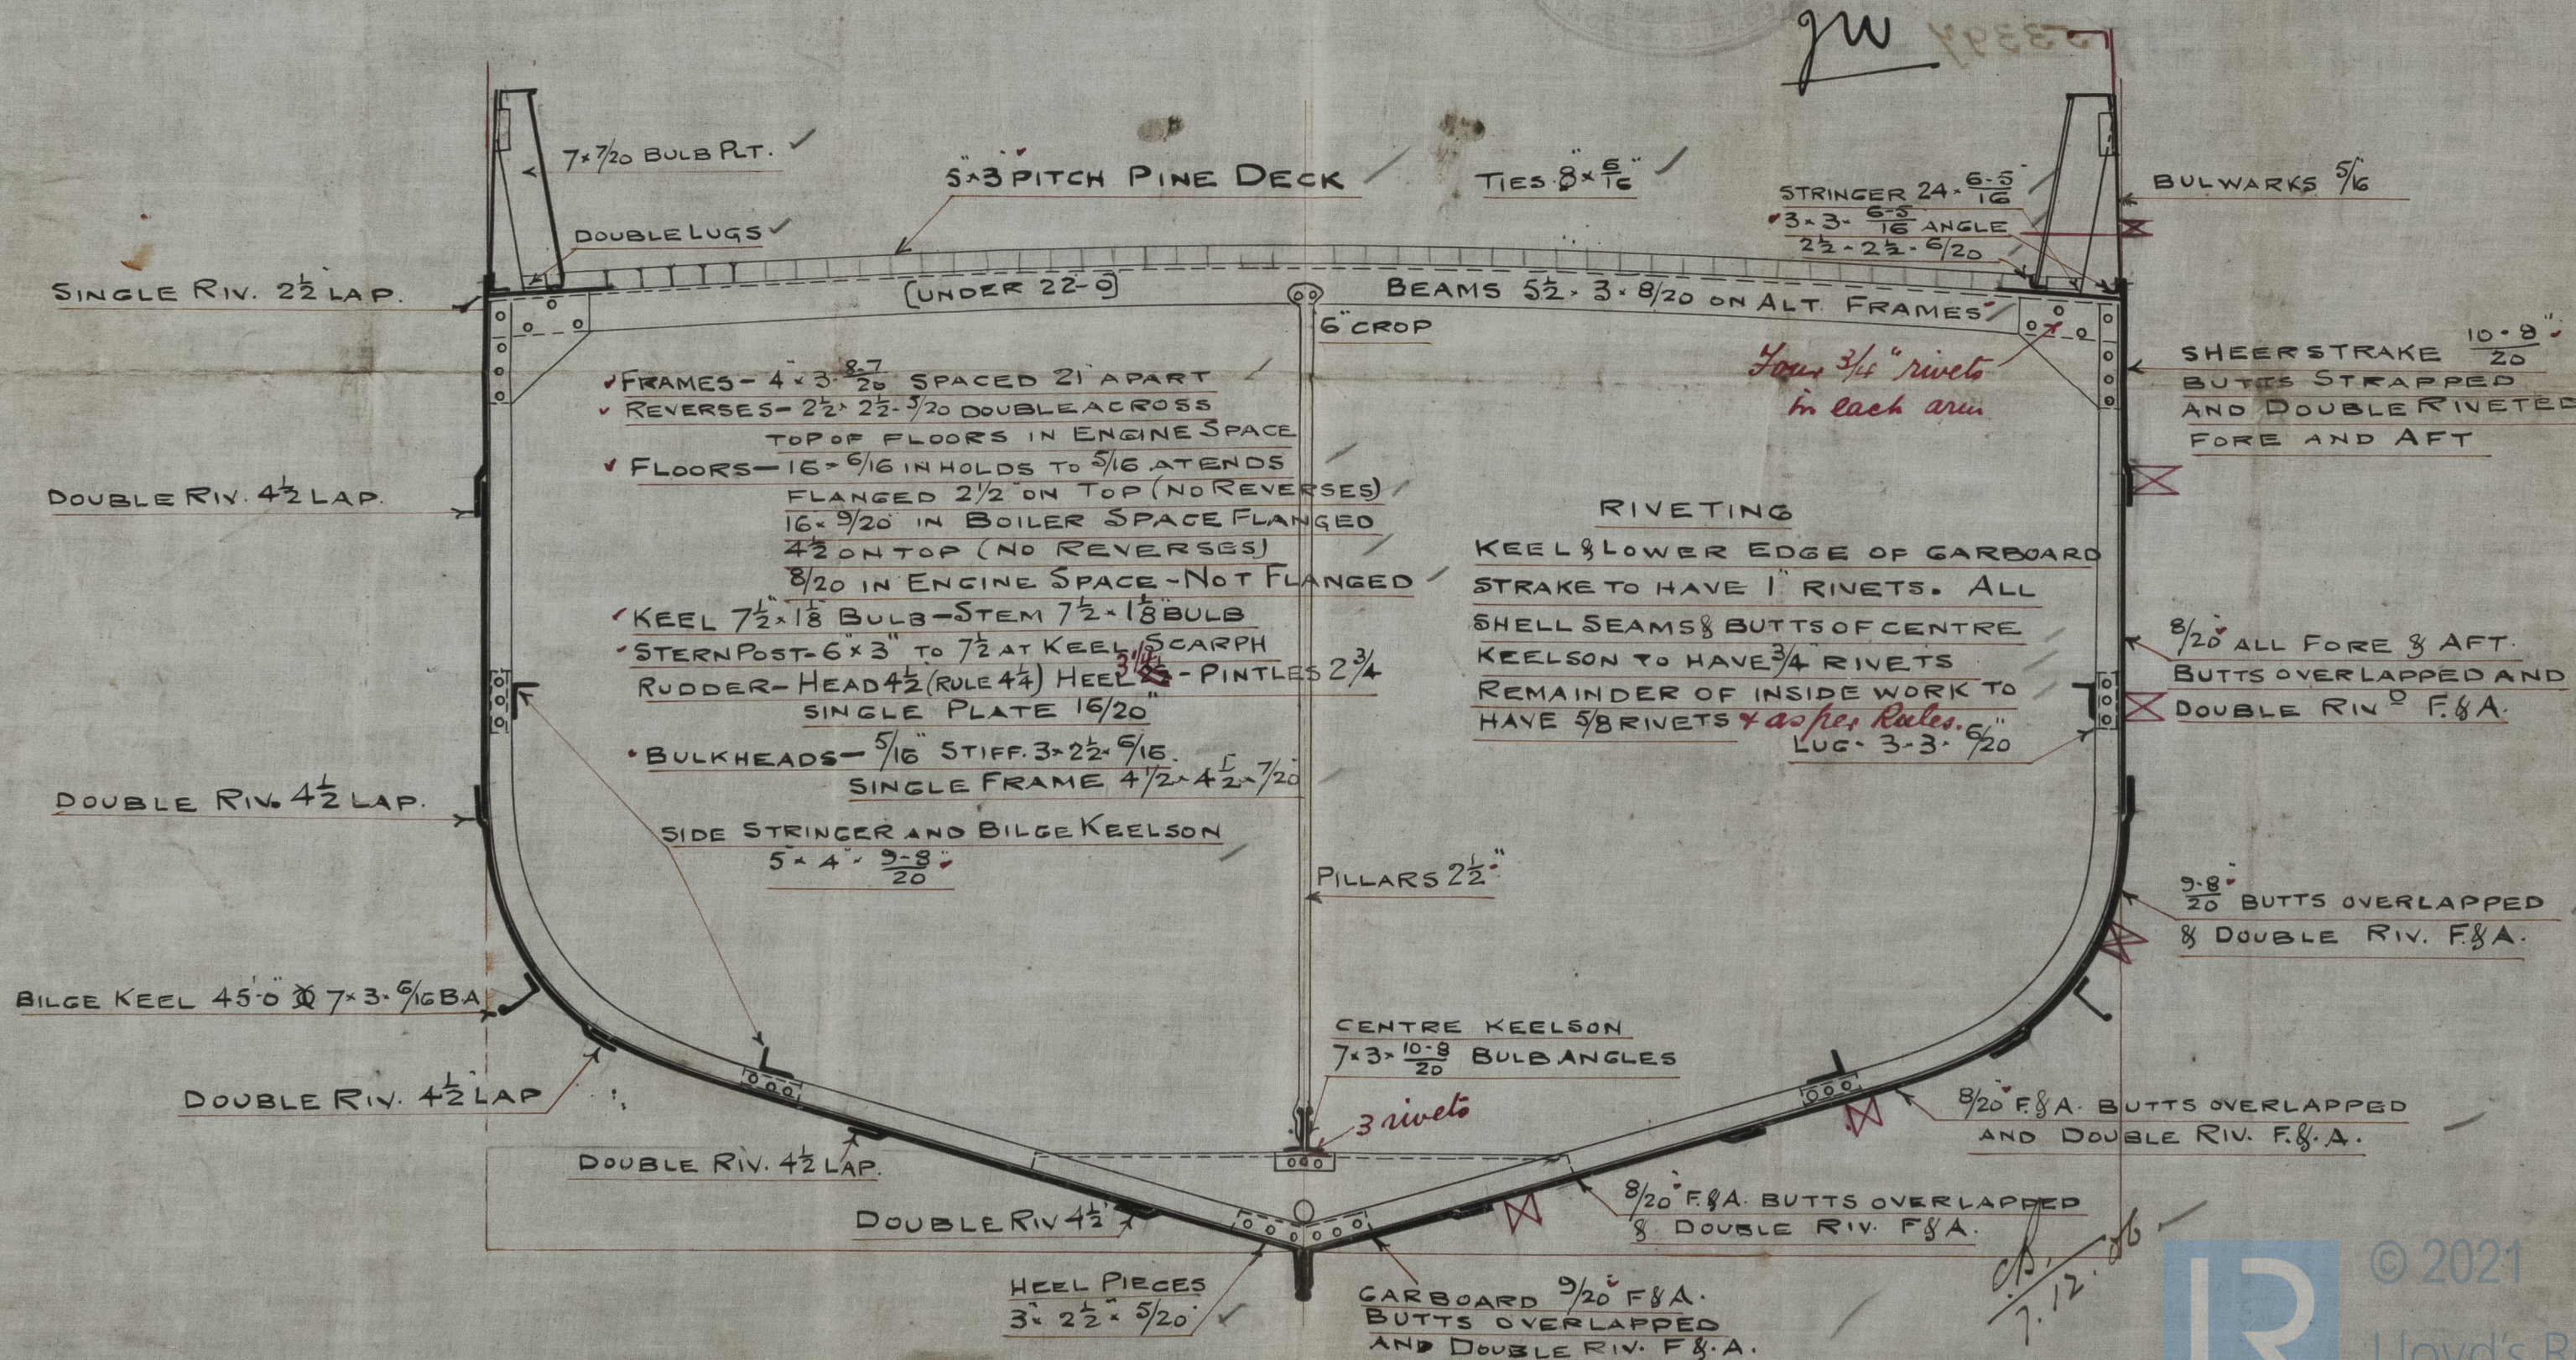

SMITHS DOCK CO L^d
Nos 348, 49, 50 & 51
MIDSHIP SECTION.

No 348 "Owrich Castle"

No 349 "Isaac Walton"

No 350 "Clupe Castle"

No 351 "Cardiff Castle"

J. J. Isaac Walton

Prosser's Report

No 53394



© 2021

Lloyd's Register
Foundation

007177-007190-0213