

007177-007190-0224


SMITHS DOCK CO^{LD}
 Nos 348, 49, 50 & 51
 PROFILE

- N^o 348 "Oswich Castle"
- " 349 "Gaah Walton"
- " 350 "Clyne Castle"
- " 351 "Cardiff Castle"

J. P. Isaac & Fulton

Newcastle Report

3397

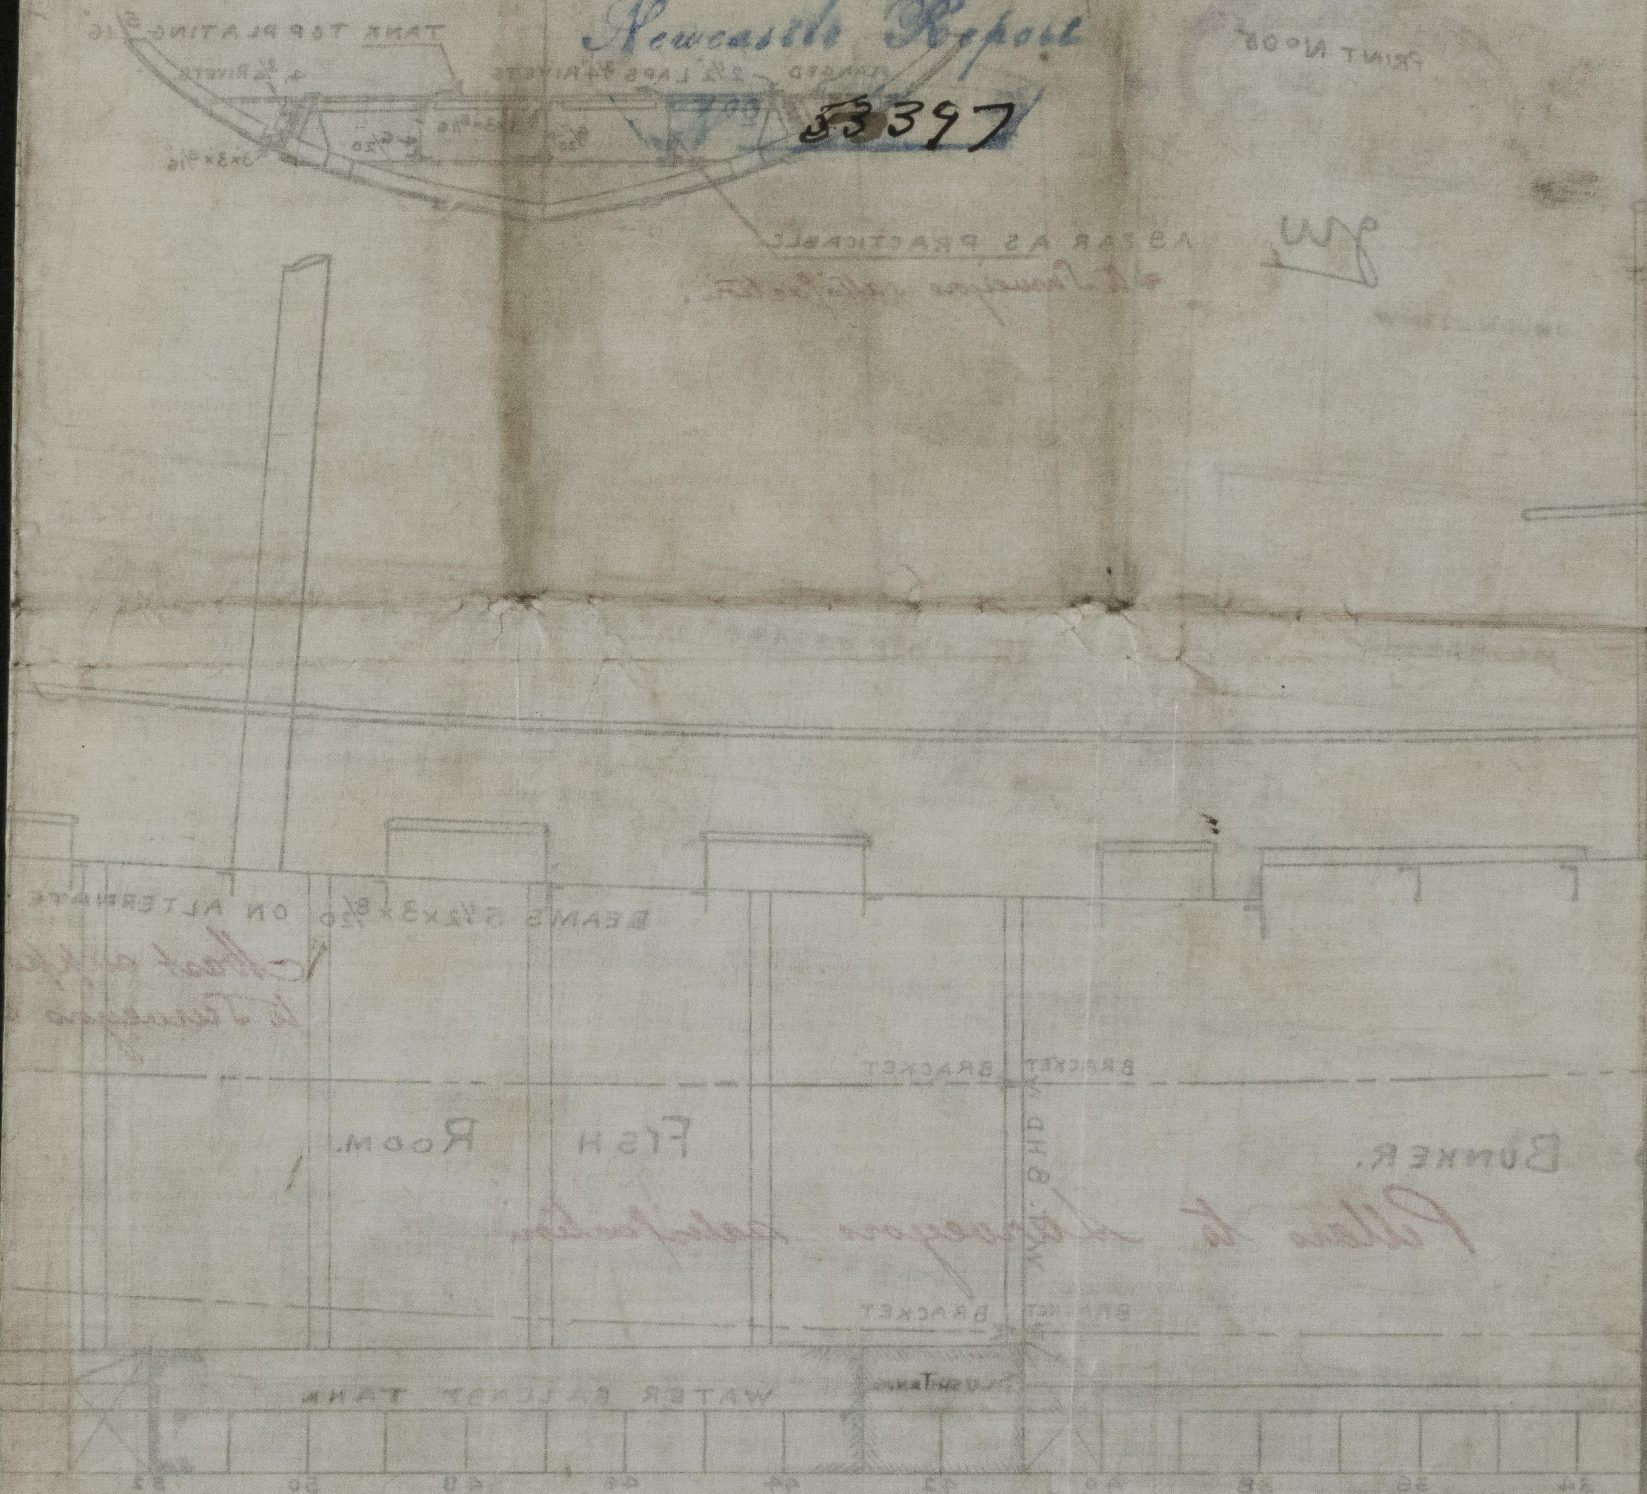




© 2021

Lloyd's Register
 Foundation