

5-12-10

1813

Messrs Lloyd's Surveyors
Hull

27/11 RK

MIDSHIP SECTION

STEEL SCREW TRAWLERS

N^{OS}. 485-6

DIM^S. — 125'-0" B.P. x 22'-0" EX. x 13'-0" MLD.

SCALE 1/2" = 1 FOOT.

PLAN No. 486
FOR ENCLOSURE TO
Messrs Lloyd's Surveyors
Hull FROM
COCHRANE & SONS,
SHIPBUILDERS, SELBY.
DATE 7/7/11 RK

TO CLASS 100.A.1. FOR FISHING PURPOSES. DECK PLATED OVER
IN WAY OF MACHINERY SPACE. ENGINE & BOILER CASING
AS PREVIOUSLY APPROVED.

Midship Section
Cochrane & Sons


324-284-100
3" x 1/2" HOLLOW BEAD
BULWARKS 5/16" &
7/16" IN WAY OF GALLONS

SHEERSTAKE 33" x 3/16" & TO
TAPER TO 3/16" FOR 0" & 3/16" AFT.

3/20" F. & A.

3/20" - 3/20"

ROLLING CHOCKS 55'-0" AMIDSHIPS
7" x 3" x 3/20" SINGLE BULB ANGLE

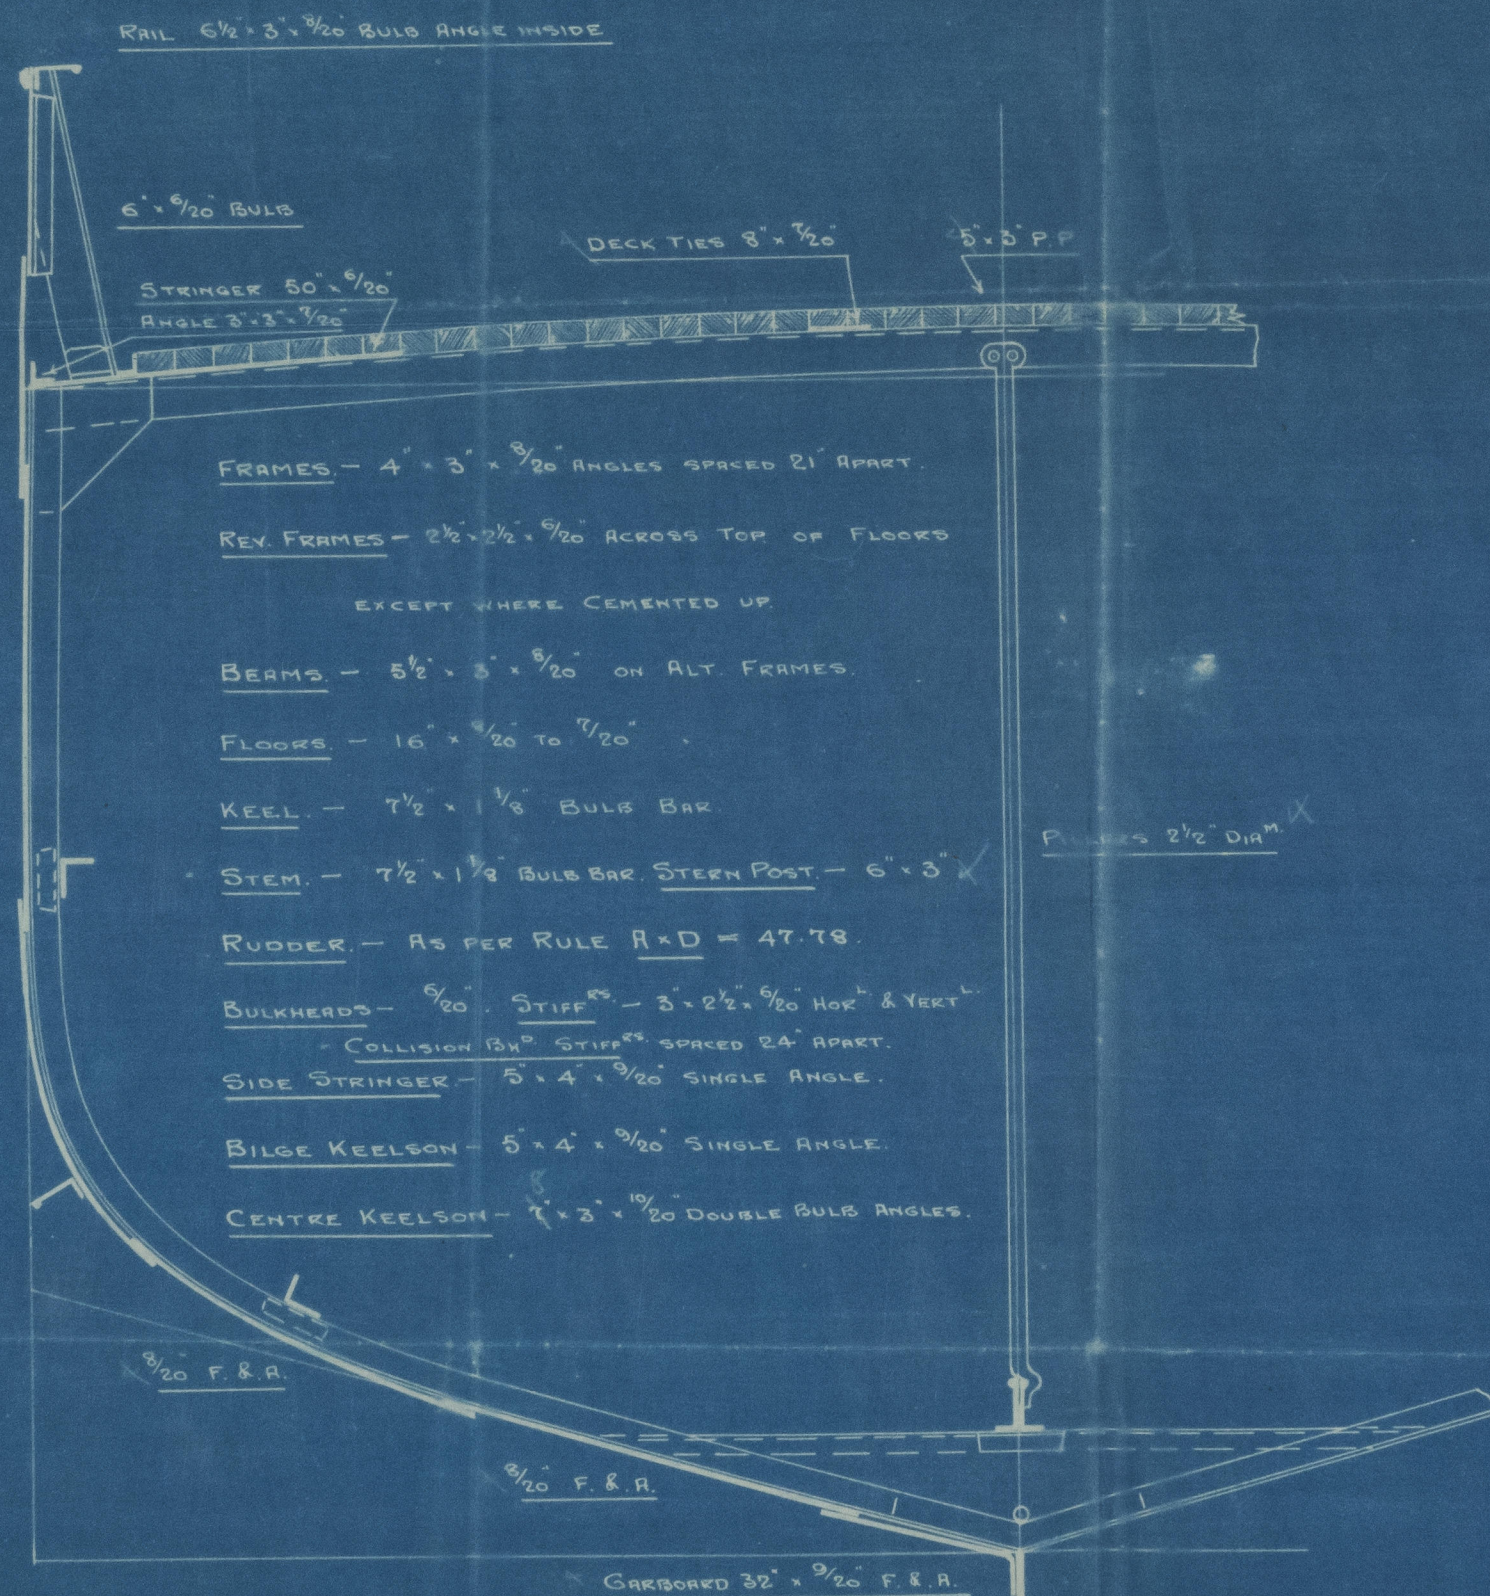

NUMERALS

B + D = 34.87
L x (B + D) = 4358.7

PROPORTIONS

D/B = 9.6
B/L = 5.7

EQUIPMENT

1 ST BOWER ANCHOR	5 1/2" CWTs. EX STOCK
2 ND "	5 "
KEDGE ANCHOR	2 3/4 "
100 FATHOMS	1 1/2" CABLE
50 "	6" HAWSER.
50 "	4 1/2" WARP

RIVETING

BUTTS OF SHELL PLATING LAPPED & DOUBLE RIVETED EXCEPT GARBORD
& SHEERSTAKE WHICH ARE TO BE STRAPPED & DOUBLE RIVETED.
LANDING EDGES DOUBLE RIVETED, EXCEPT TOP EDGE OF SHEERSTAKE
WHICH IS TO BE SINGLE RIVETED. BUTTS OF STRINGER & TIE PLATES
OVERLAPPED & DOUBLE RIVETED.

Butts of shell plating to be treble riveted
where strakes are over 54" in width

C.F.
5-12-10.

Cochrane & Sons

N^{os} 485, & 486.

Duplicate.

Midship Section.

s/s Xylopaia

Hull Rpt. No 24041

007191-007205-0237



© 2020

Lloyd's Register
Foundation