

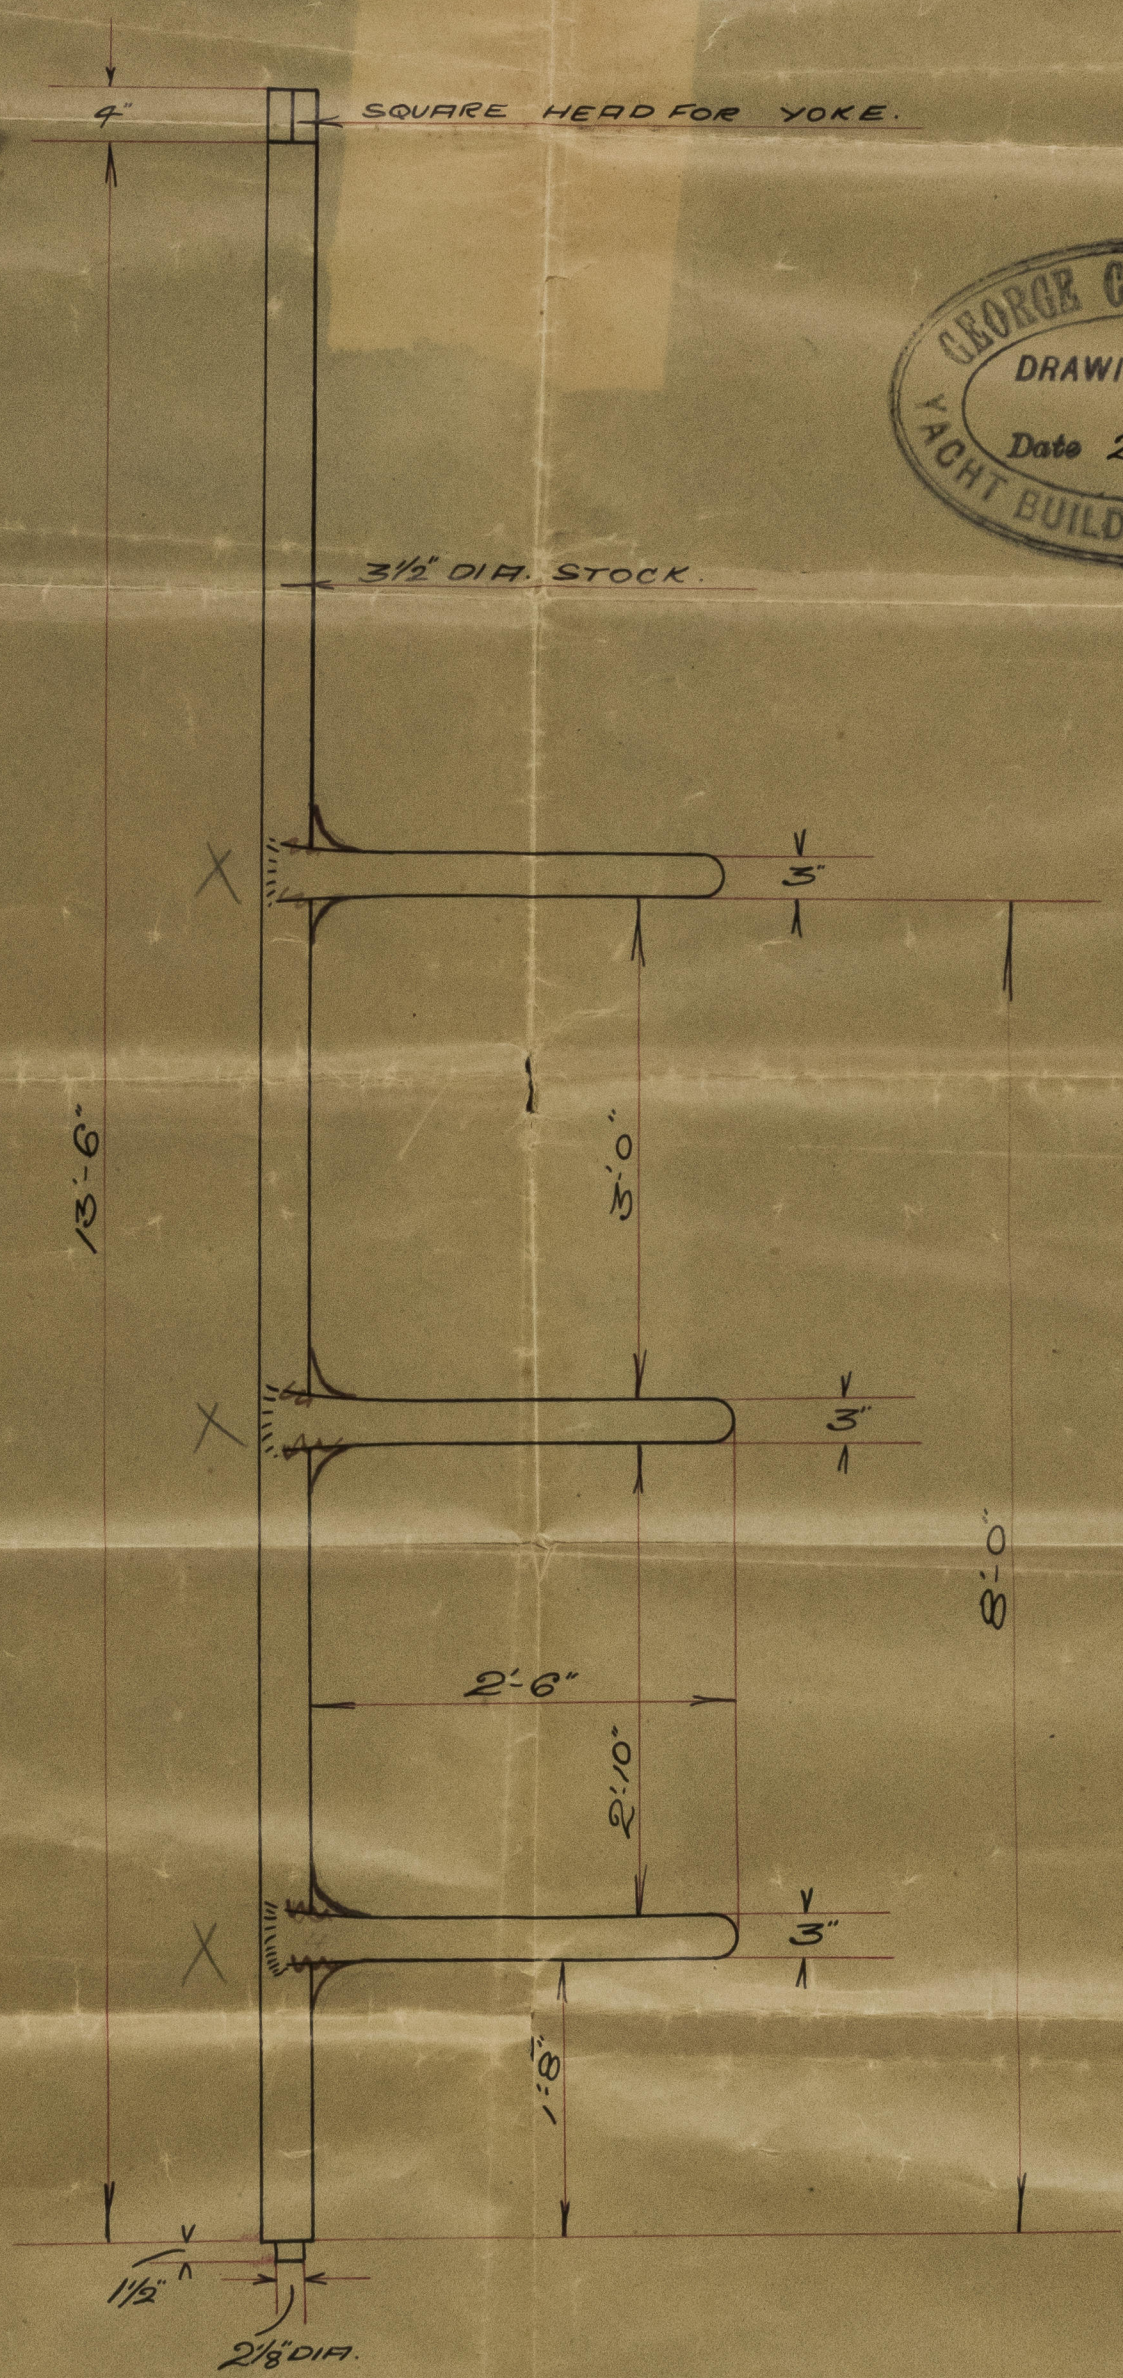


10/12/18

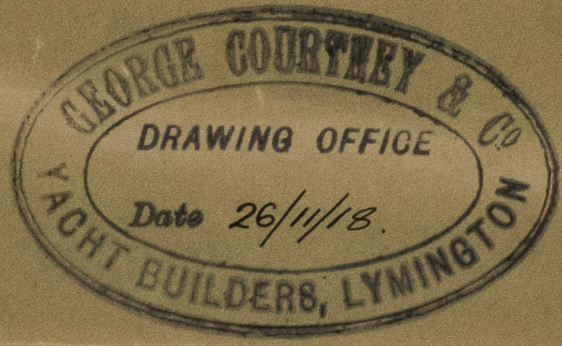

THICKENED AND WHELPED
TO STOCK.

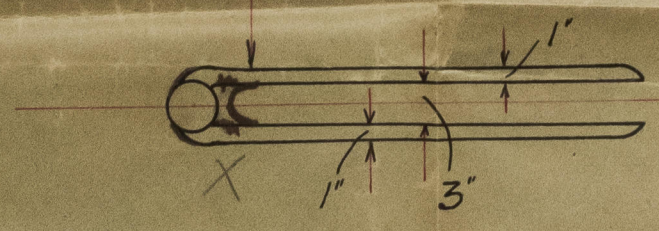

SCALE. 1" = 1 FOOT.

86 FT WOOD DRIFTER. DETAIL OF RUDDER STOCK.

DRAWING N° 268.

Recd 10/1/18

Ref. 10/1/18

Geo. Comptrey & Co.
Lymington.
86 ft Wood. Dusters.
Rudder Stock
Son. Reft No. 10490

007006-007018 0000


