



The Union Iron Works Co'

No 129.


Reconcaiso

"H. C. Folger"
ed

Profile & deck plans of
ships as built.

S. Fo. rpt. No. 2426.

4.

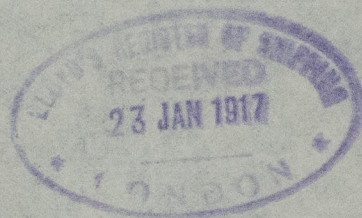

© 2021

Lloyd's Register
Foundation

007219-007234-0090

Mr. A. R. Kab.

L. Lloyd.



© 2021

Lloyd's Register
Foundation