


No 1071 MIDSHIP SECTION ISHERWOOD SYSTEM (PATENT)

SCALE 1/2 IN TO 1 FT.
TO CLASS "TELSHINSHO" 1st CLASS, &
LLOYD'S +100 A1.

PRINCIPAL DIMENSIONS	
LENGTH B.P.	255'-0"
BREADTH MLD	39'-0"
DEPTH	22'-9"

LLOYD'S NUMERALS	
D	= 22.75
L	= 255.00
1st Longt. No.	5801.25
B+D = 39.00+22.75	= 61.75
L	= 255.00
2nd Longt. No.	15746.25
1/10 TOUP DK.	= 11.21
1/10 TO BRIDGE DK.	= 8.57
PERCENTAGE OF LENGTH OF VESSEL COVERED BY SUPERSTRUCTURES = 43	

EQUIPMENTS AS PER RULE

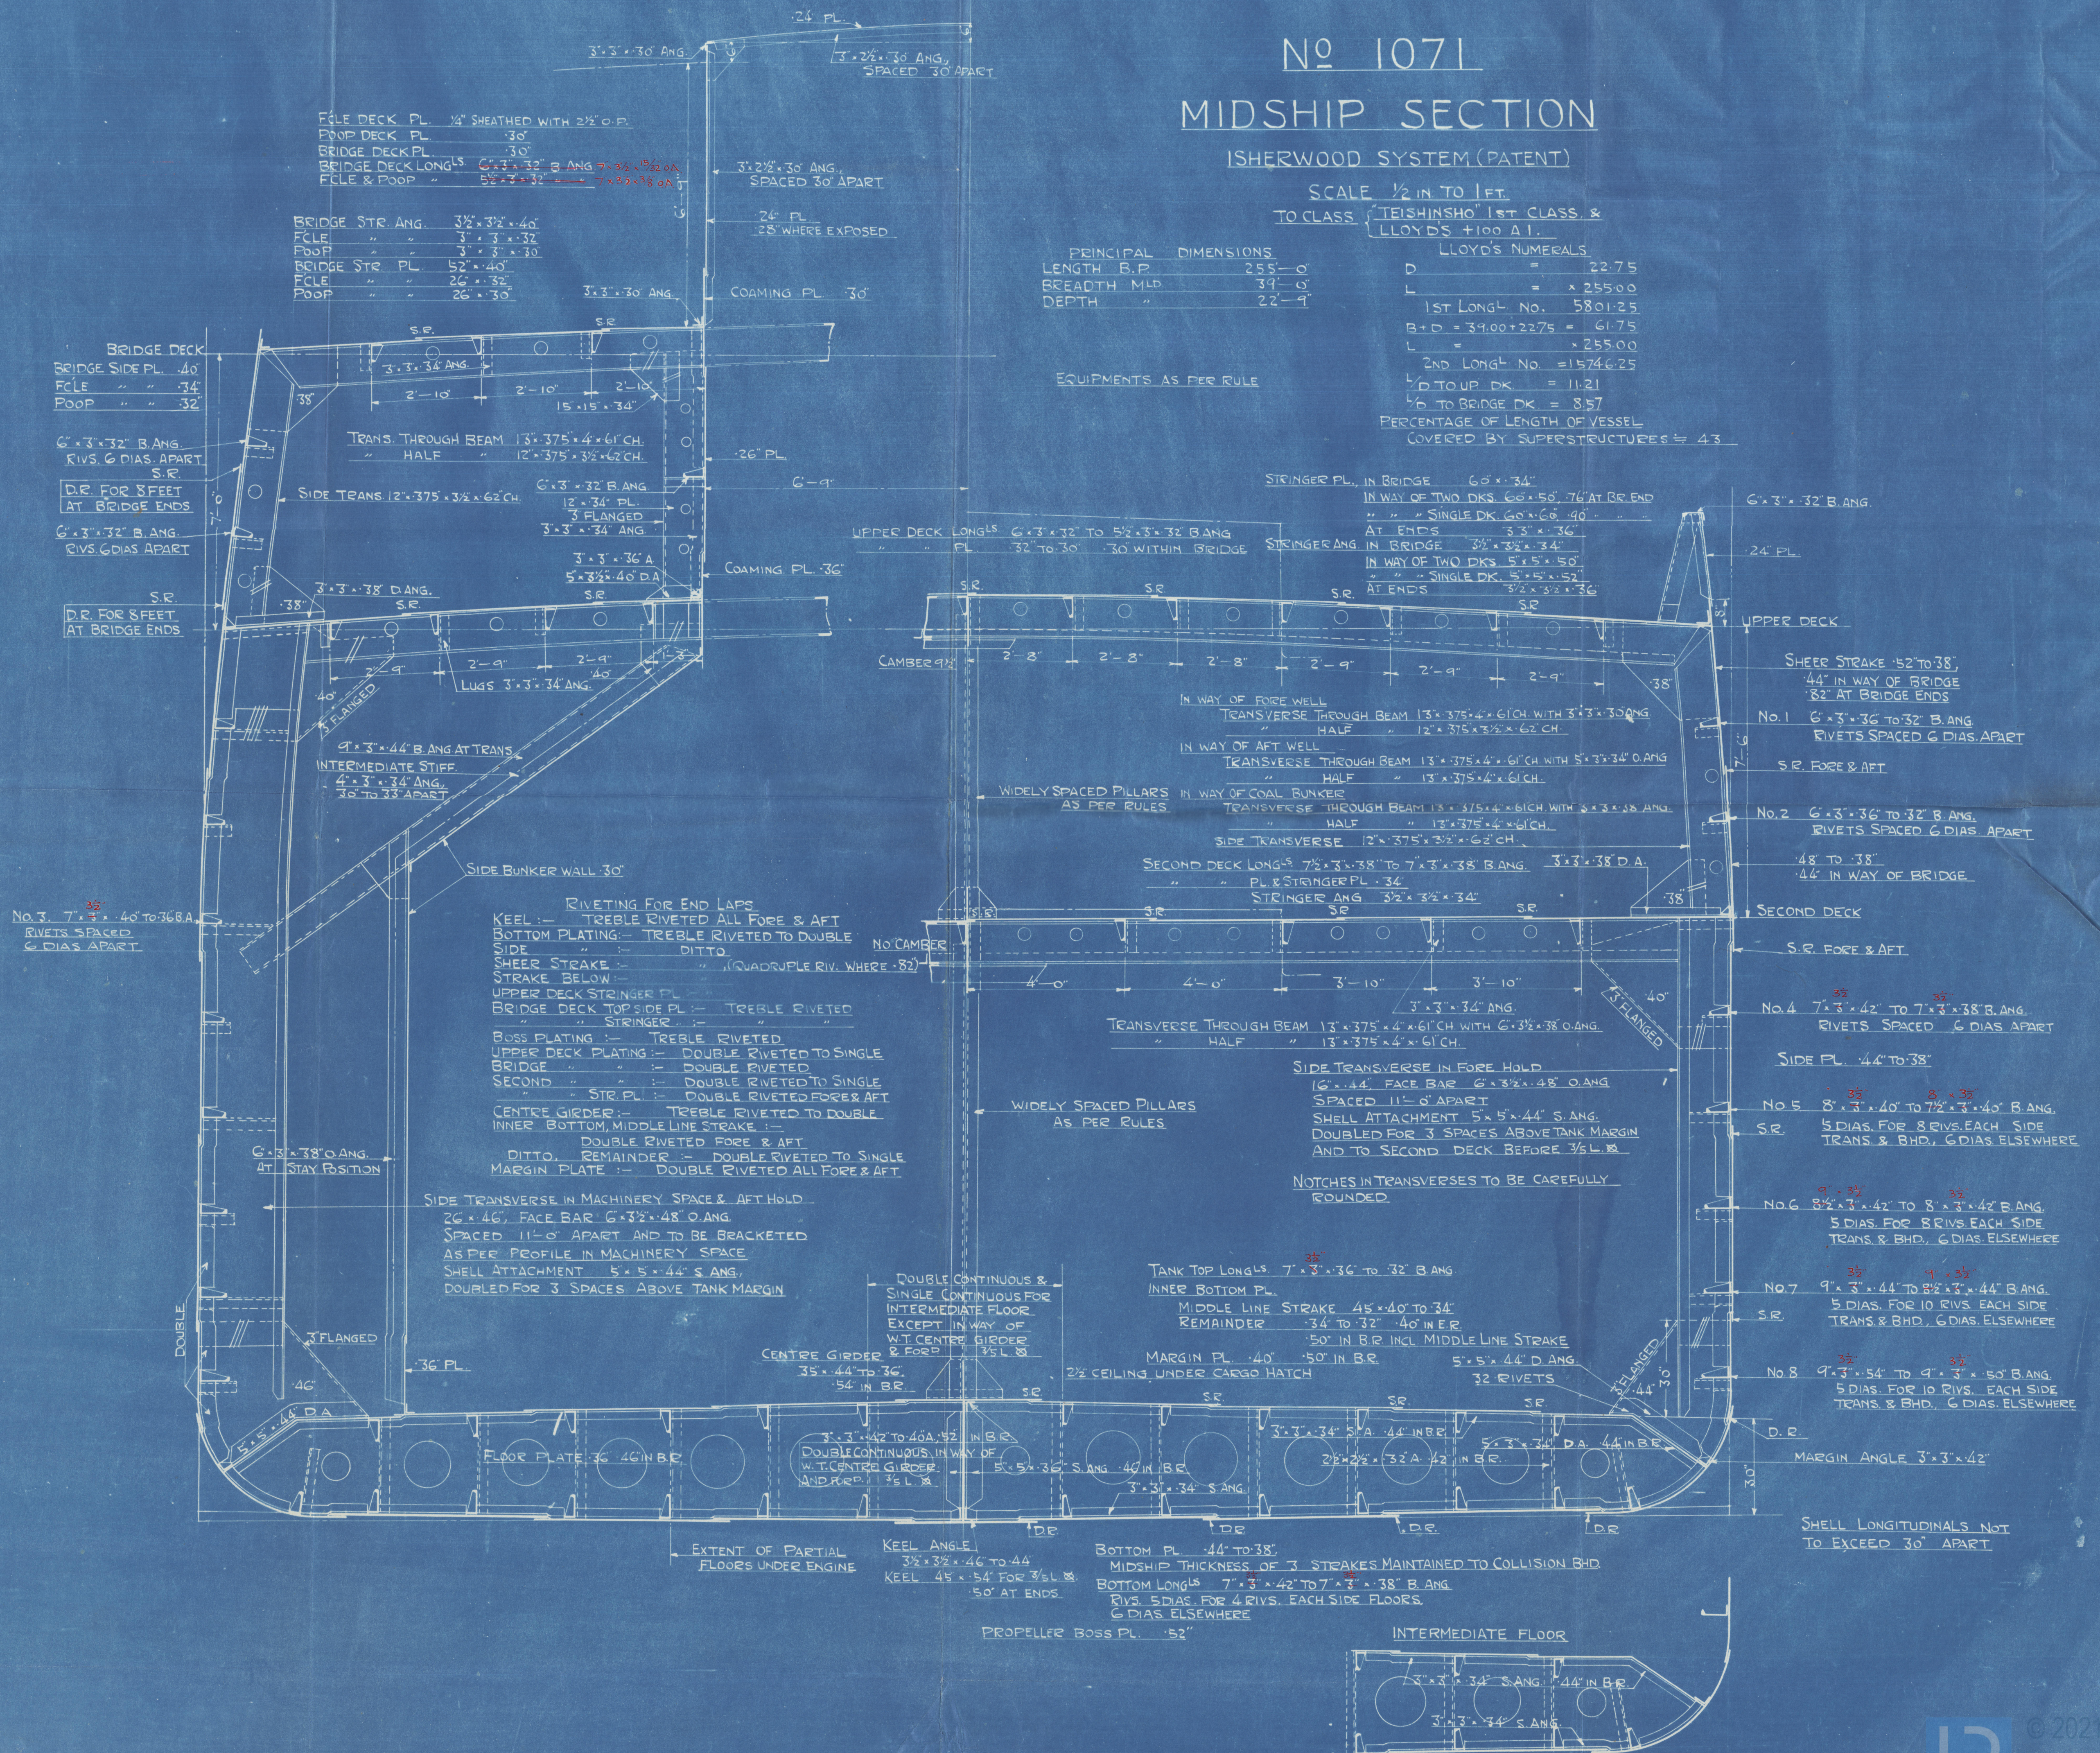

Section

Genbu Karon.



© 2021

Lloyd's Register
Foundation

007219-007234-0272



© 2021

Lloyd's Register
Foundation