
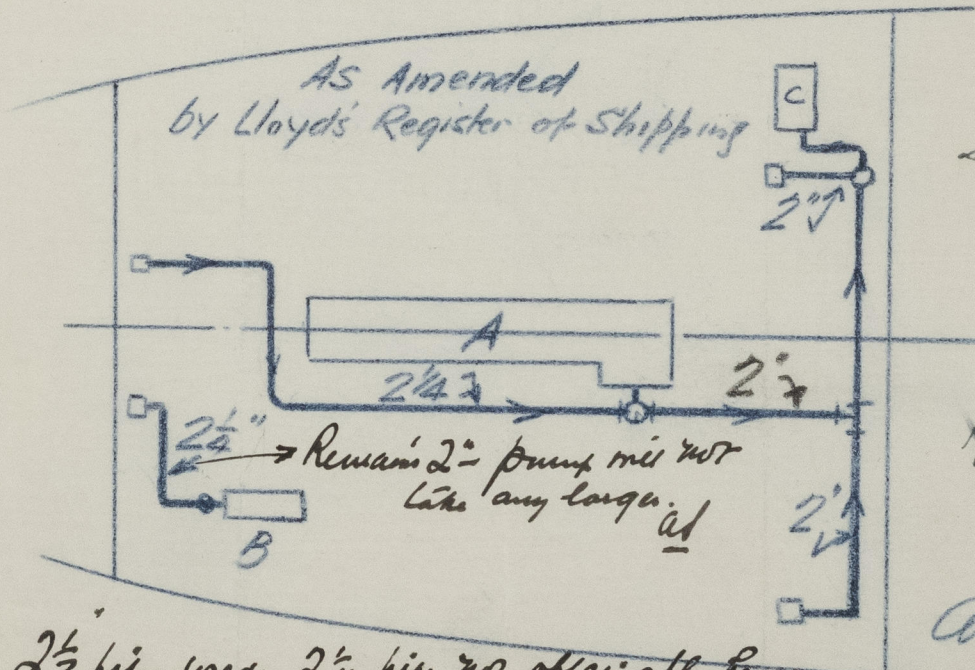


# Motor Tanker "Beeceelite" Engine Room Bilge Suctions

A - Main Engine  
B - Bilge Pump  
C - Fire Bilge Pump

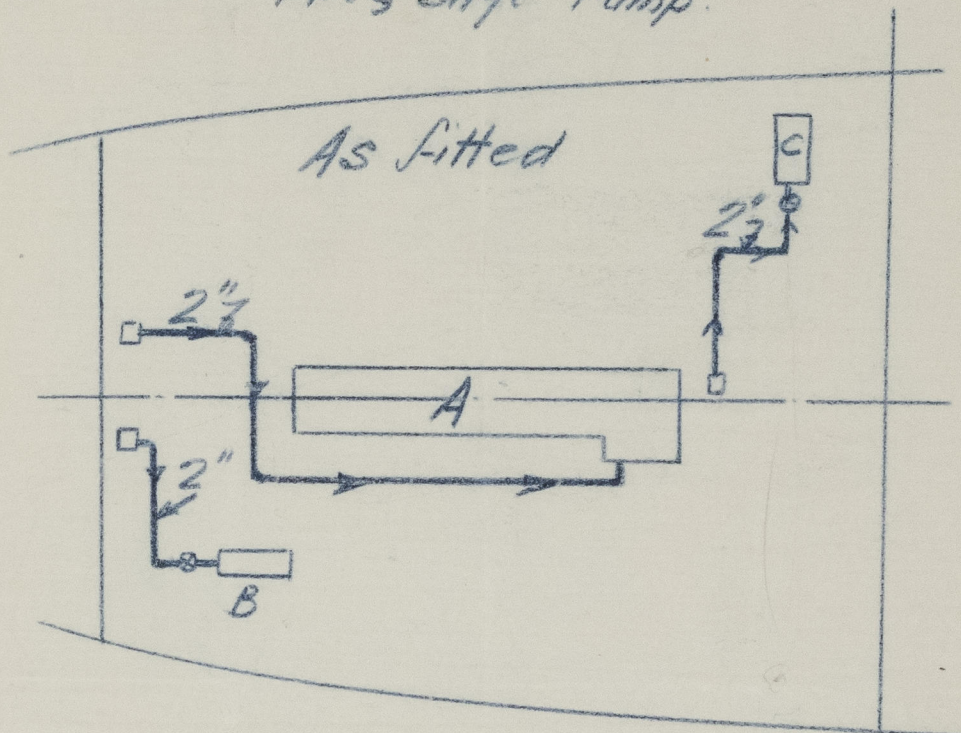

See Vancouver  
Report  
4981

No test  
8/2/39  
21/1/39

A. Hislop.  
10.3.38.

2 1/2" pipe used - 2 1/4" pipe not obtainable here.

Ad



© 2021

Lloyd's Register  
Foundation

007246-007256-0298