


S. S. SHOYO MARU.

BOTTOM SHEEL PLATE. Repair.

Yokohama Skyd.

Sept. 1940.

STARBOARD SIDE.

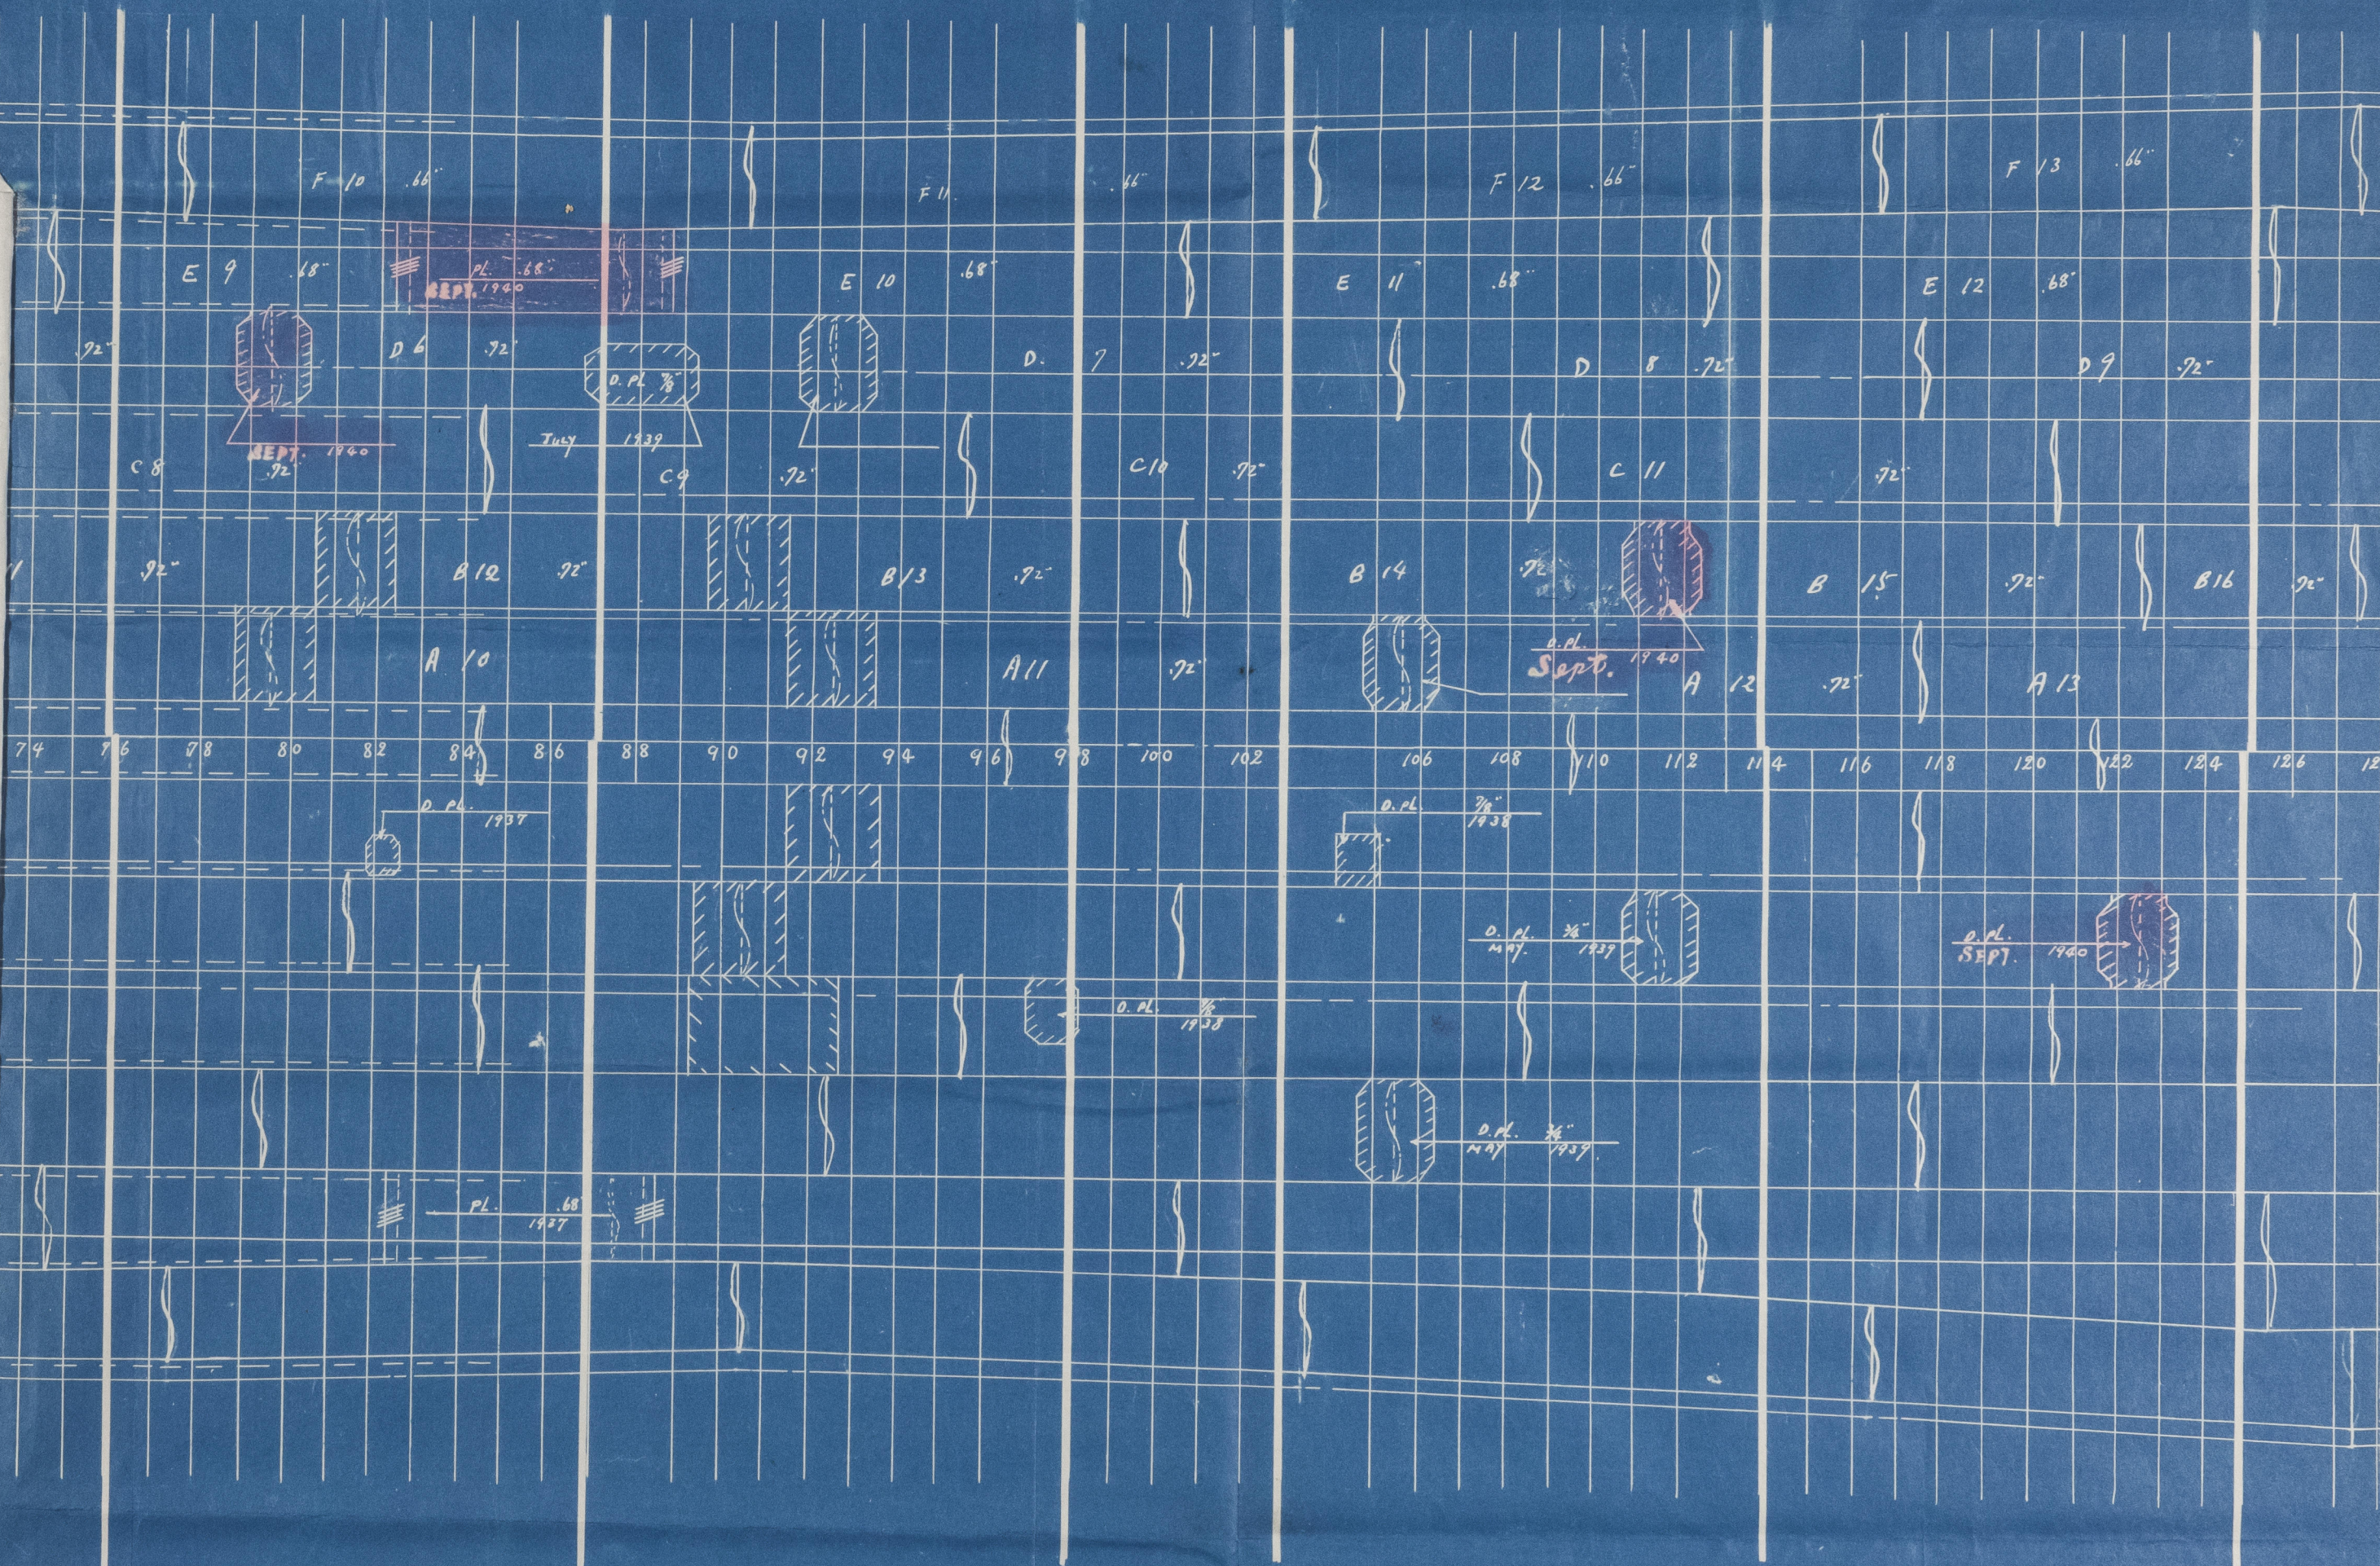


## PORT SIDE



"Syoyo Maru."

YKa Rpt. No. 6992.

© 2021

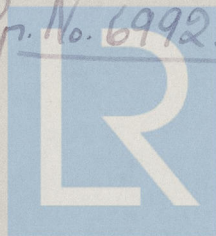

Lloyd's Register  
Foundation

007257-007265-0029