


注意


"S.Y. Y. M. M."

BULWARK

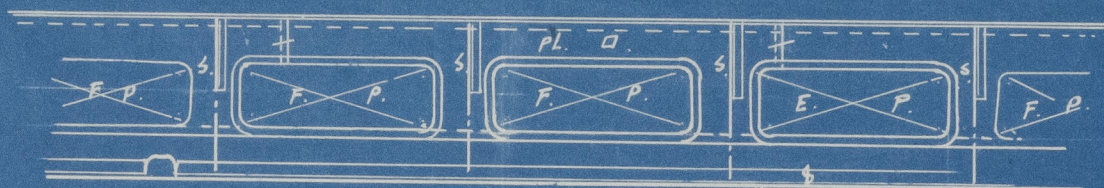

UPPER DECK (PORT SIDE)

Repaired Sept 1938

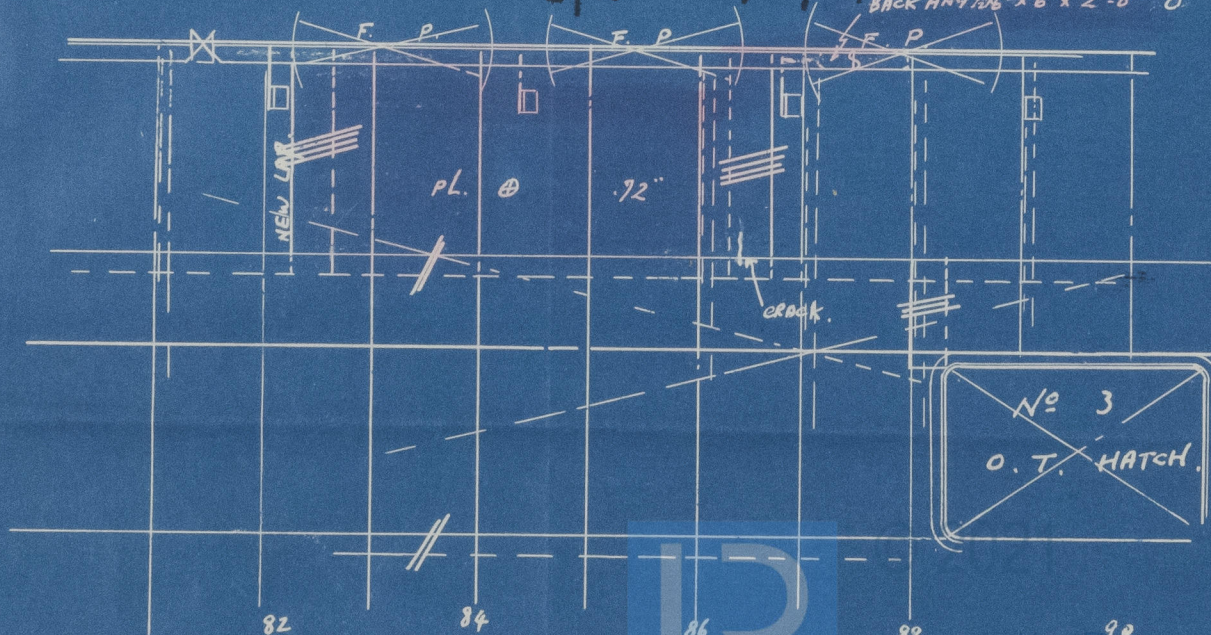

BACK ANGLE 6" x 6" x 2'-0" 0