


MIDSHIP SECTION.

S. S. N° 788
430' x 54' x 34'-10"

SCALE 1/4" = 1 FT

TO CLASS 100 A1 AT LLOYDS
BRIDGE 82' 4" FCL 37' 11 1/2" POOP 30' 4"

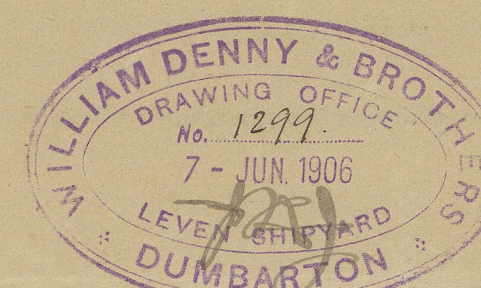

11-6-06

LLOYDS NUMERALS

1/2 BREADTH	27 000 ✓
DEPTH	35 958 ✓
1/2 GIRTH	58 915 ✓
	121 873 ✓
1st NUMERAL	114 873 ✓
LENGTH	x 427 96 ✓
2nd NUMERAL	49160 ✓

PROPORTIONS


LENGTH TO BEAM	7.92 ✓
DEPTH [UPPER]	11.9 ✓
[MAIN]	15.32 ✓

EQUIPMENT

1/2 BREADTH	27 000 ✓
DEPTH	35 958 ✓
1/2 GIRTH	58 915 ✓
	121 873 ✓
LENGTH	x 427 96 ✓
	52155 ✓
BRIDGE, FCL & POOP	1613 ✓
EQUIPMENT NUMERAL	33108 ✓

EQUIPMENT

3 BOWERS COLLECTIVE WEIGHT	155 1/2 CWT. EX STOCK ✓
1 STREAM 19 CWT. EX STOCK	✓
1 KEDGE 8	✓
270 FATHOMS 2 5/8" STUD CHAIN CABLE	✓
90 1 1/4" STREAM CHAIN OR 5" STEEL WIRE	✓
120 1 1/2" HEMP OR 5 1/2" STEEL WIRE	✓
2 @ 90 8" HAWSER	✓
2 @ 90 7" WARP	✓

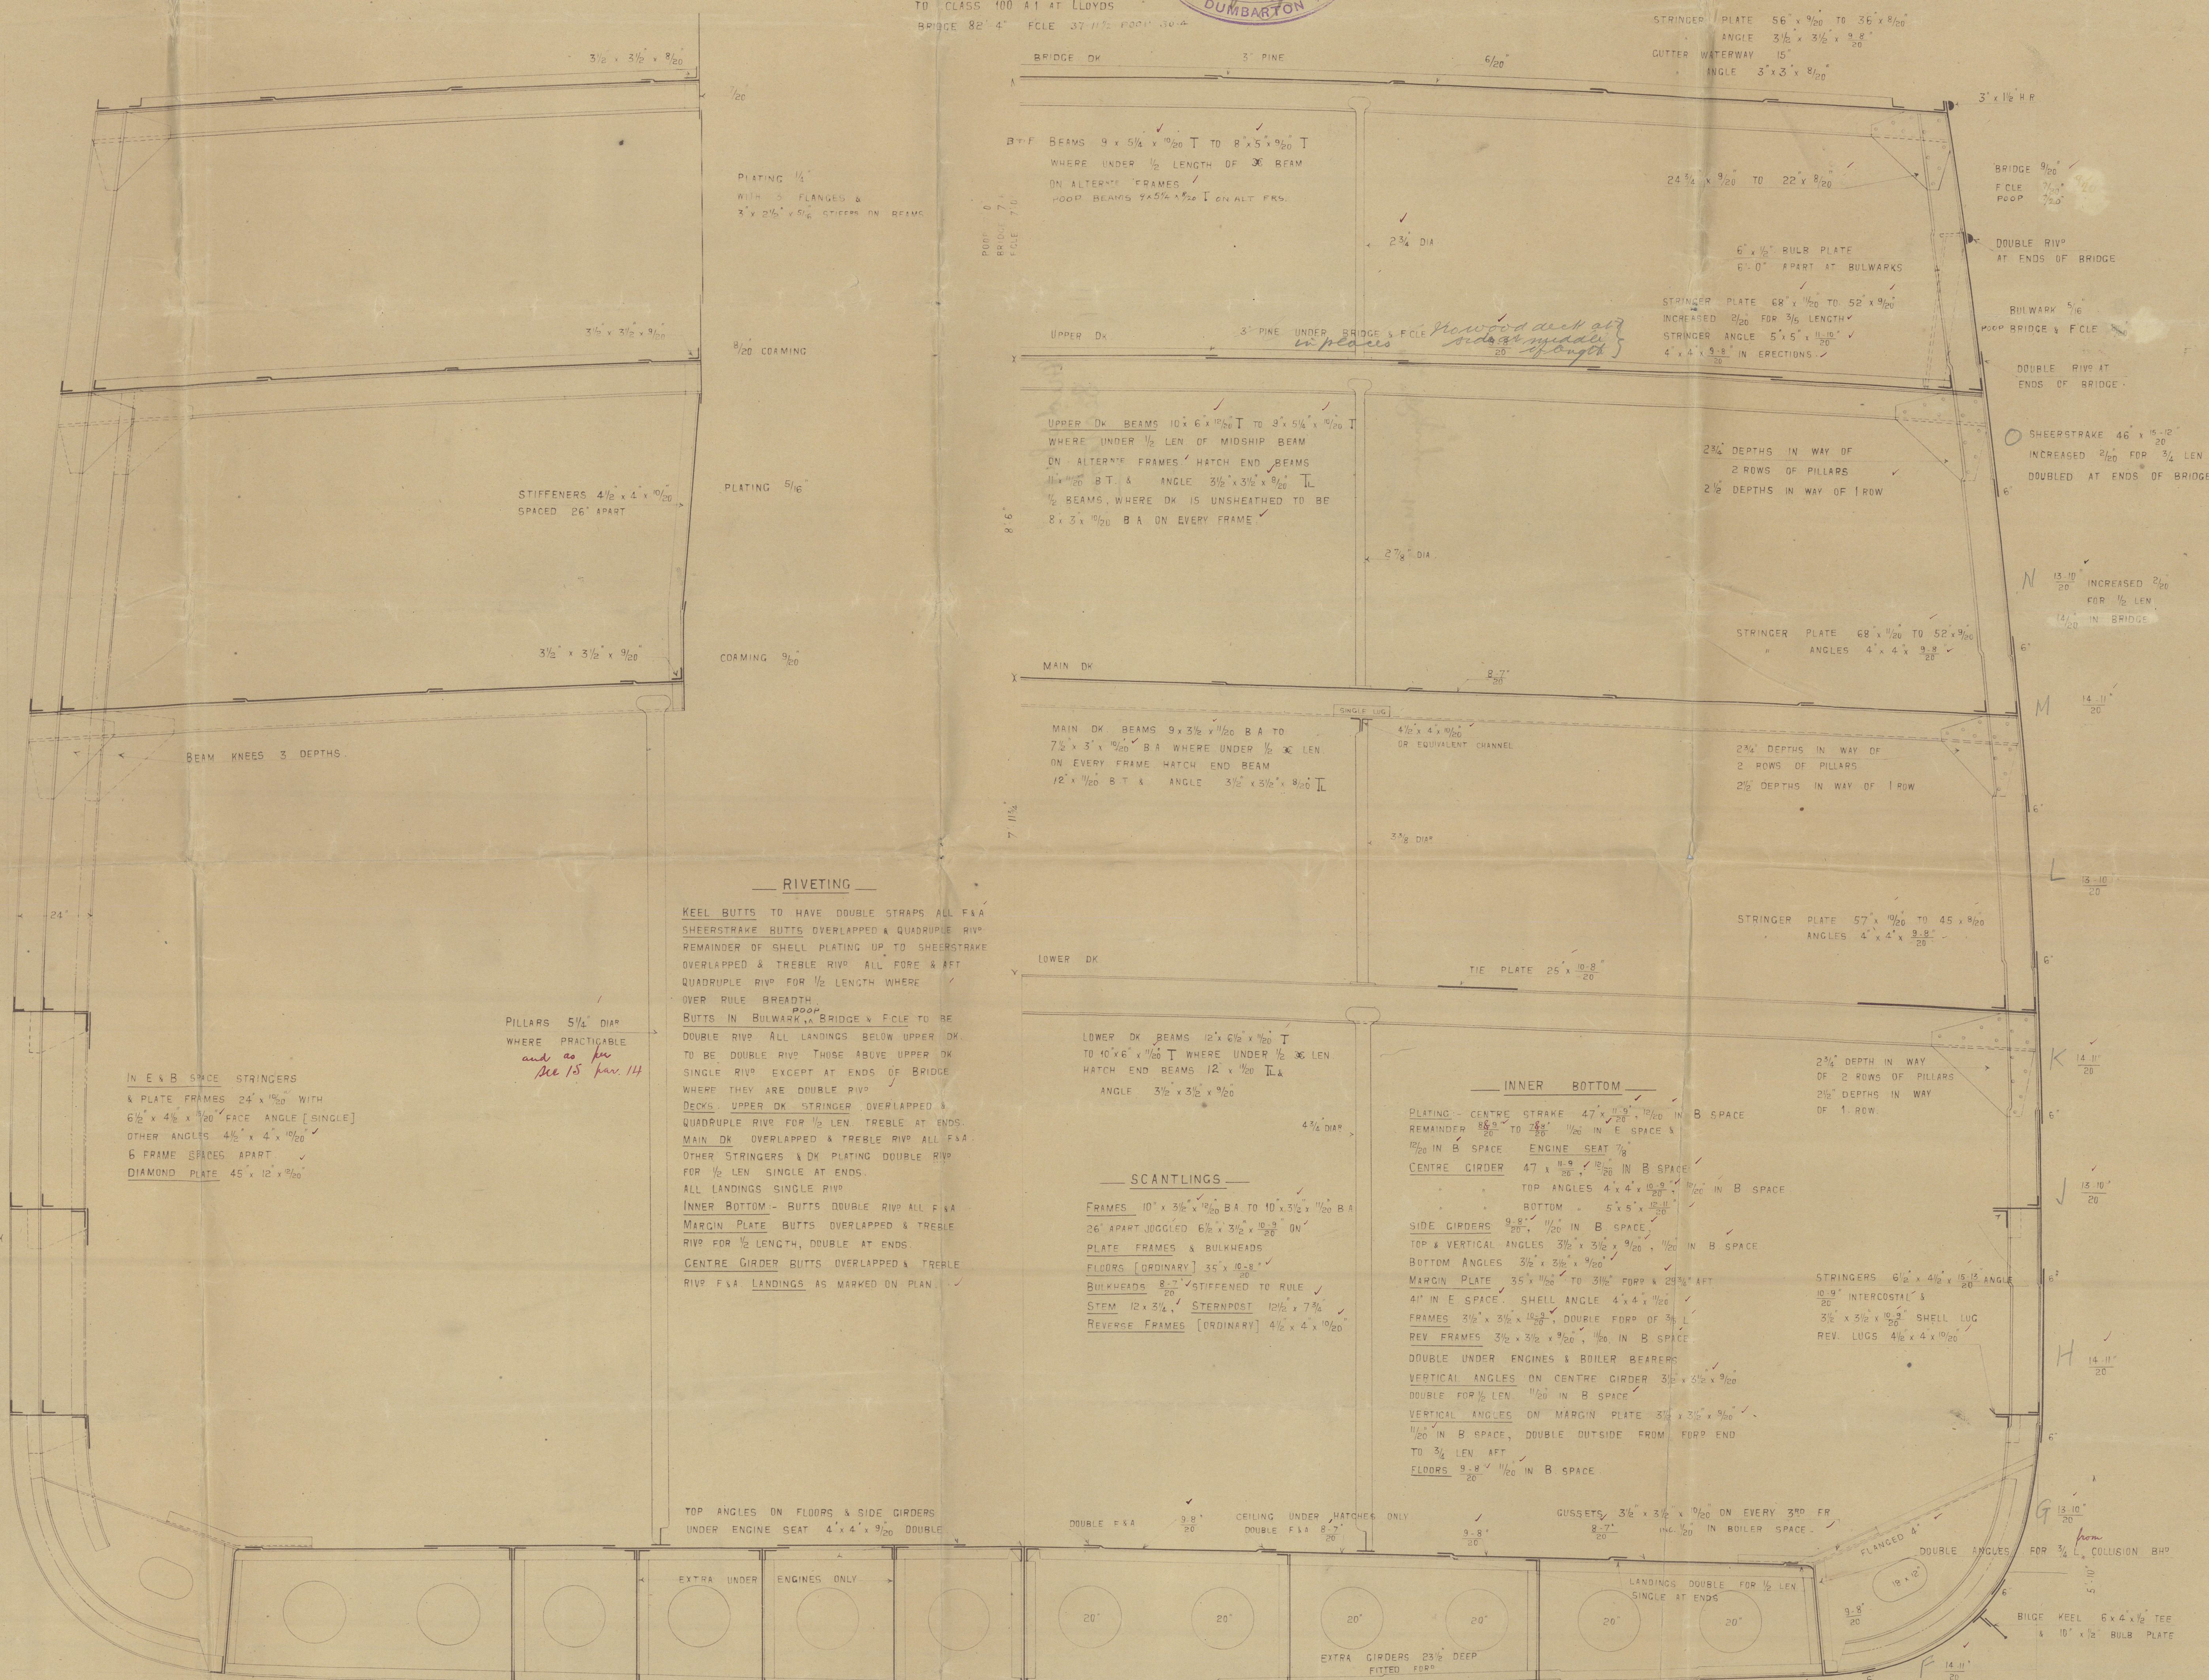

11-6-06

2/2/8/6/06

Midship
Section


W. Penny Mo
No 788

"Culna"

Gls. npt. No. 24893



The "Regin Man"

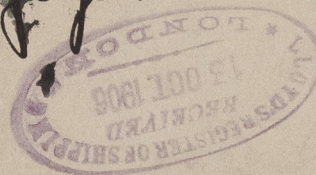

© 2021

Lloyd's Register
Foundation

007257-007265-0053