

and p m m b a d
N. 242.
water (gibbs) M

17.9.12

0450-18500-18500

17.9.12

MIDSHIP SECTION

N^o 545


STEEL SCREW TRAWLER.

DIM^s 120'-0" B.P. x 21'-6" E.X. 12'-3" MLD.

SCALE 1/2 INCH.

VESSEL TO CLASS 100.A.1. STEAM TRAWLER.
DECK PLATED OVER IN WAY OF MACHINERY.
E & B. CASING AS PREVIOUSLY APPROVED.

PLAN No. 1973
FOR ENCLOSURE TO
Messrs. Lloyd's Surveyors
Hull FROM
COCHRANE & SONS.
SHIPBUILDERS, SELBY.
DATE 13/9/12 RR

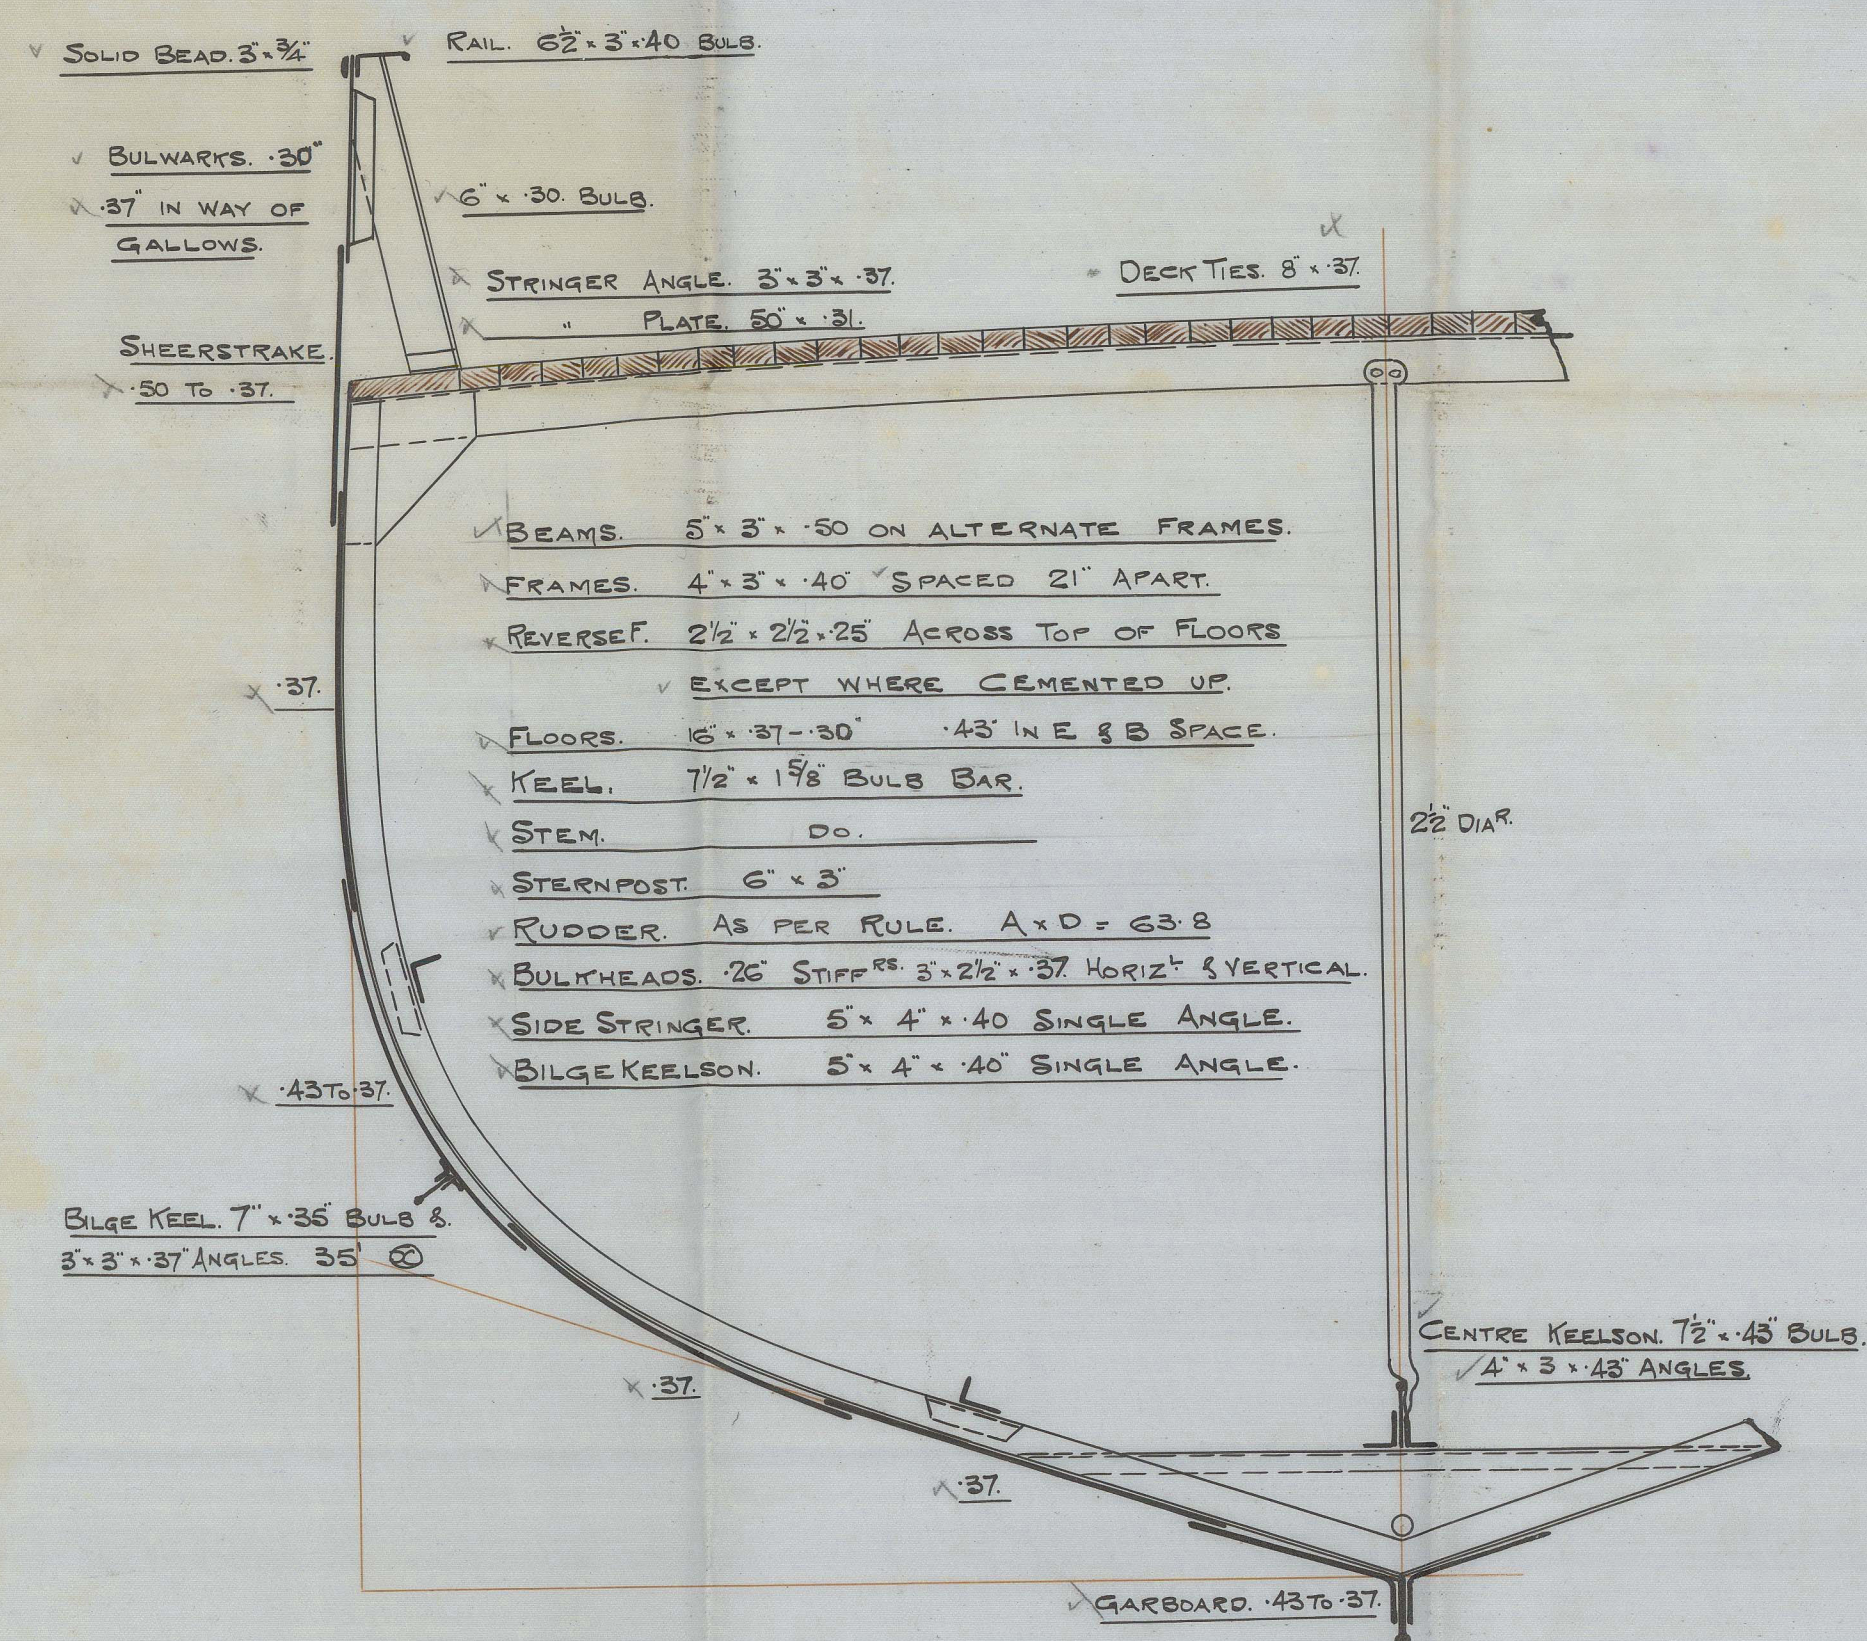

NUMERALS.

B + D = 33.62
L x (B + D) = 4035

PROPORTIONS.

L/D = 9.79
B/L = 5.61

EQUIPMENT.

1st BOWER ANCHOR. 5 CWTs EX STOCK
2nd " " 42 " " "
KERGE. 2 1/2 " " "
90 FATHOMS 1" CABLE.
60 " 5/8" HAWSER.
60 " 4" WARP.

RIVETING.

BUTTS OF SHELL PLATING LAPPED
8 DOUBLE RIV. EXCEPT GARBOARD
8 SHEERSTRAKE WHICH ARE TO BE,
STRAPPED 8 DOUBLE RIV. LANDINGS
DOUBLE RIVETED. BULWARKS SINGLE

C.B.
17.9.12.

007276-007281-0260