


Nº 545

SCALE 1/4 INCH.

PLAN No. 1974  
FOR ENCLOSURE TO  
Messrs Lloyd's Surveyors  
Hull FROM  
COCHRANE & SONS,  
SHIPBUILDERS, SELBY  
DATE 13/9/12 RR

[illegible]

PILLARING THROUGHOUT TO SURVEYORS SATISFACTION.

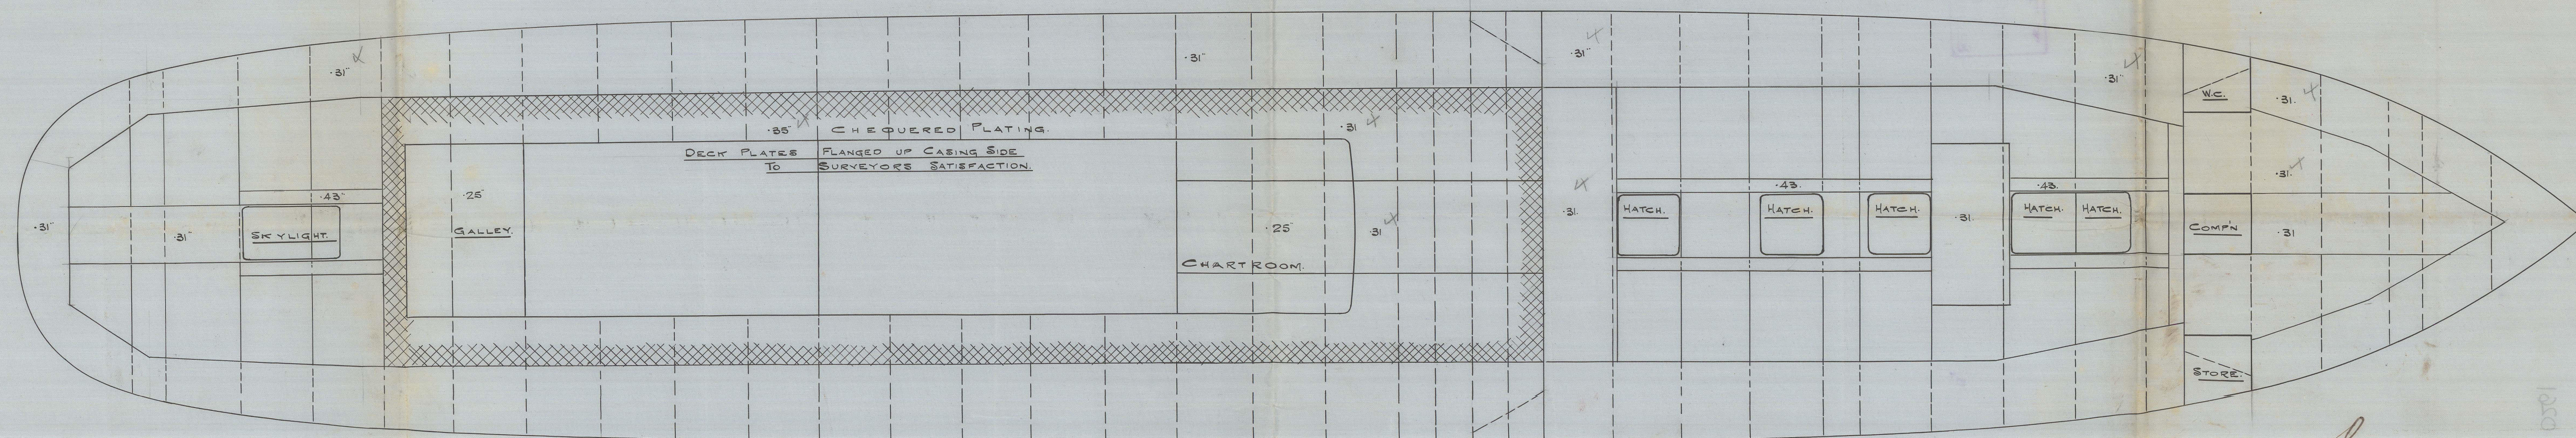

C.B.  
17.9.12


007276- 007287- 0261



Cochrane & Sons  
No 545.

Profile & Deck Plan.

$\frac{1}{2}$  Lintonian Hull Report No: 25767

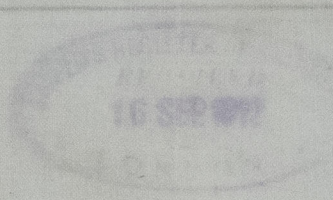

007276 - 007287 - 0261

1050 18500 0501

$\frac{1}{2}$  Lintonian



© 2021

Lloyd's Register  
Foundation



W. L. TUNNEY

BUNKER

2. T. TO SINGLE ANGLE

THAT

ROUGHOUT TO SURVEYORS SATISFACTION

DECK PLATE FLANGED UP CAIRING S  
TO SURVEYORS SATISFAC

HATCH

HATCH

HATCH

HATCH

HATCH



© 2021

Lloyd's Register  
Foundation