


N. 255.
Cochran & Co.

10-0-0 x 5-0-0 x 12-0-0
Tropical & Temperate

Three Reports No. 12276
% Station

PLAN No. 2601
FOR ENCLOSURE TO
Mess^{rs} Lloyd's Surveyors
Hull FROM
COCHRANE & CONS. LTD.
SHIPBUILDERS, SEVEN
DATE 26/2/13. RK

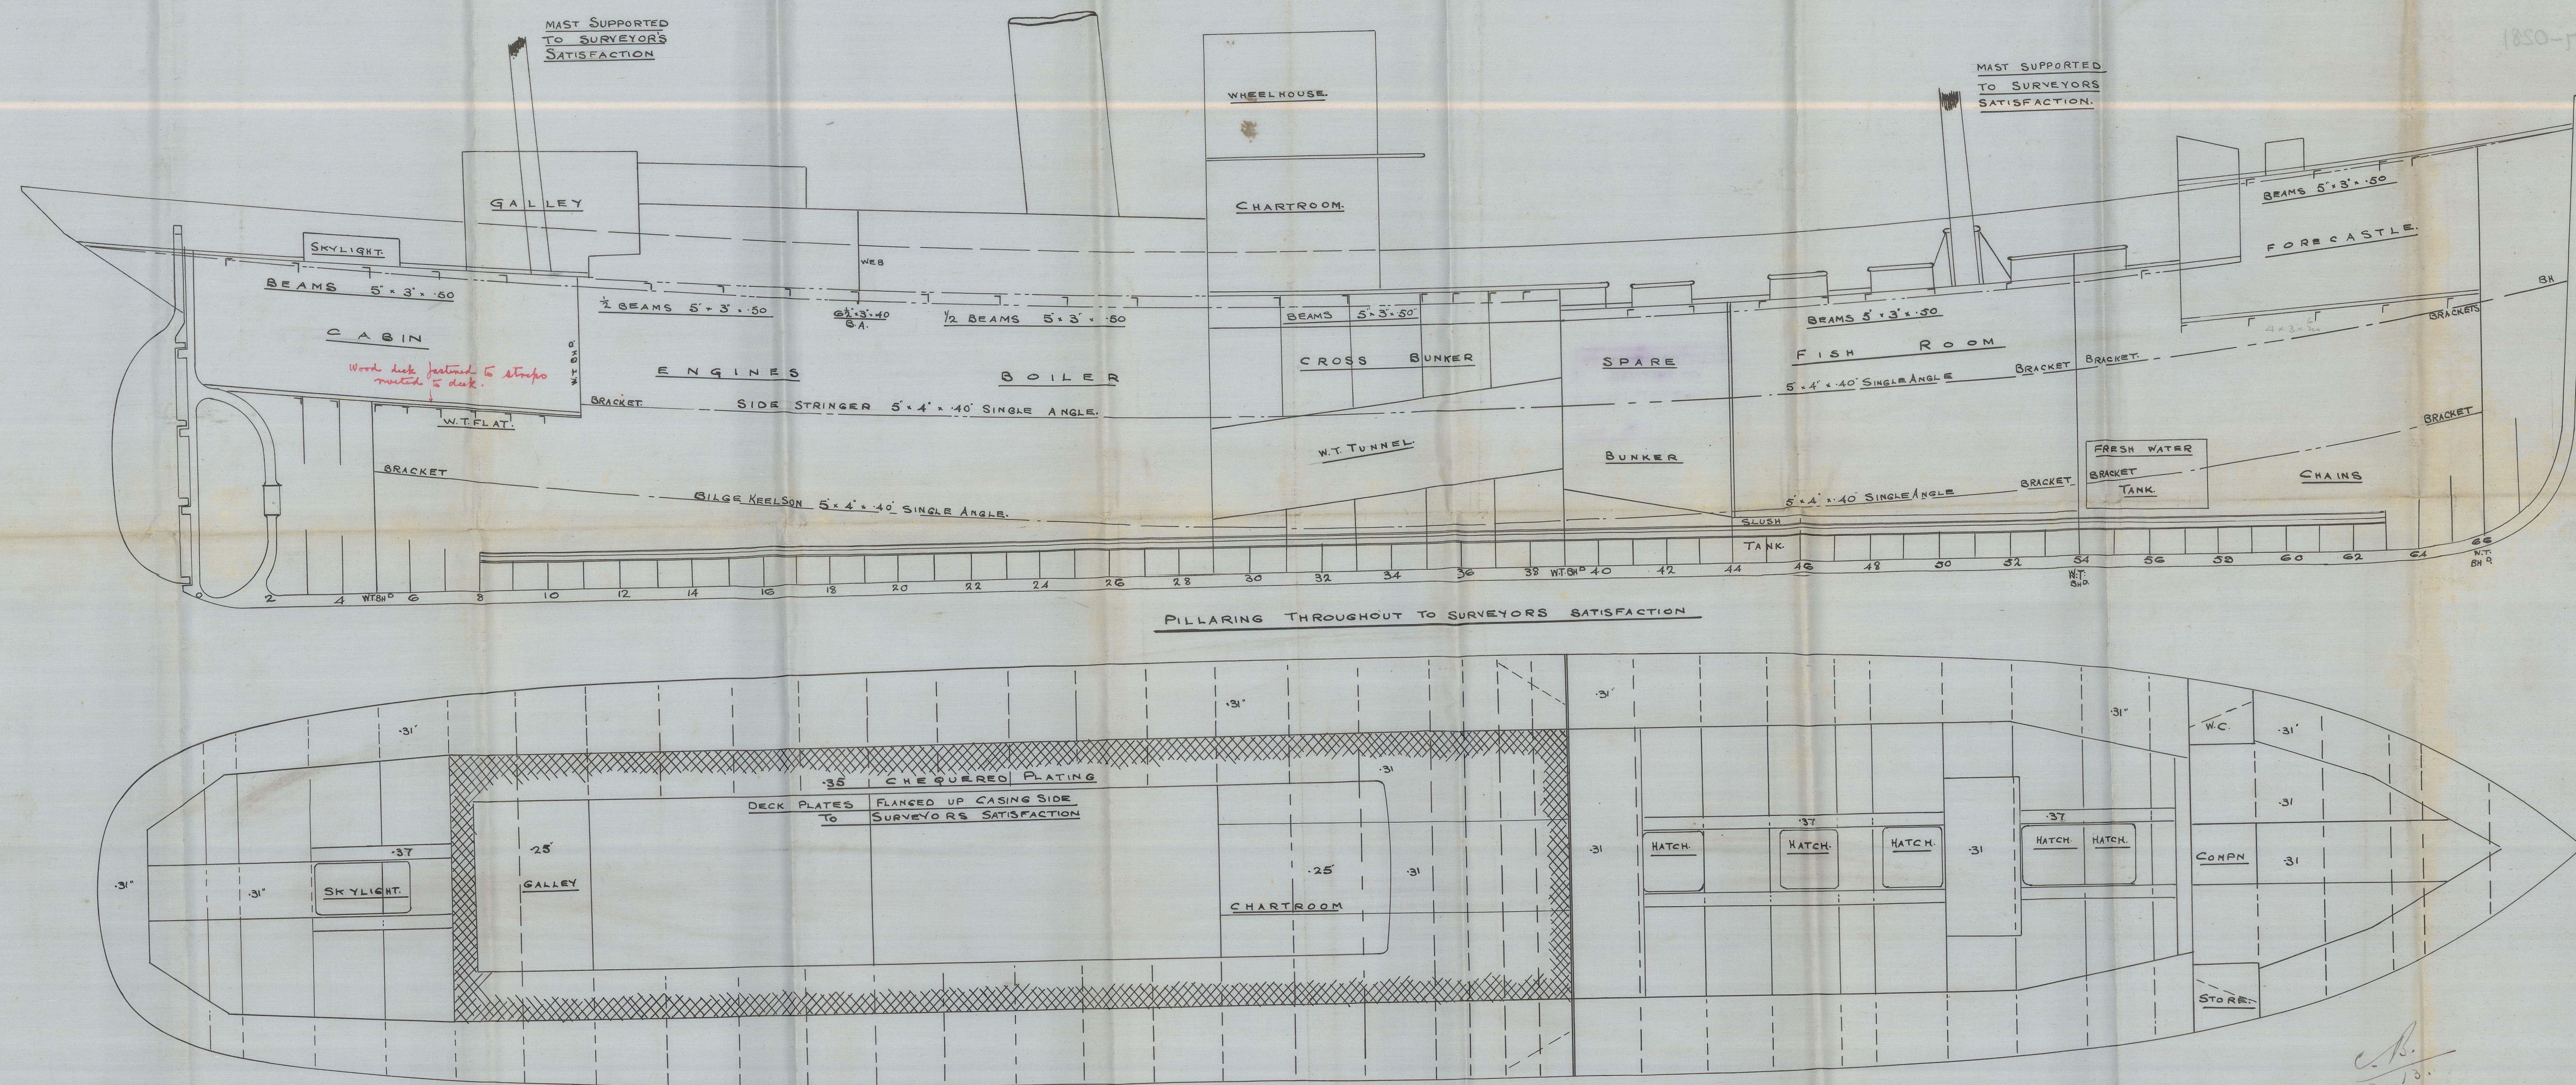

C.B.
3. 3. 13.

007276-007287-0281

Cochrane & Sons.
No. 577.

Profile & Deck Plan

120-0 x 21-37 x 12-25.

J. Glatton

Kuehl Report No: 26576

007276-007287-0281



© 2021

Lloyd's Register
Foundation