


1578 1000 + 6000 871
No 275
Mississippi
120-0 = 21-37 + 12-22
#275
Mississippi No. 275

Nº 577

DIMS 120'-0" B.P. x 21'-6" E x. 12'-3" MLD

SCALE $\frac{1}{2}$ INCH.

✓ VESSEL TO CLASS 100.A.1 STEAM TRAWLER.
✓ DECK PLATED OVER IN WAY OF MACHINERY.
✓ E & B. CASING AS PREVIOUSLY APPROVED.

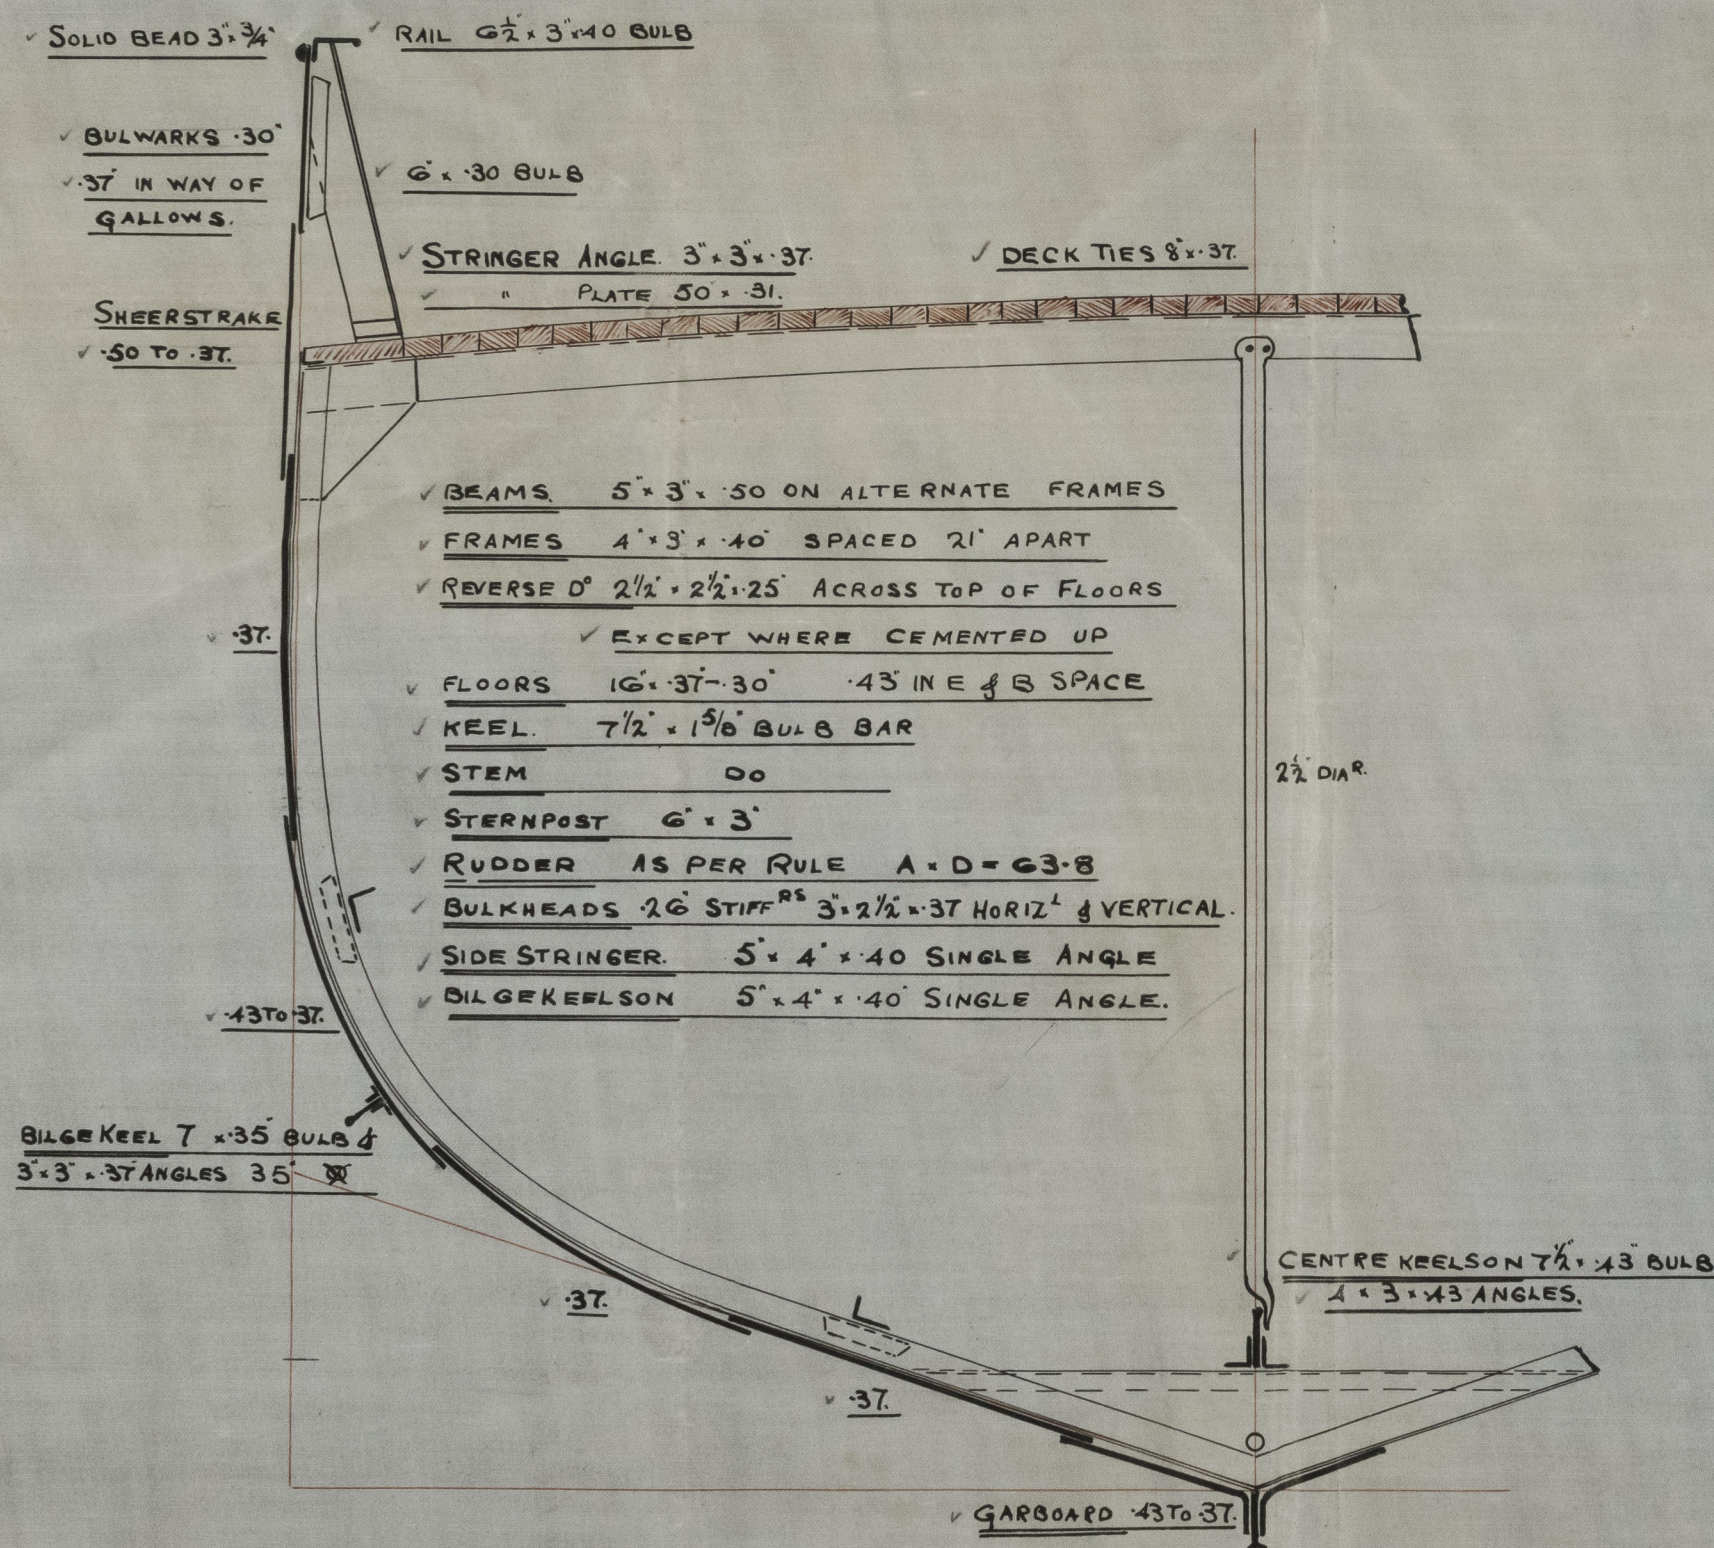

FOR ENCLOSURE TO
Messrs Lloyd's Surveyors
Hull FROM
COCHRANE & SONS, LTD.
SHIPBUILDERS, SELBY
DATE 26/2/13. RK

$$\begin{array}{rcl} \checkmark B + D & = & 33.62 \\ \checkmark L \times (B + D) & = & 4035 \end{array}$$

✓ $\frac{1}{0.1}$ = 9.79

✓ $\frac{1}{0.19}$ = 5.61

✓ 1 ST	BOWER ANCHOR	5 CWTs	EX STOCK
✓ 2 ND	" "	4½	" " "
✓ KEDGE		2½	" " "
✓ 90 FATHOMS		1"	CABLE
✓ 60 "		5½	HAWSER
✓ 60 "		4'	WARP.

- ✓ BUTTS OF SHELL PLATING LAPPED
- ✓ \oint DOUBLE RIV^d EXCEPT GARBOARD
- ✓ \oint SHEERSTRAKE WHICH ARE TO BE.
- ✓ STRAPPED \oint DOUBLE RIV^d LANDINGS
- ✓ DOUBLE RIVETED. BULWARKS SINGLE.

C.B.
3.3.13

007272- 007287- 0282

Cochrane & Sons. Ltd.
No. 577.

Midship Section.

120-0 x 21-37 x 12-25

#Glation
Hull Report No: 26576

818.8

2820-72700-0282



© 2021

Lloyd's Register
Foundation