

22.11.01

— S. S. N° 416. —

DIMENSIONS :- 400'-0" B.P. \times 48'-6" MLD \times 30'-0" ML

— PROFILE.—

SCALE $\frac{1}{8}$ " - ONE F

DOUBLE FRAMES ON PORT SIDE 21' 1/2"
FROM KEEL TO 3'-0" ABOVE TANK
DOUBLE FRAMES ON STARBOARD SIDE 21, 22, 23'
KEEL TO 13'-6" ABOVE BASE

STINGER BRACKET
SCALE $\frac{1}{2}'' = 1 \text{ FOOT}$

NOTE: - GUSSET PLATES AT TANK MARG
25" x 25" DOUBLING REVERSE
IN WAY OF SARE.

RAKE $1\frac{7}{8}$ PER H

RAKE 1 1/2 PER FT

5'5'15 05

UPPER DE

10

LOWER 2


IV. FRAMES IN

FLOORS



22.11.0

[Handwritten notes, mostly illegible due to blurring]

THE FAIRFIELD
SHIPBUILDING & ENGINEERING CO.
(LIMITED)
19 NOV. 1900
SHIP DEPARTMENT
GLASGOW, GLASGOW

Wm. J. ...
Wm. J. ...
Wm. J. ...


Amended profile

The Fairfield stb

N. 116

W. "Kumano Maru"

Gasport Report 1912

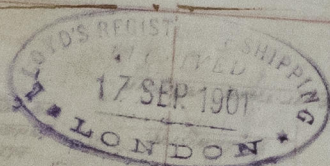

007288 - 007300 - 0081



© 2021

Lloyd's Register
Foundation




SCALE $\frac{1}{8}$ = ONE F.T.

PROFILE

DIMENSIONS: - 400-0" Bb x 48-6" Wb x 30-0" Hb

— 22 No 416. —