


# 舵及船尾材

一八一

船大ニ分テ所ニ取テ

御承認用

D No H 14

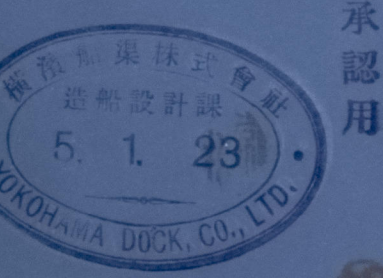

S.No 181


STEM FRAME & RUDDER

SCALE 1/2" = 1'-0"

注意 一本材ヨリ檢査官檢査ヲ受テ 今檢査証書  
ニ本圖記載寸法凡テ特記 外注上寸法トス  
三各鑄物切斷面形狀並ニ印寸法及其他  
不明瞭箇所ニ型板通シ製作ス

A: RUDDER AREA 193.3  
D: {DISTANCE OF C.G. OF A} 5.23 FT  
A x D: 183.3 x 5.23 = 958.66 FT<sup>2</sup>  
MAXIMUM SERVICE SPEED 14 K  
DIA. OF RUDDER STOCK  
COMPLIED WITH LLOYDS RULES 15 1/2"

ESTIMATED WEIGHTS		
ITEMS	CAST STEEL	FORGED STEEL
STERN FRAME	6.50 T	—
STOCK WITH EYES	—	8.04 T
RUDDER FRAME	6.85 T	—
6 COUPLING BOLTS	—	0.37 T
3 PINTLES	—	0.52 T
SUM	13.35 T	8.93 T

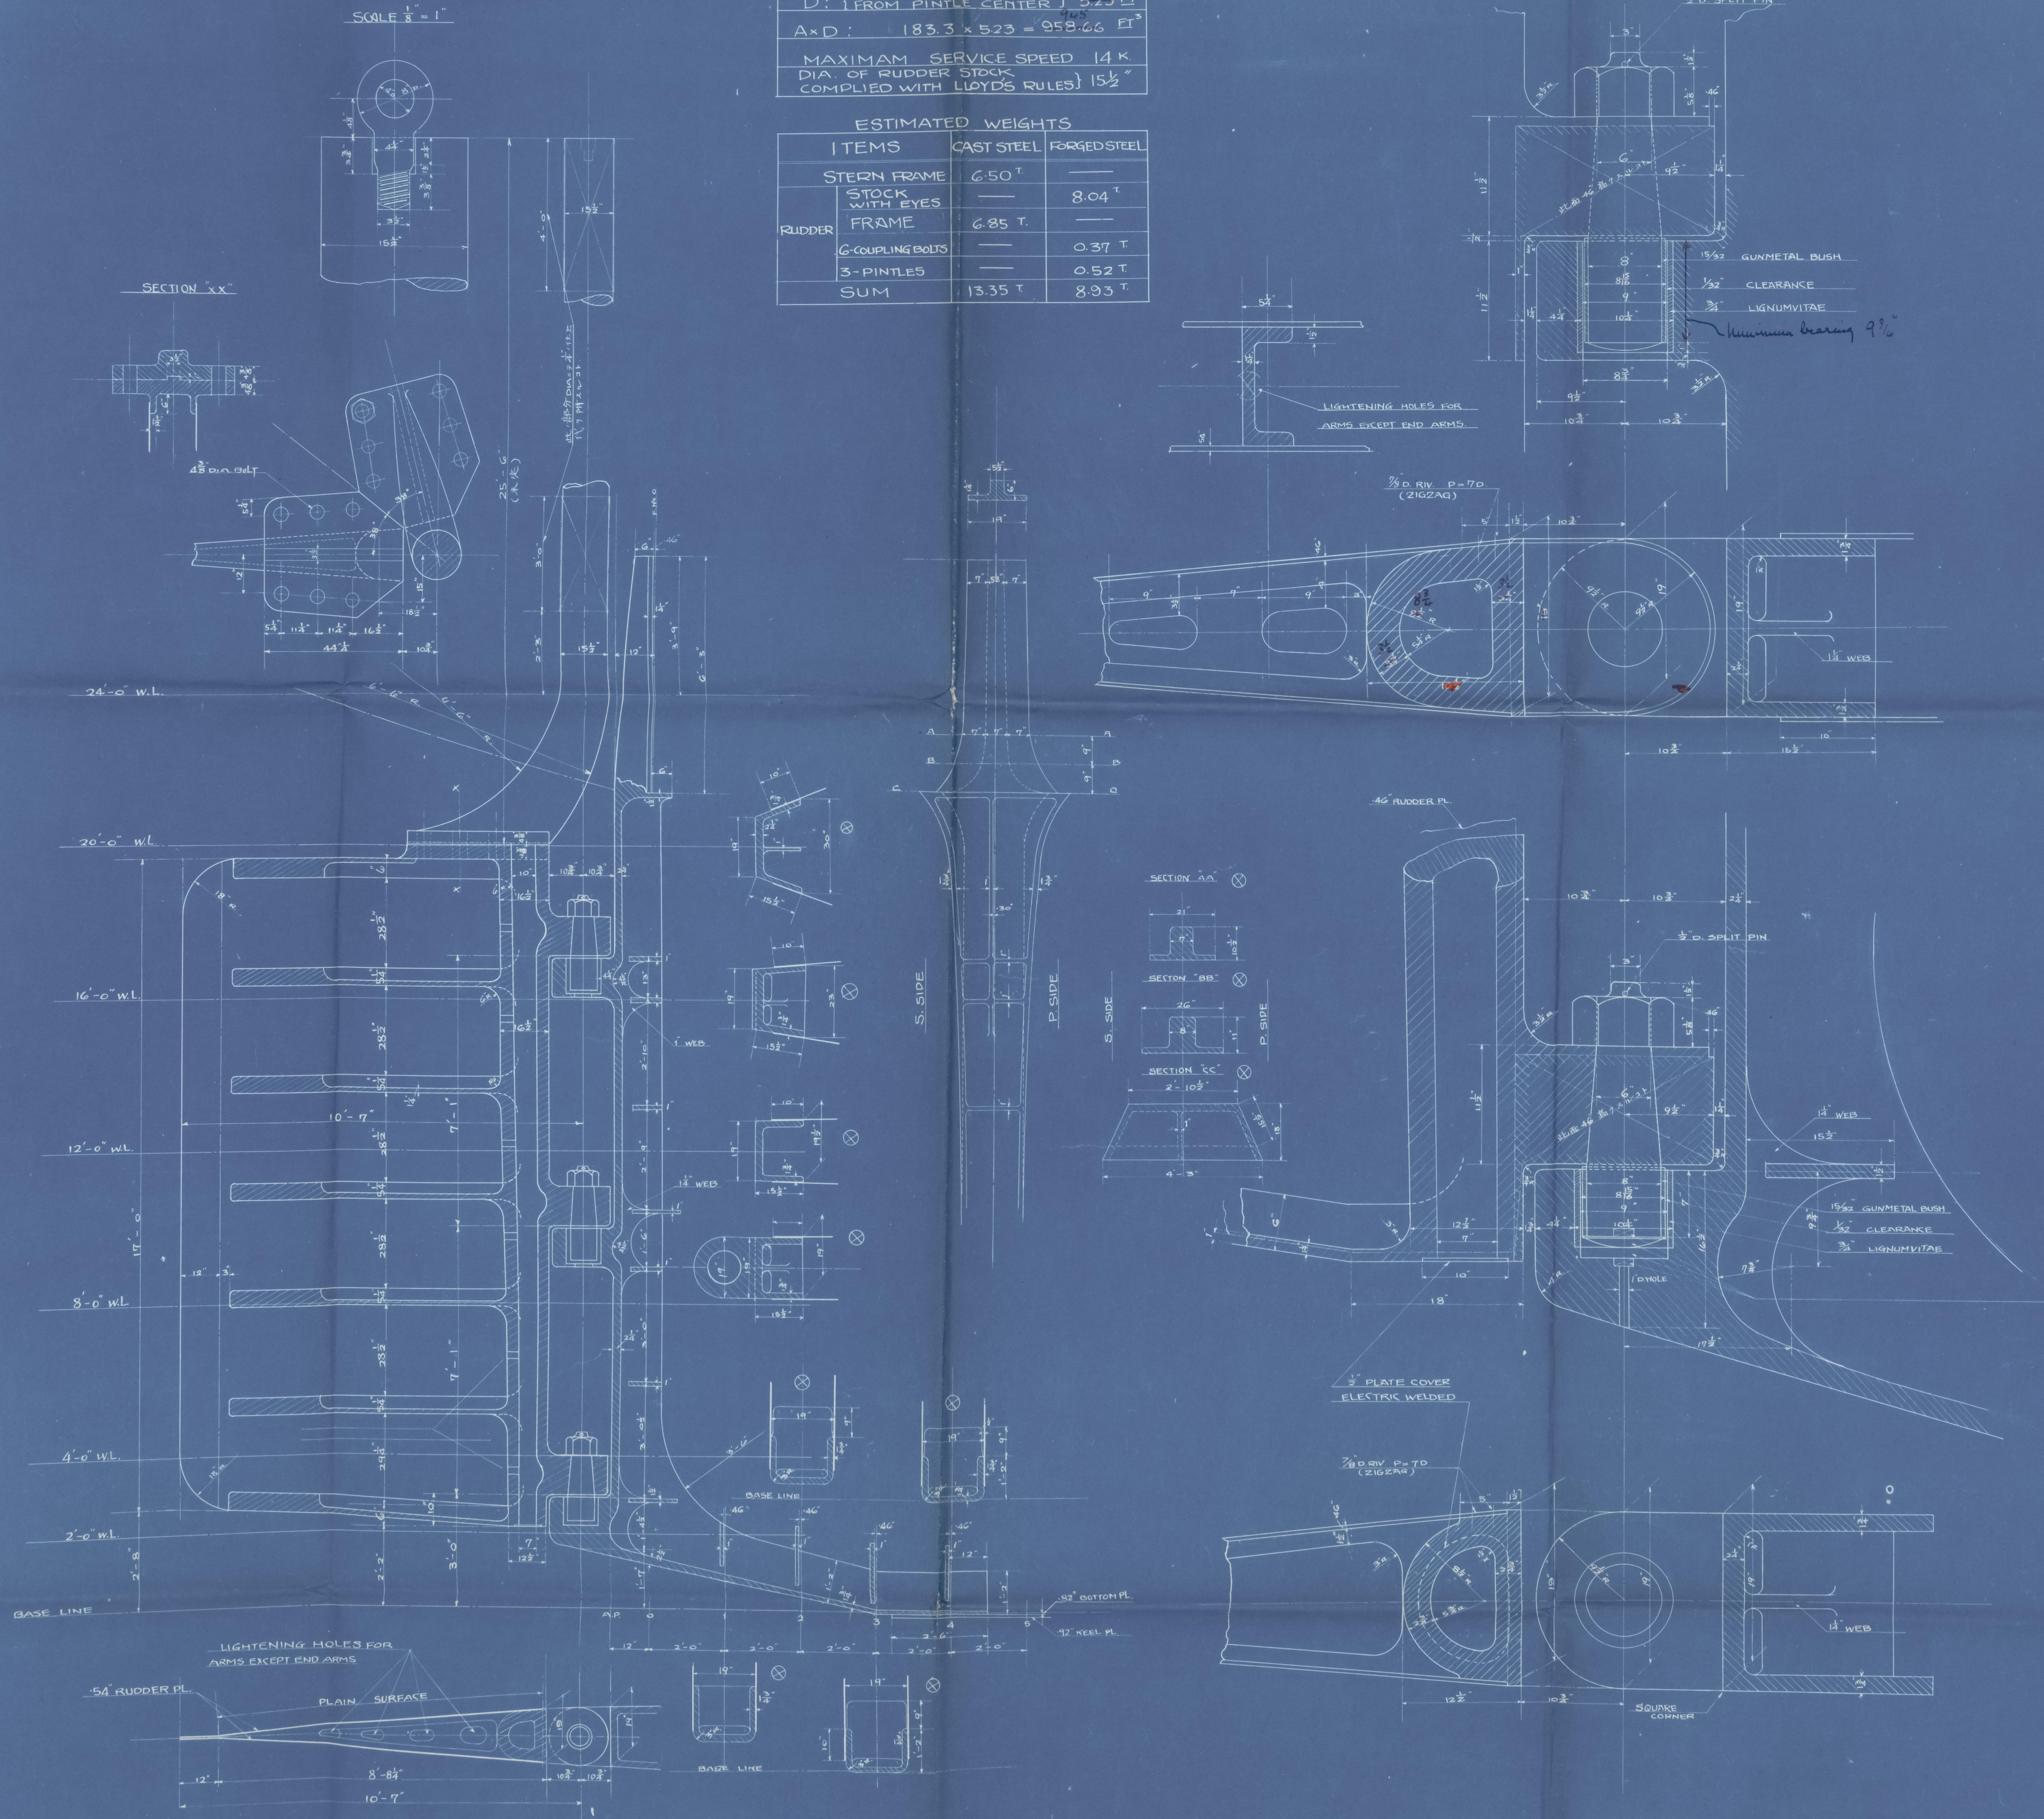


007288-007300-0231



船設  
一八一  
協第  
五  
號

Teigo man  
yka 4694

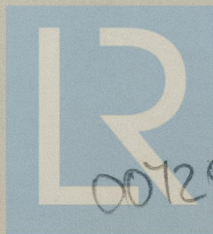

© 2021

Lloyd's Register  
Foundation

001288-001300-0231