

MIDSHIP SECTION

N^{OS}₇ 340K-L-M-N & P.

DIMENSIONS:- 125-0" BP. x 22-6" EX x 13-1" MLD.

SCALE 1/2" = 1 FOOT

CLASSED 100A.1. STEAM TRAWLER.

STEEL

EQUIPMENT.

1. ANCHOR $5\frac{1}{2}$ CWT. EX STOCK.

1. " 5 " " "

1. " $2\frac{3}{4}$ " " "

105 FATHOMS $1\frac{1}{6}$ STD LINK CABLE.

60 " 6" HAWSER.

60 " 42" WARP.

LLOYD'S NUMBERS.

B + D = 35.44

$$L = (B + D) = 4430$$


d = 11-75

$$\frac{5}{0} = 9.5$$

NUMERAL FOR RUDDER. 46.31.

21. 12. 16

CASING AS PREVIOUSLY
APPROVED.

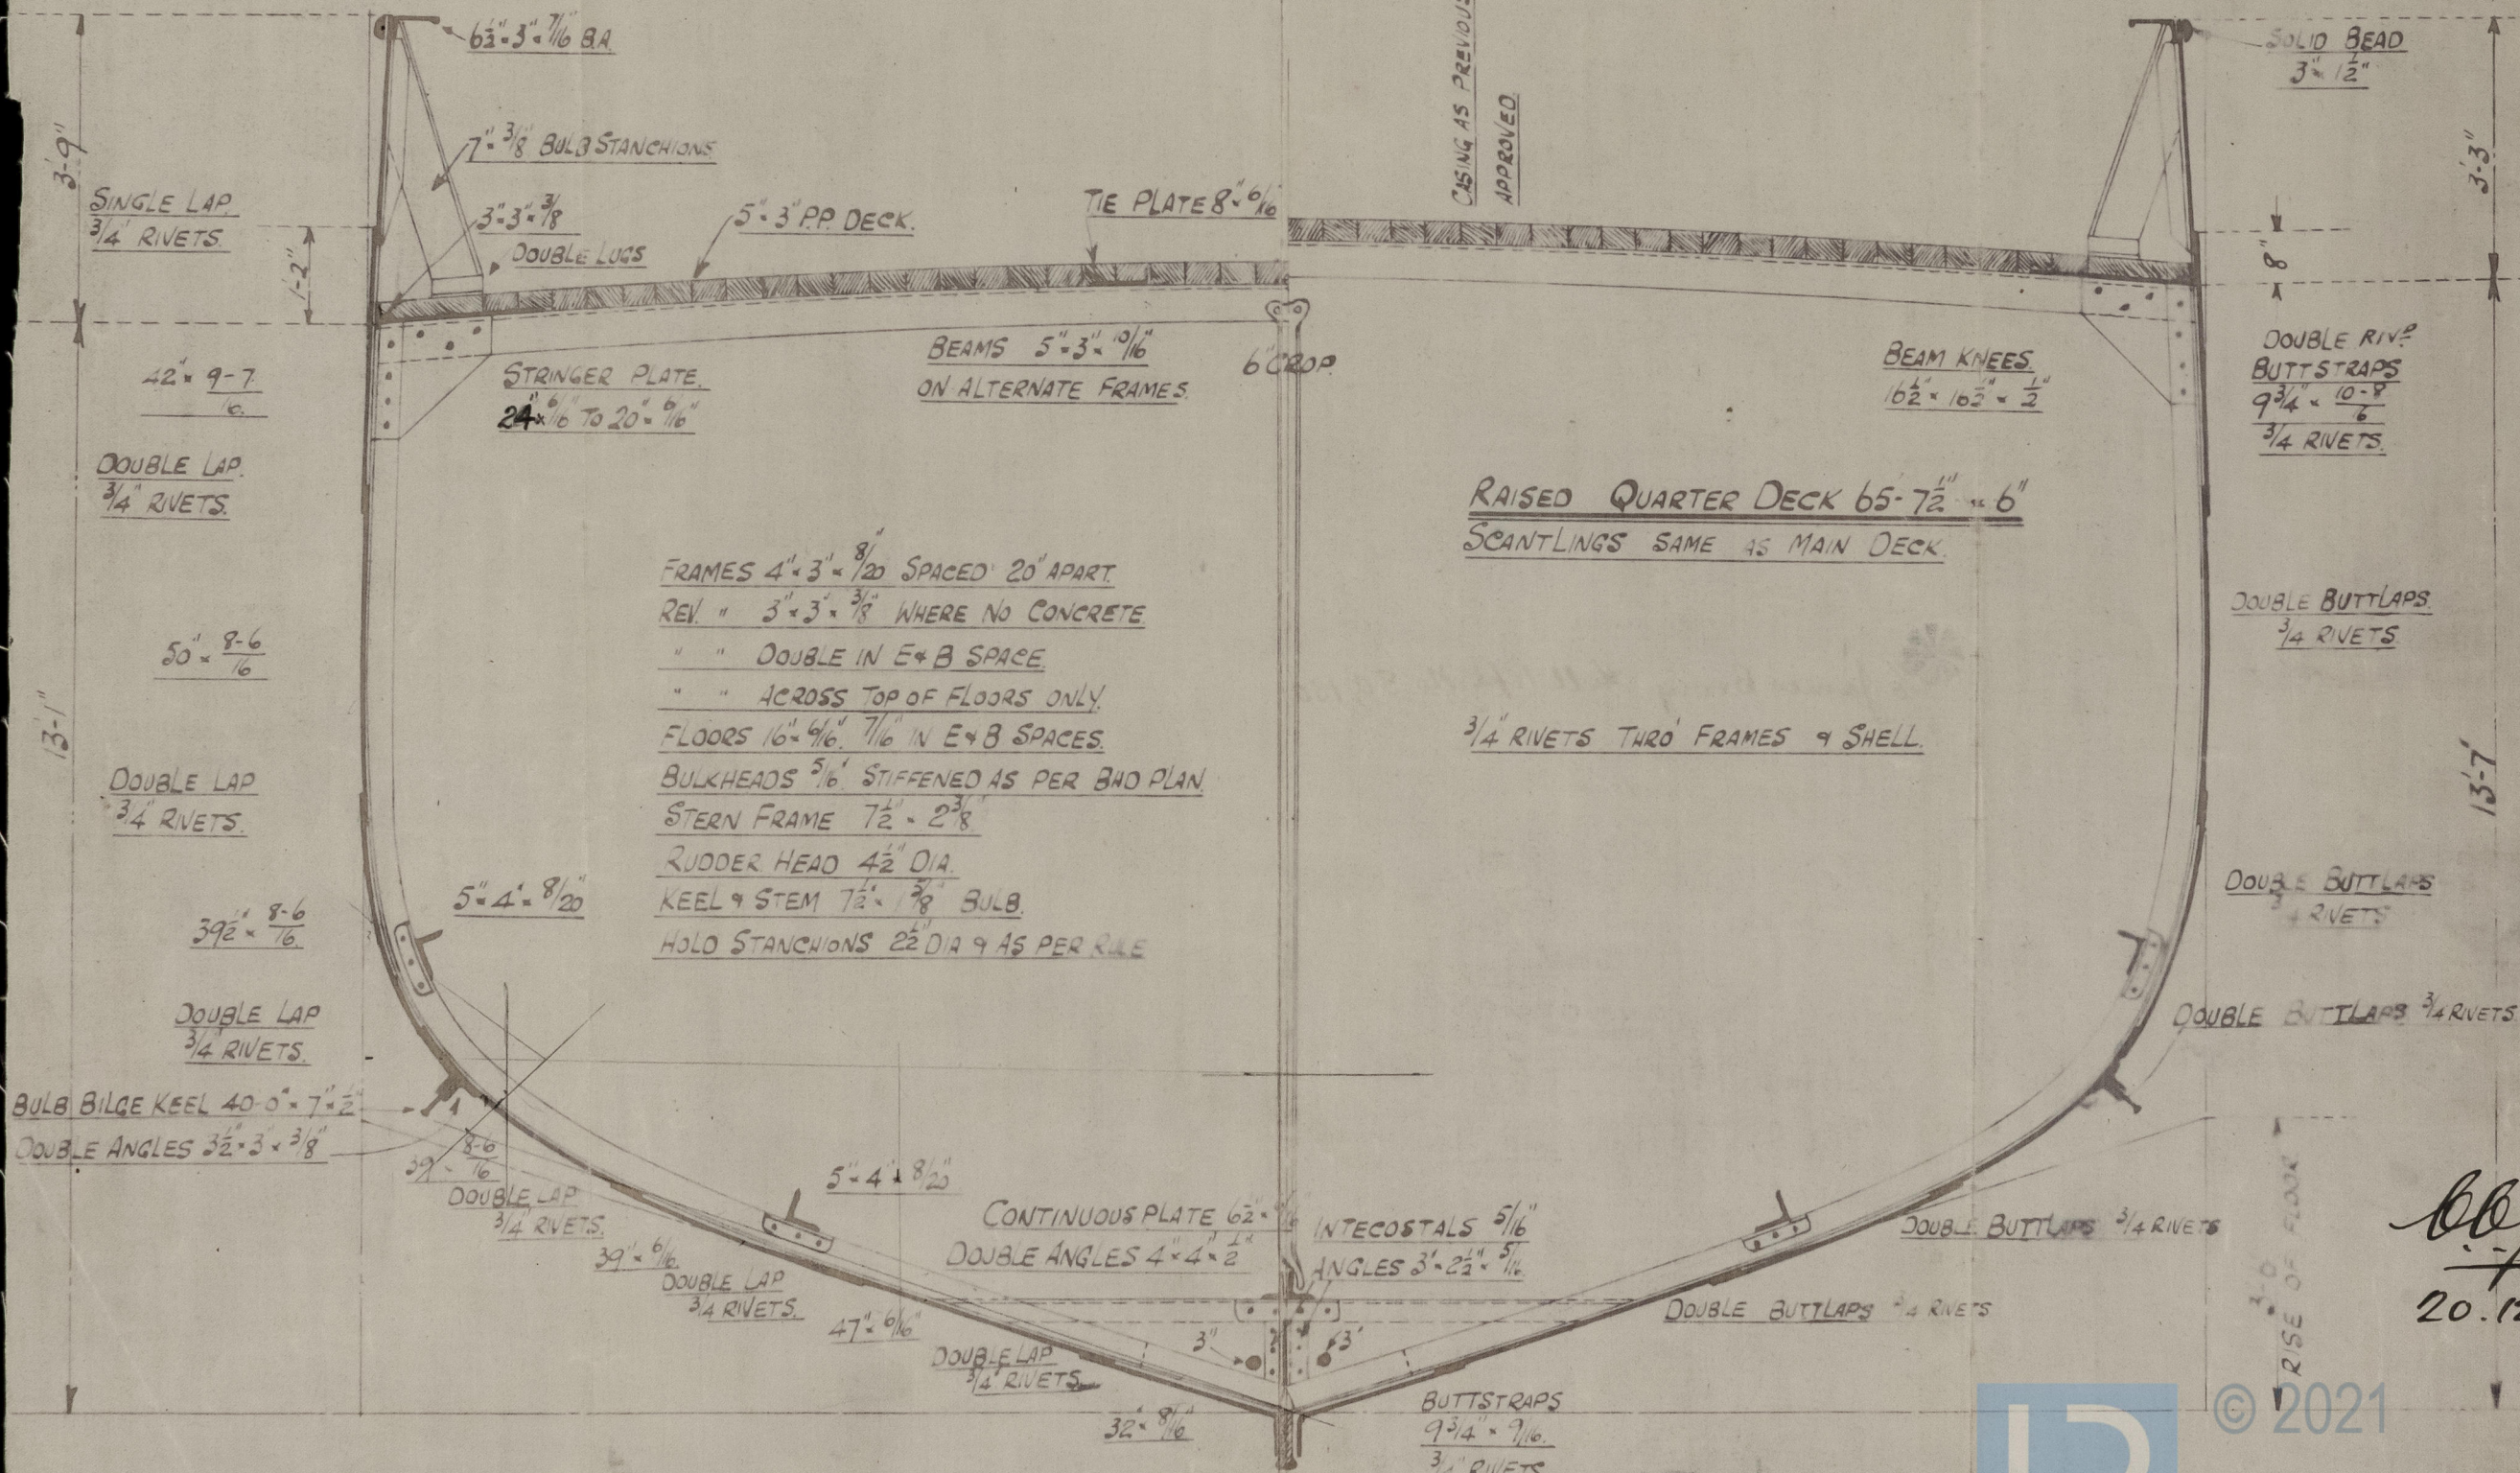

SUBMITTED TO LLOYOS 1916

APPROVED BY LLOYD'S 1916.

20.12.16

© 2021
COOK WELTON & GEMMELL'S ^{TO}
SHIPBUILDERS
BEVERLY


007301-007311-0013

N^o 340 K. L M. N & P.

MIDSHIP SECTION

COOK WELTON & GEMMELL

D113.B

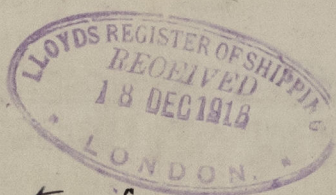

"Montano"
ex


* ^S/_S James Berry. Hull Rpt No 30,130.

L ^S/_S Richard Bagley. Hull. 30164

M ^S/_S John Brooker - 30290

N " Thomas Blackmore - 30311

P " Thomas Blackmore - 30319

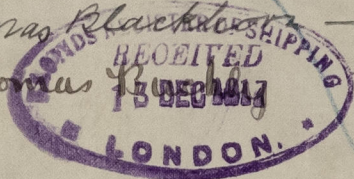

PLANS TRANSFERRED
TO SISTER VESSEL

Loch

Park

© 2021 59

M/M. 7302

LOCH PARK

Lloyd's Register
Foundation

007301-007311-0013