


21.12.16

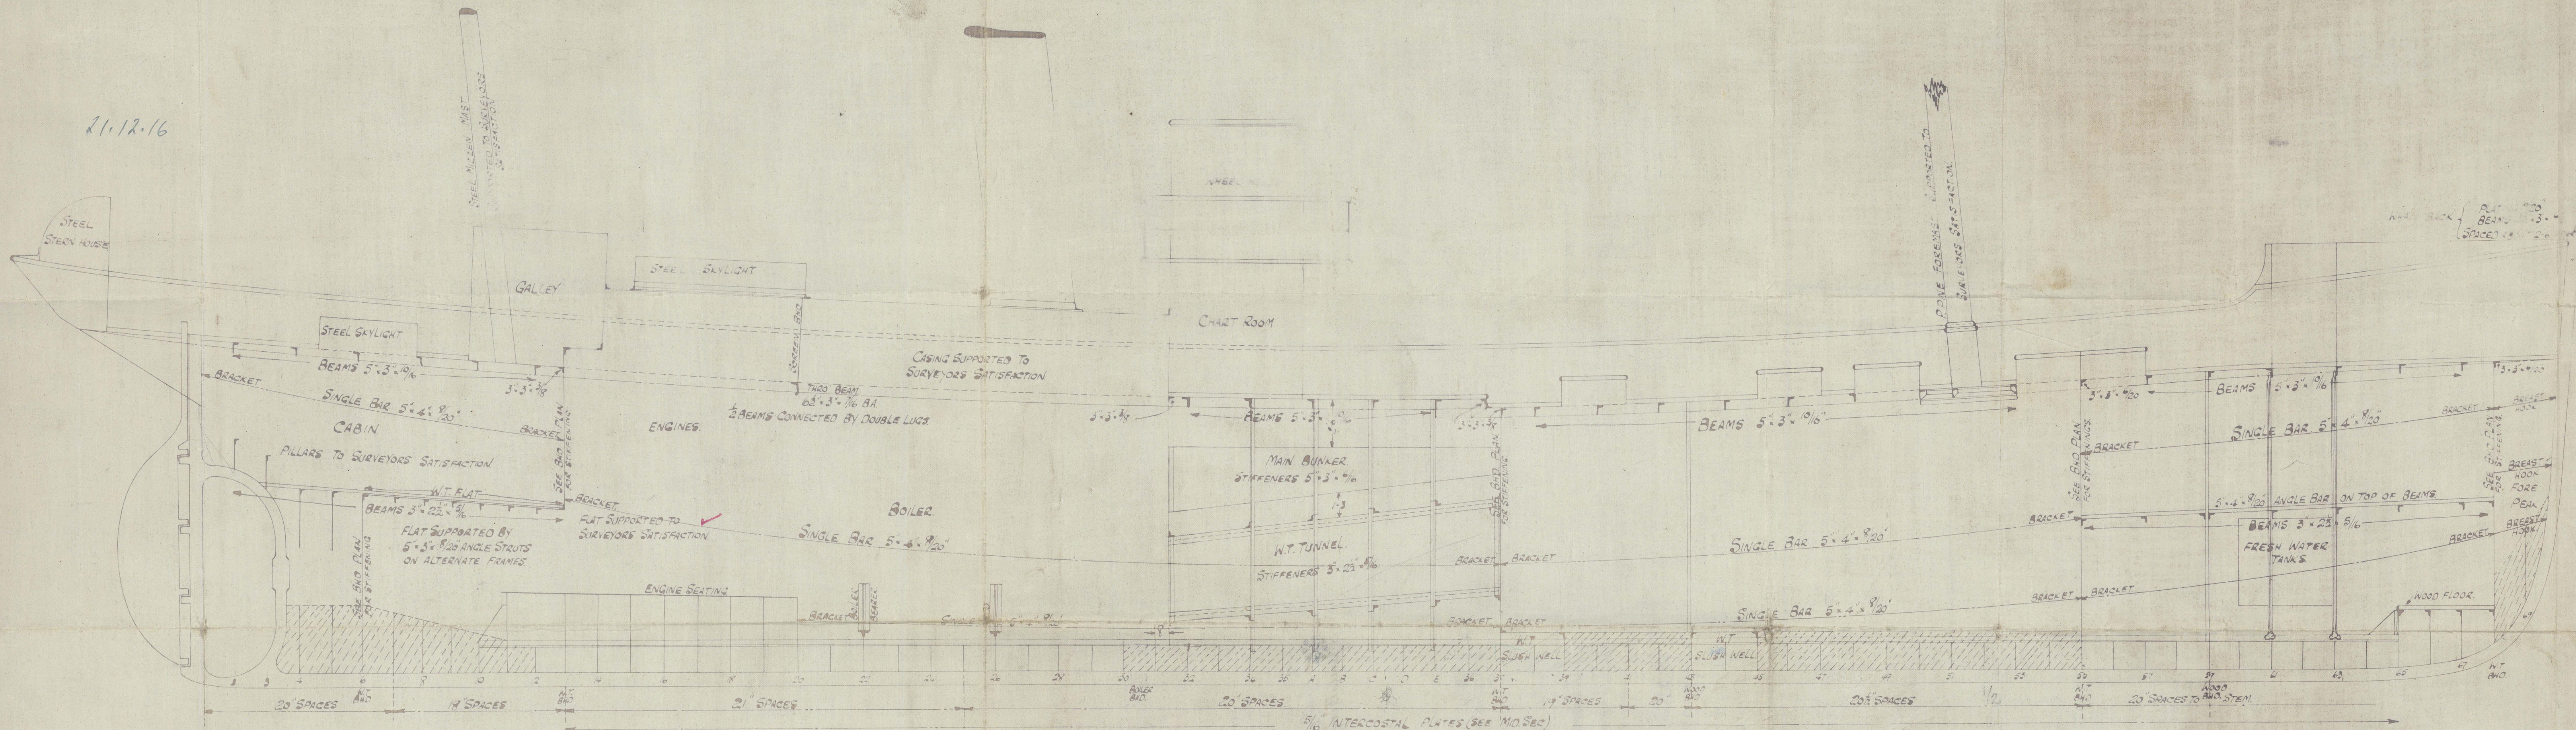

BEAM ARRANGEMENT.


DIMENSIONS:- 125'-0" BP x 22'-6" EX. x 13'1" M.L.O.

SCALE 1" = 1'0"

SUBMITTED TO LLOYD'S 1916
APPROVED BY LLOYD'S 1916

NOS 340K-L-M-N&P.

COOK WELTON & GEMMELL LTD
SHIPBUILDERS
BEVERLEY.
20.12.16.

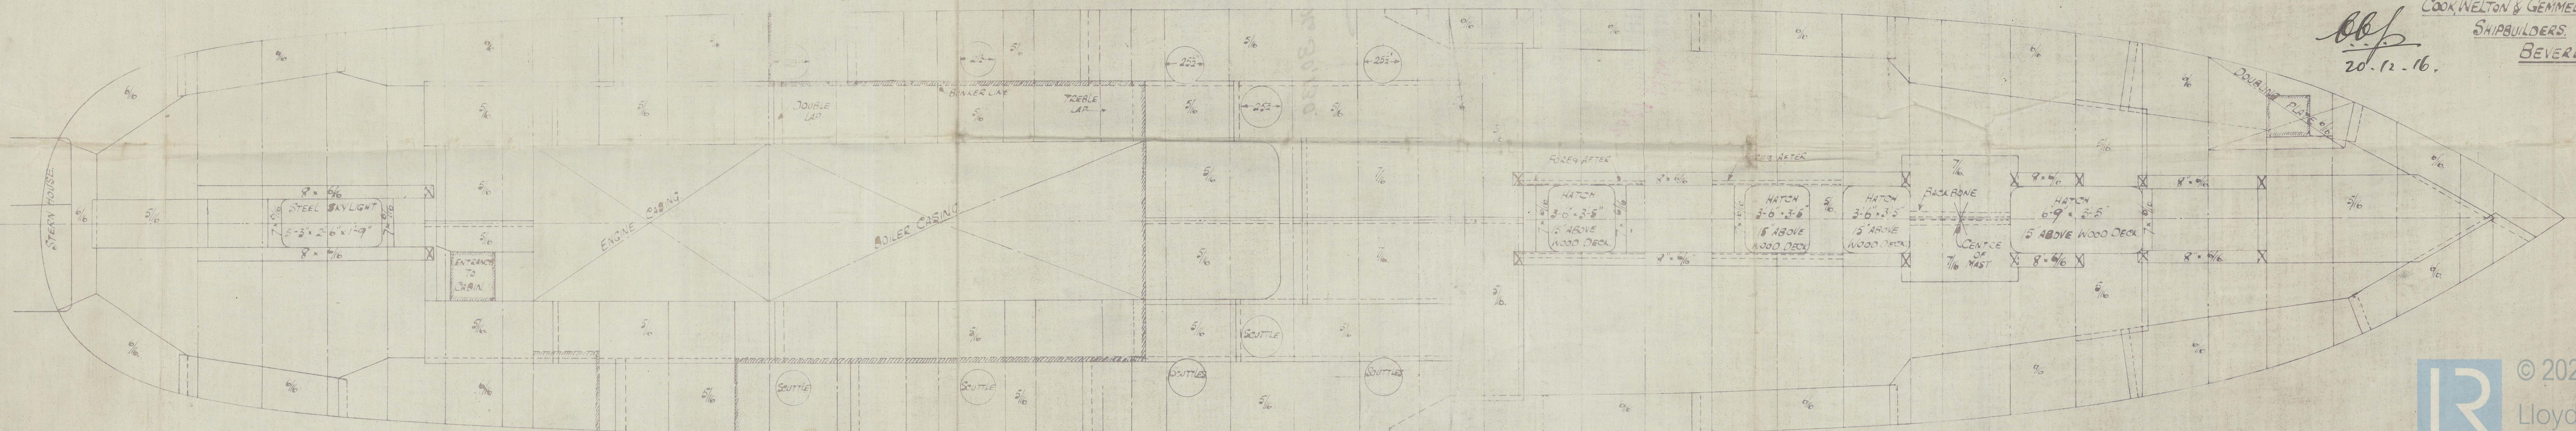


N^o 340 K. L. M. N + P

PROFILE + DECK


COOK WELTON + GEMMELL

Montano

D 113B

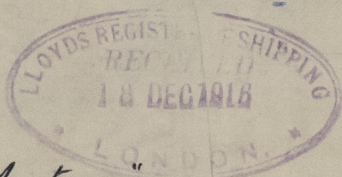

* Montano
ex.
James Berry, Hull Rft No 30,130.

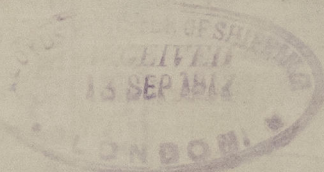

Richard Bagley.

Hull. 30164.

John Brooker - 30,290.

Thomas Blackhorn 30,311

Thomas Buckley - 30,319

PLANS TRANSFERRED
TO SISTER VESSEL

M/M 7302

* Lock Park * Lloyd's Register Foundation

007301-007311-0014