


STERN FRAME, RUDDER
& STEM BAR PLAN.
Nos 20.21+29
SCALE $\frac{1}{2}$ INCH TO 1 FOOT

French
COPY
APPROVED
LLOYD REGISTER OF SHIPPING
JUN 22 1977
NEW YORK
HALLS DR.

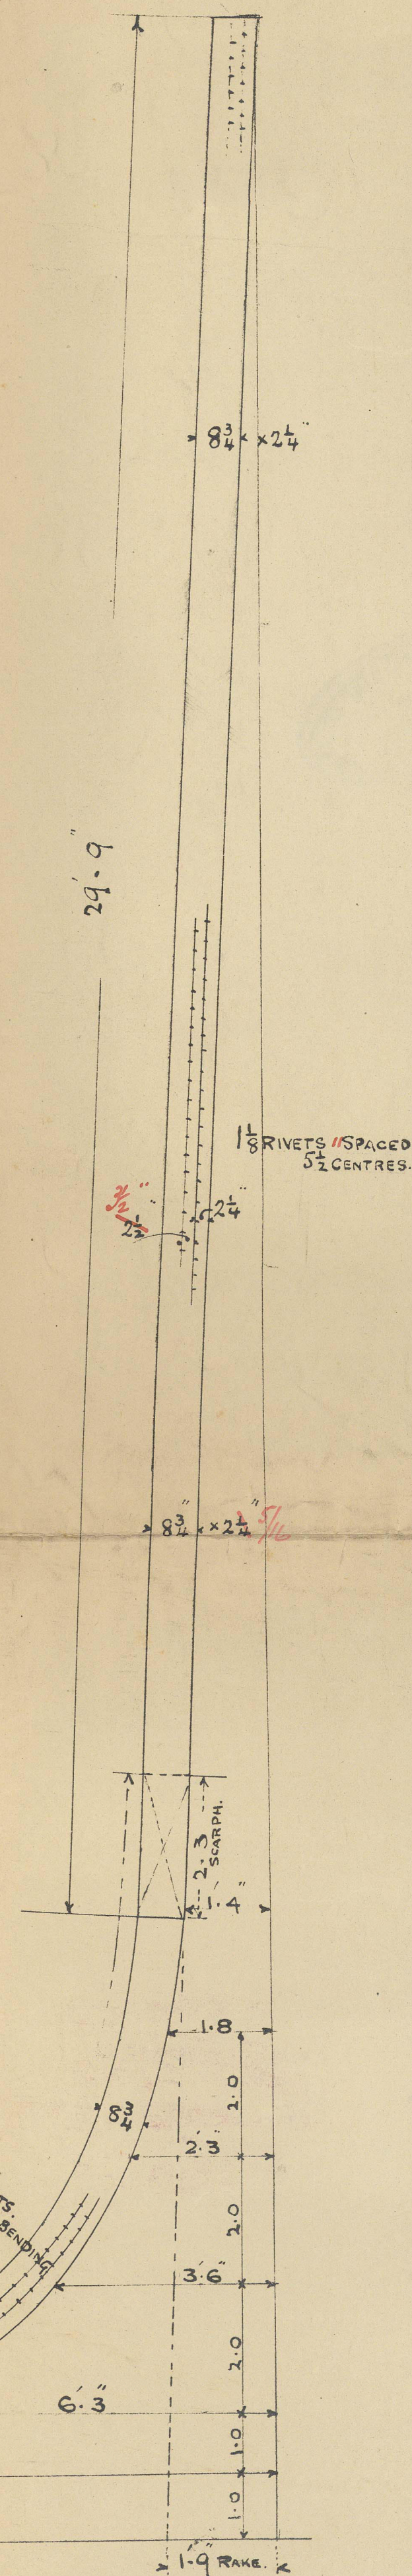


London

CONNECT NO 3 F
5 1/2 x 5 1/2
1" RINGS
SPACED 4 1/2"
19-9" FROM BASE
8 1/2"
1 1/2" FROM EDGE

FROM EDGE

17 1/2

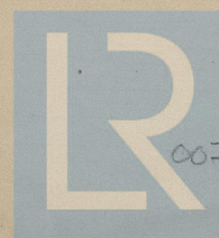

© 2021

Lloyd's Register
Foundation