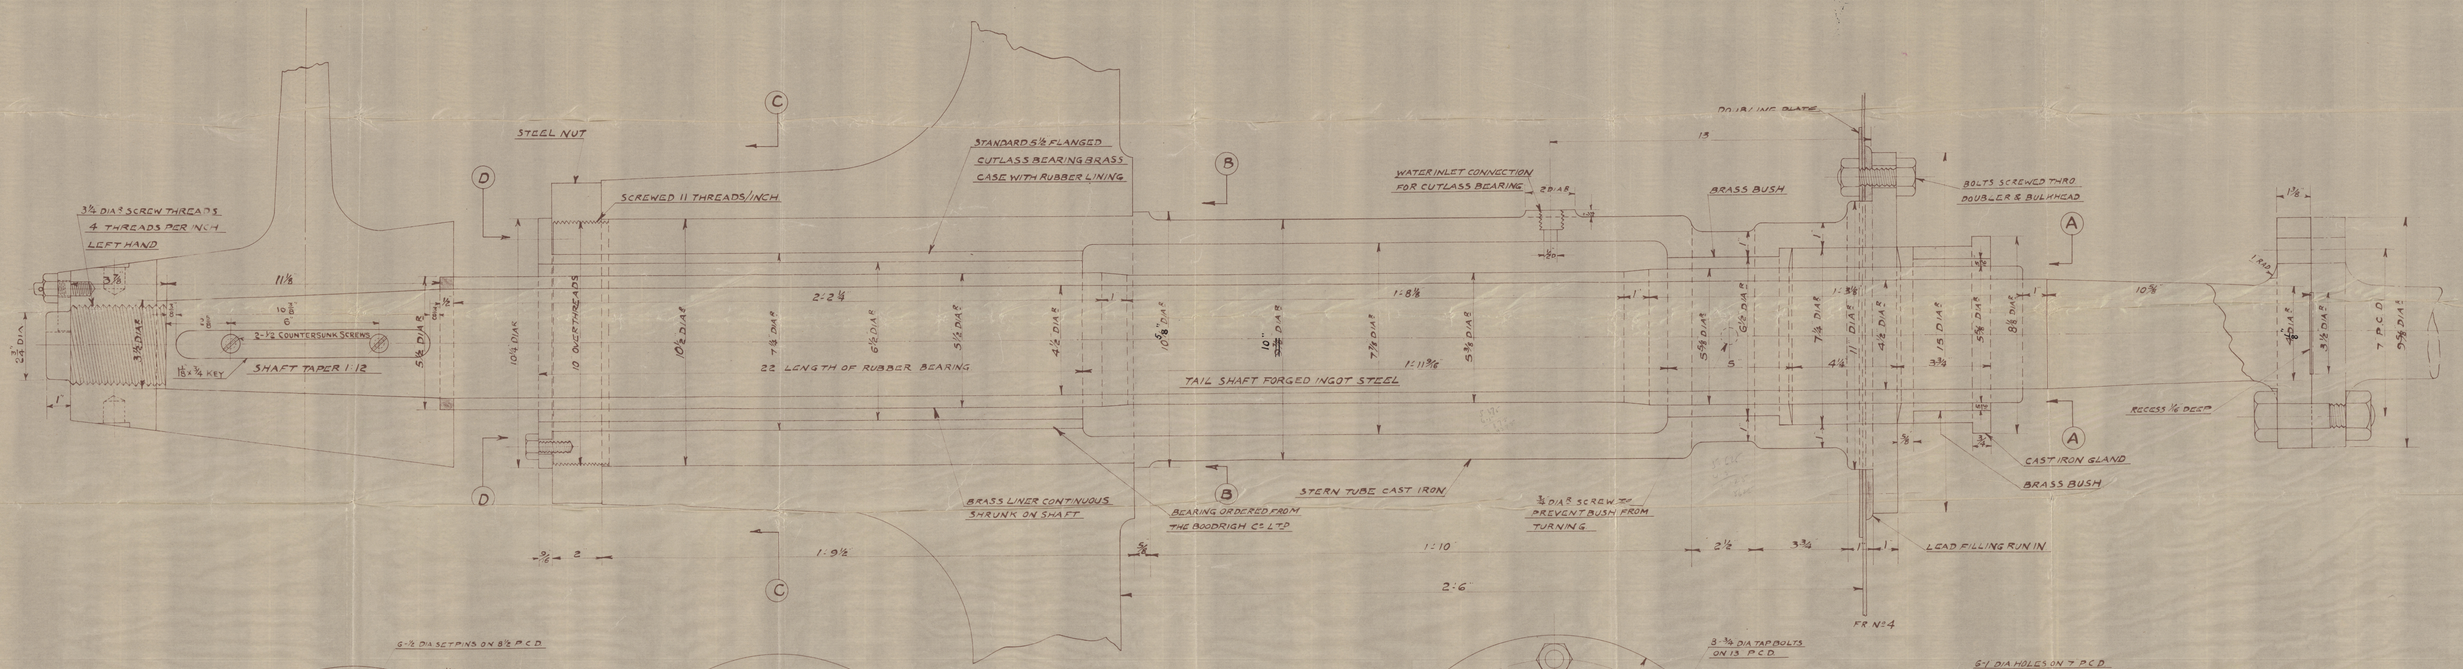

ENGINE Nº 542

SHIP Nº 828

"Invader" H.K. 8521

STERN TUBE & TAIL SHAFT

ONE THUS

SCALE — HALF SIZE

APPROVED
LLOYD'S REGISTER OF SHIPPING
SEP 20 1939
KOBE

Lloyd's Register
GENERAL DRAWING OFFICE
DATE 28 AUG. 1939

H.K. & W. DOCK CO. LTD.
DRAWING Nº 1519

Lloyd's Register Foundation