


H-28-N-10

21.7.73. 007312-007323-0153



Section
Design N^o 458-H.
Nagasaki
J. S. S. "TOYOOKA MARU"
N^o 242
Nagasaki Reft. N^o 980

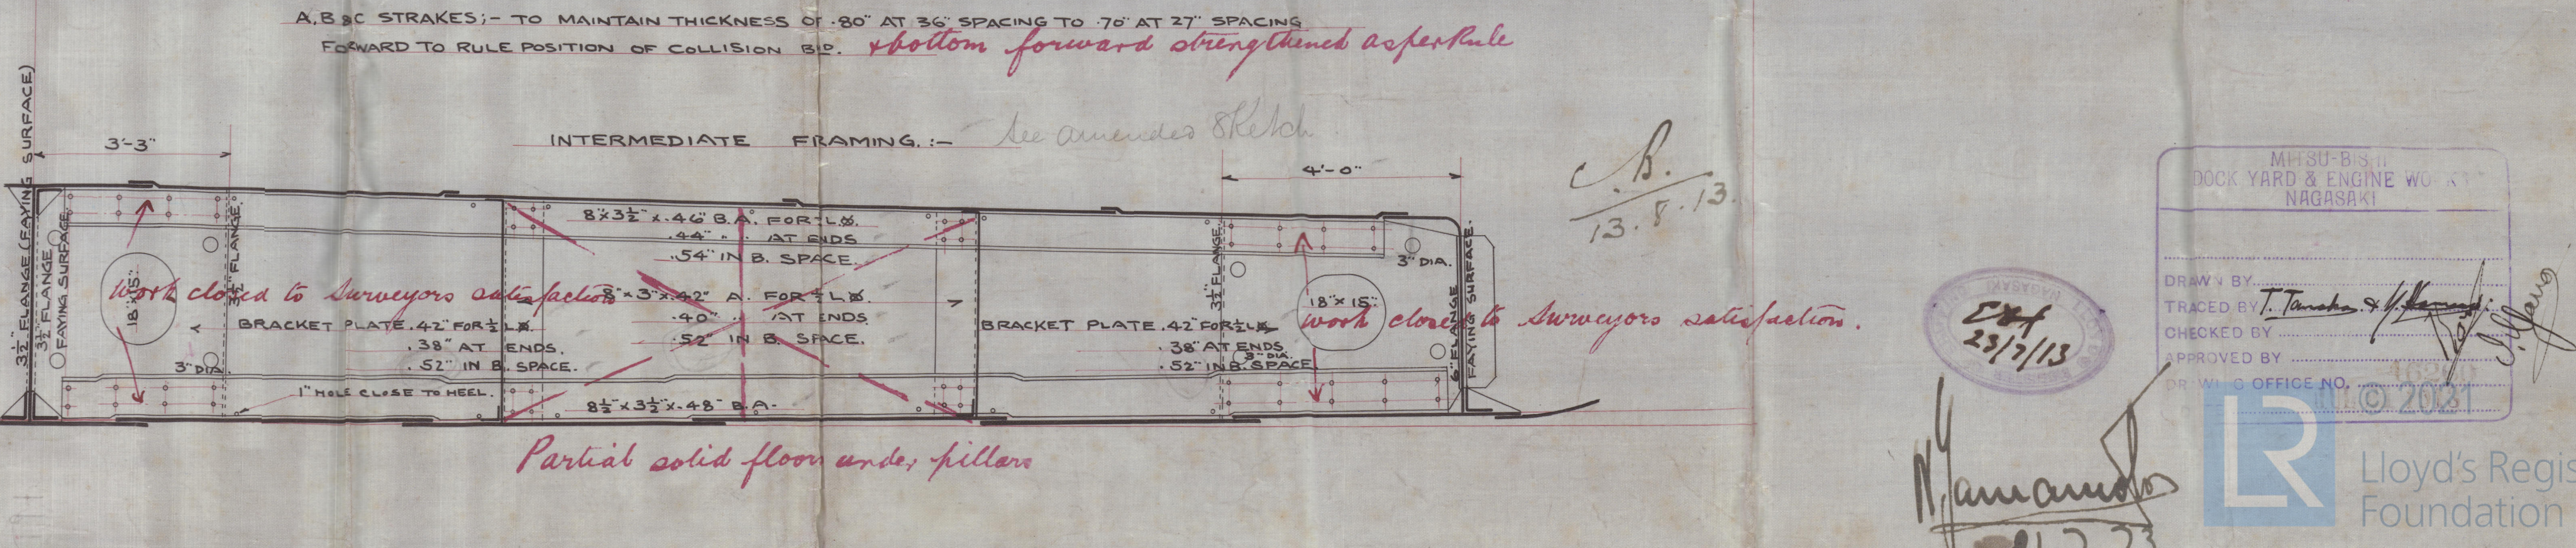

© 2021

Lloyd's Register
Foundation

007312-007323-0153