

2.10.13




Handwritten notes and stamps in the top left corner, including a circular official stamp.

S.S. NOS 242-3. (D. NO 458 H.)

ALTERATION OF CONSTRUCTION PROFILE & DECK PLAN.

SCALE $\frac{1}{8}$ INCH TO ONE FOOT

NOTE - ALTERATIONS SHOWN IN RED LINE

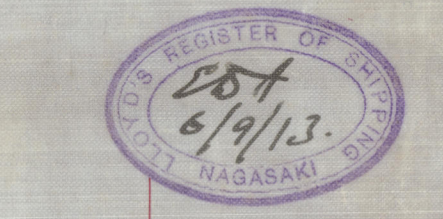 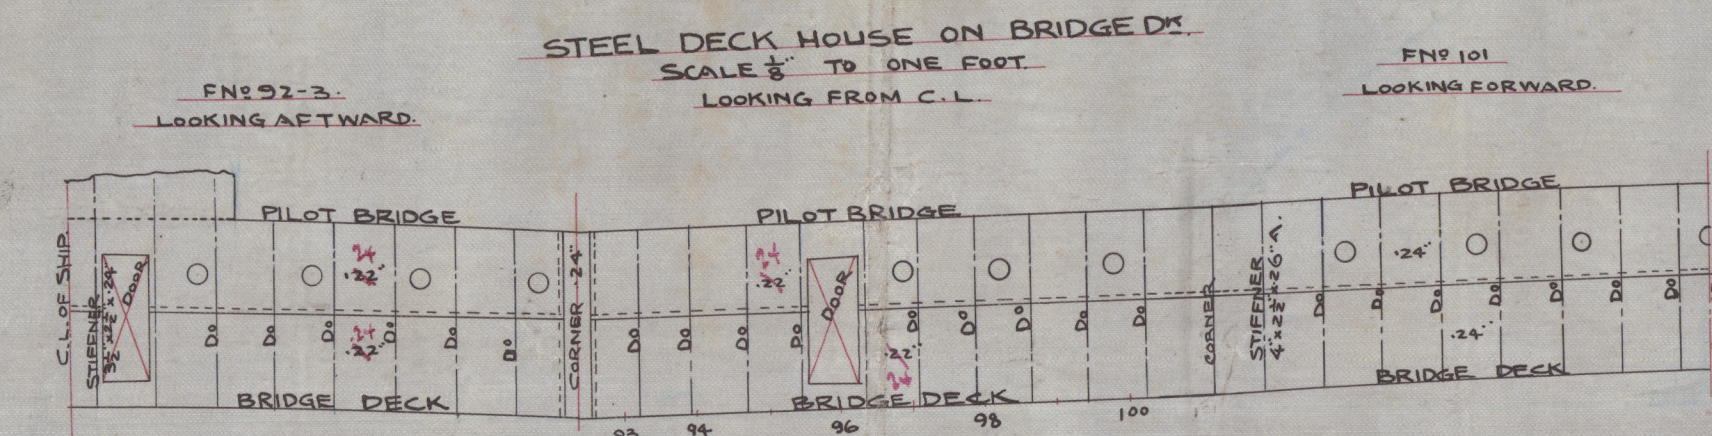


Handwritten signature and date: 6.9.13

Profile
242-3
Design N^o 458.H
Nagasaki
alteration

S.S.S. TOYOOKA MARU

Nagasaki Regt N^o 980

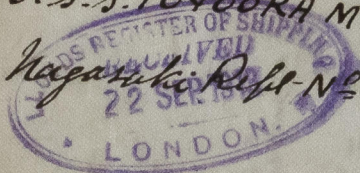

© 2021

Lloyd's Register
Foundation

007312-007323-0154