


ALTERATION OF CONSTRUCTION PROFILE & DECK PLAN.

SCALE $\frac{1}{8}$ INCH TO ONE FOOT.

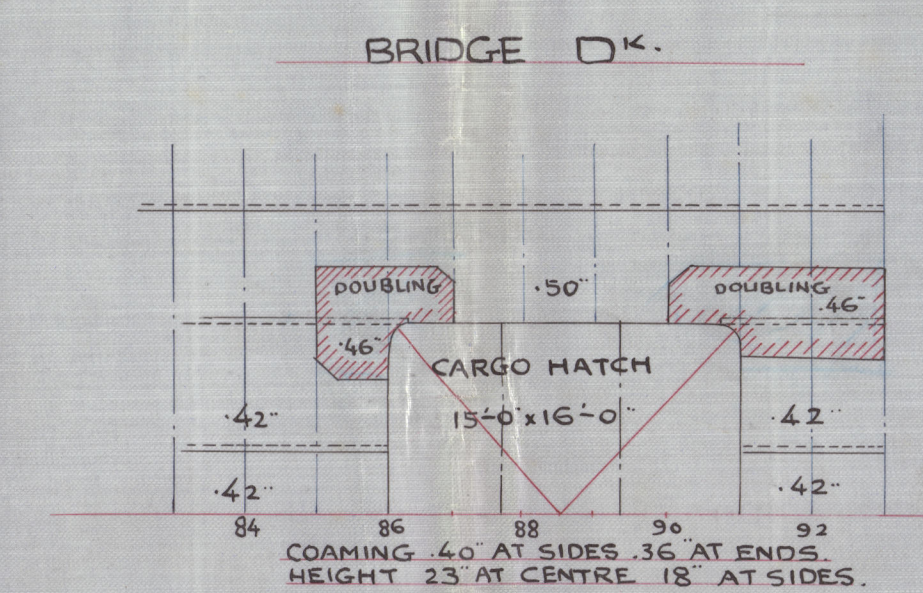

MITSUBISHI
DRAWN BY *M. Tanaka* 10/26
FILED IN
Manamichi
19. 3. 74.

242-3

Alterations

Profile

J. S. S. "TOYOOKA MARU"

Nagasaki Repl: N^o 980



© 2021

Lloyd's Register
007312-007323-0156
Foundation