


1:50 & 1:15 7-2-30  
EH

007324-007333-0081



ALTERATIONS AFTER END.

HOXY SAILING SHIP POMORZE

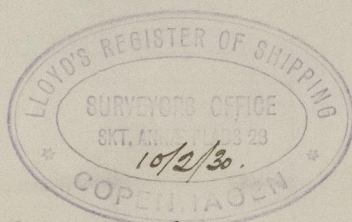

Cum. Rpt. No 8282.



© 2021

Lloyd's Register  
Foundation

007324

007324-007333-0081



5 x 2  
15 x 6 x 14  
150 x 14  
2100  
170  
40

