


NOTE:- PILLARING THROUGHOUT TO BE TO SURVEYORS SATISFACTION.

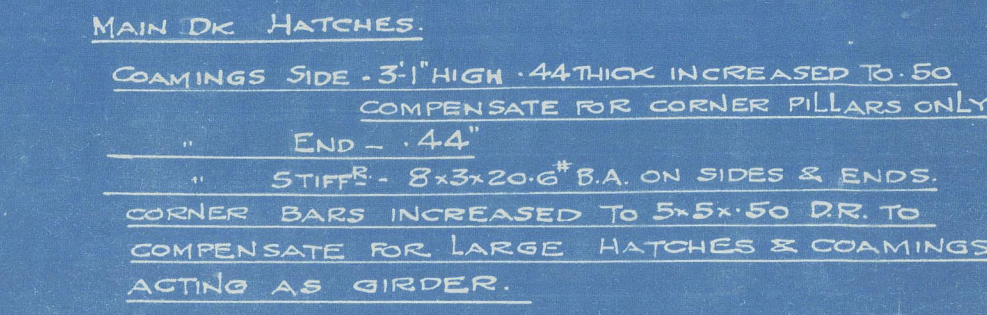

Drawn by.....	Date.....
Traced by.....	Date.....
Checked by.....	Date.....
Approved by.....	Date.....

HULLS No 5-6-7-8  
DRAWING NO. 1<sup>B</sup> Scale = 1/8" = 1 FOOT



Pope + Dks

1/2 Canadian Siltb

"Yendai Maru"

Sister to "Banashin Rancher"

RETAIN

© 2021

Lloyd's Register  
Foundation

007342-007351-0248