


# NO. 183 STERN FRAME & RUDDER SCALE 1/2" = 1'-0"

TEISHINSHO'S & LLOYDS TEST CERTIFICATE REQUIRED

A. 115.24"  
D. 2.36'  
A x D. 272.00  
SPEED 14 K. UNDER

MATERIALS  
STERN FRAME CAST STEEL  
ARMS & MAIN PIECE  
RUDDER HEAD & PINTLES FORGED STEEL

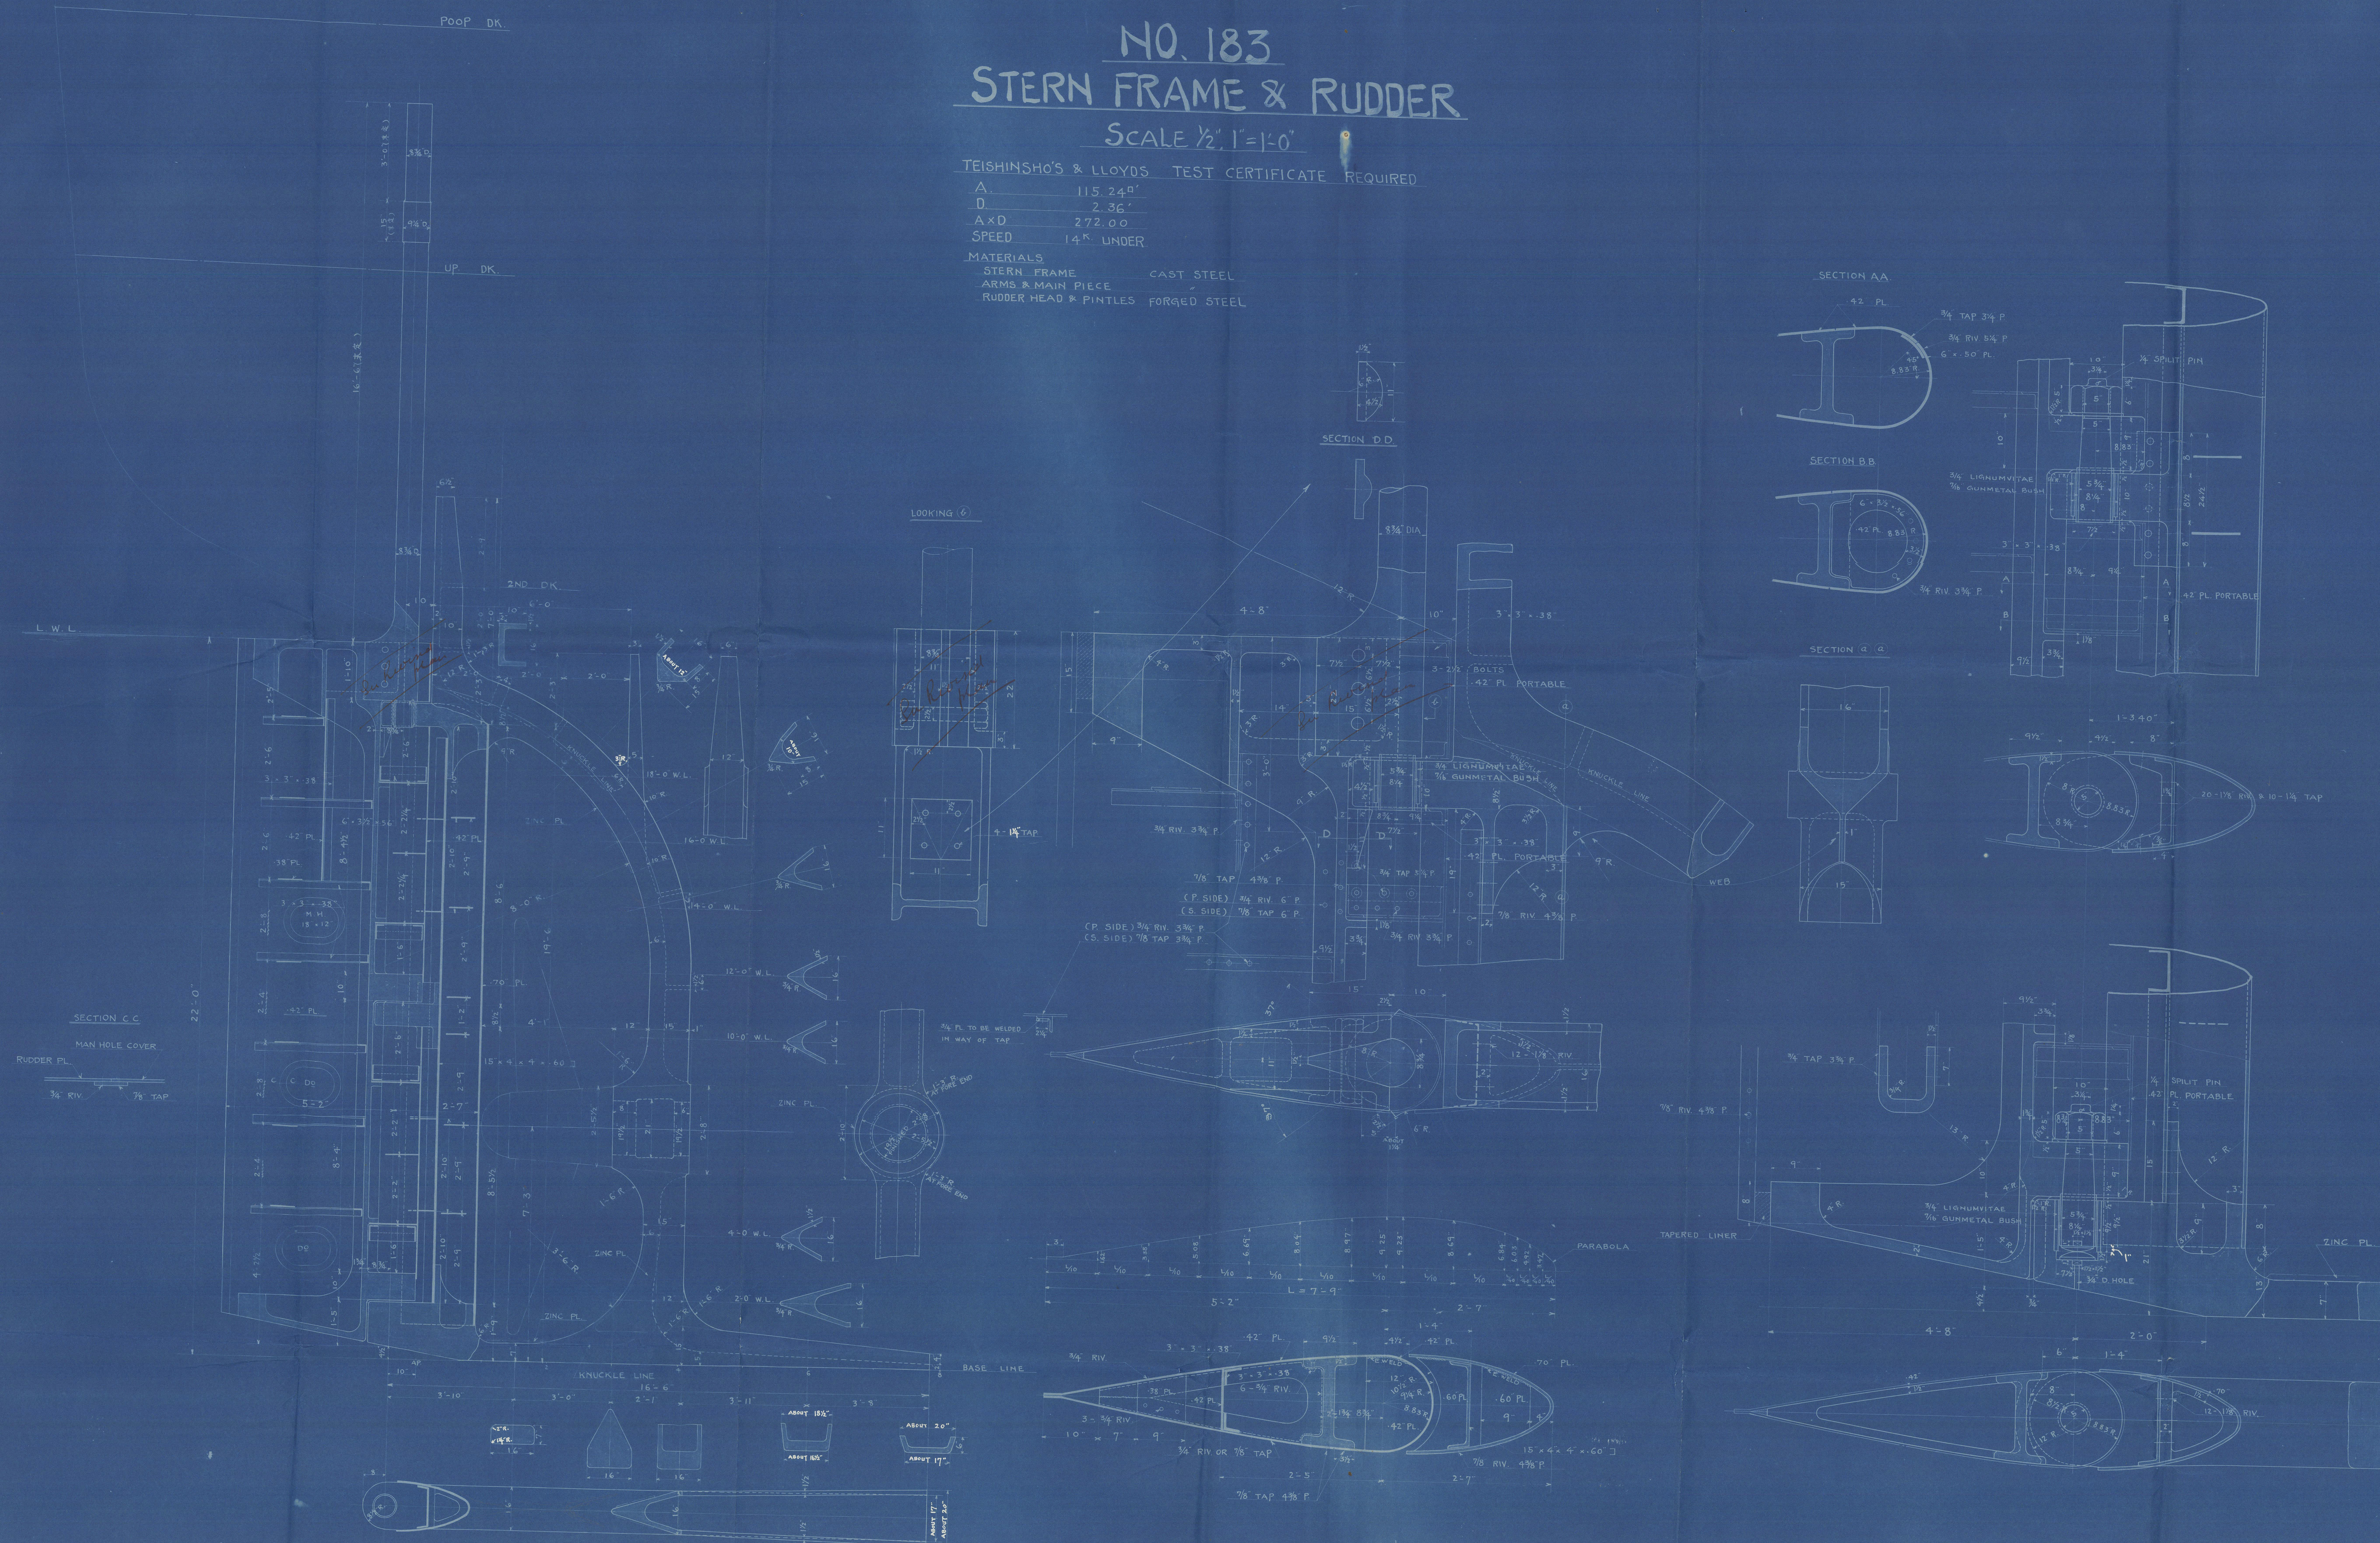

APPROVED  
FEB 1 1911  
ROBE

PL. NO. 7





*Handwritten:* "Watisan Maru"  
M/V "NACHISAN MARU" <sup>ex</sup> Kob. 7609.  
YARD NO.183

Sternframe & Rudder



© 2021

Lloyd's Register  
Foundation