


46 183
GEN. BOX NO 1107
Profile alk.

NO. 183
CONSTRUCTION PROFILE DECKS
& INNER BOTTOM
SCALE 1/8" = 1'-0"

N. B. ALL BULB ANG. & CHANNEL TO BE
"GERMAN STANDARD 1927 SECTION"

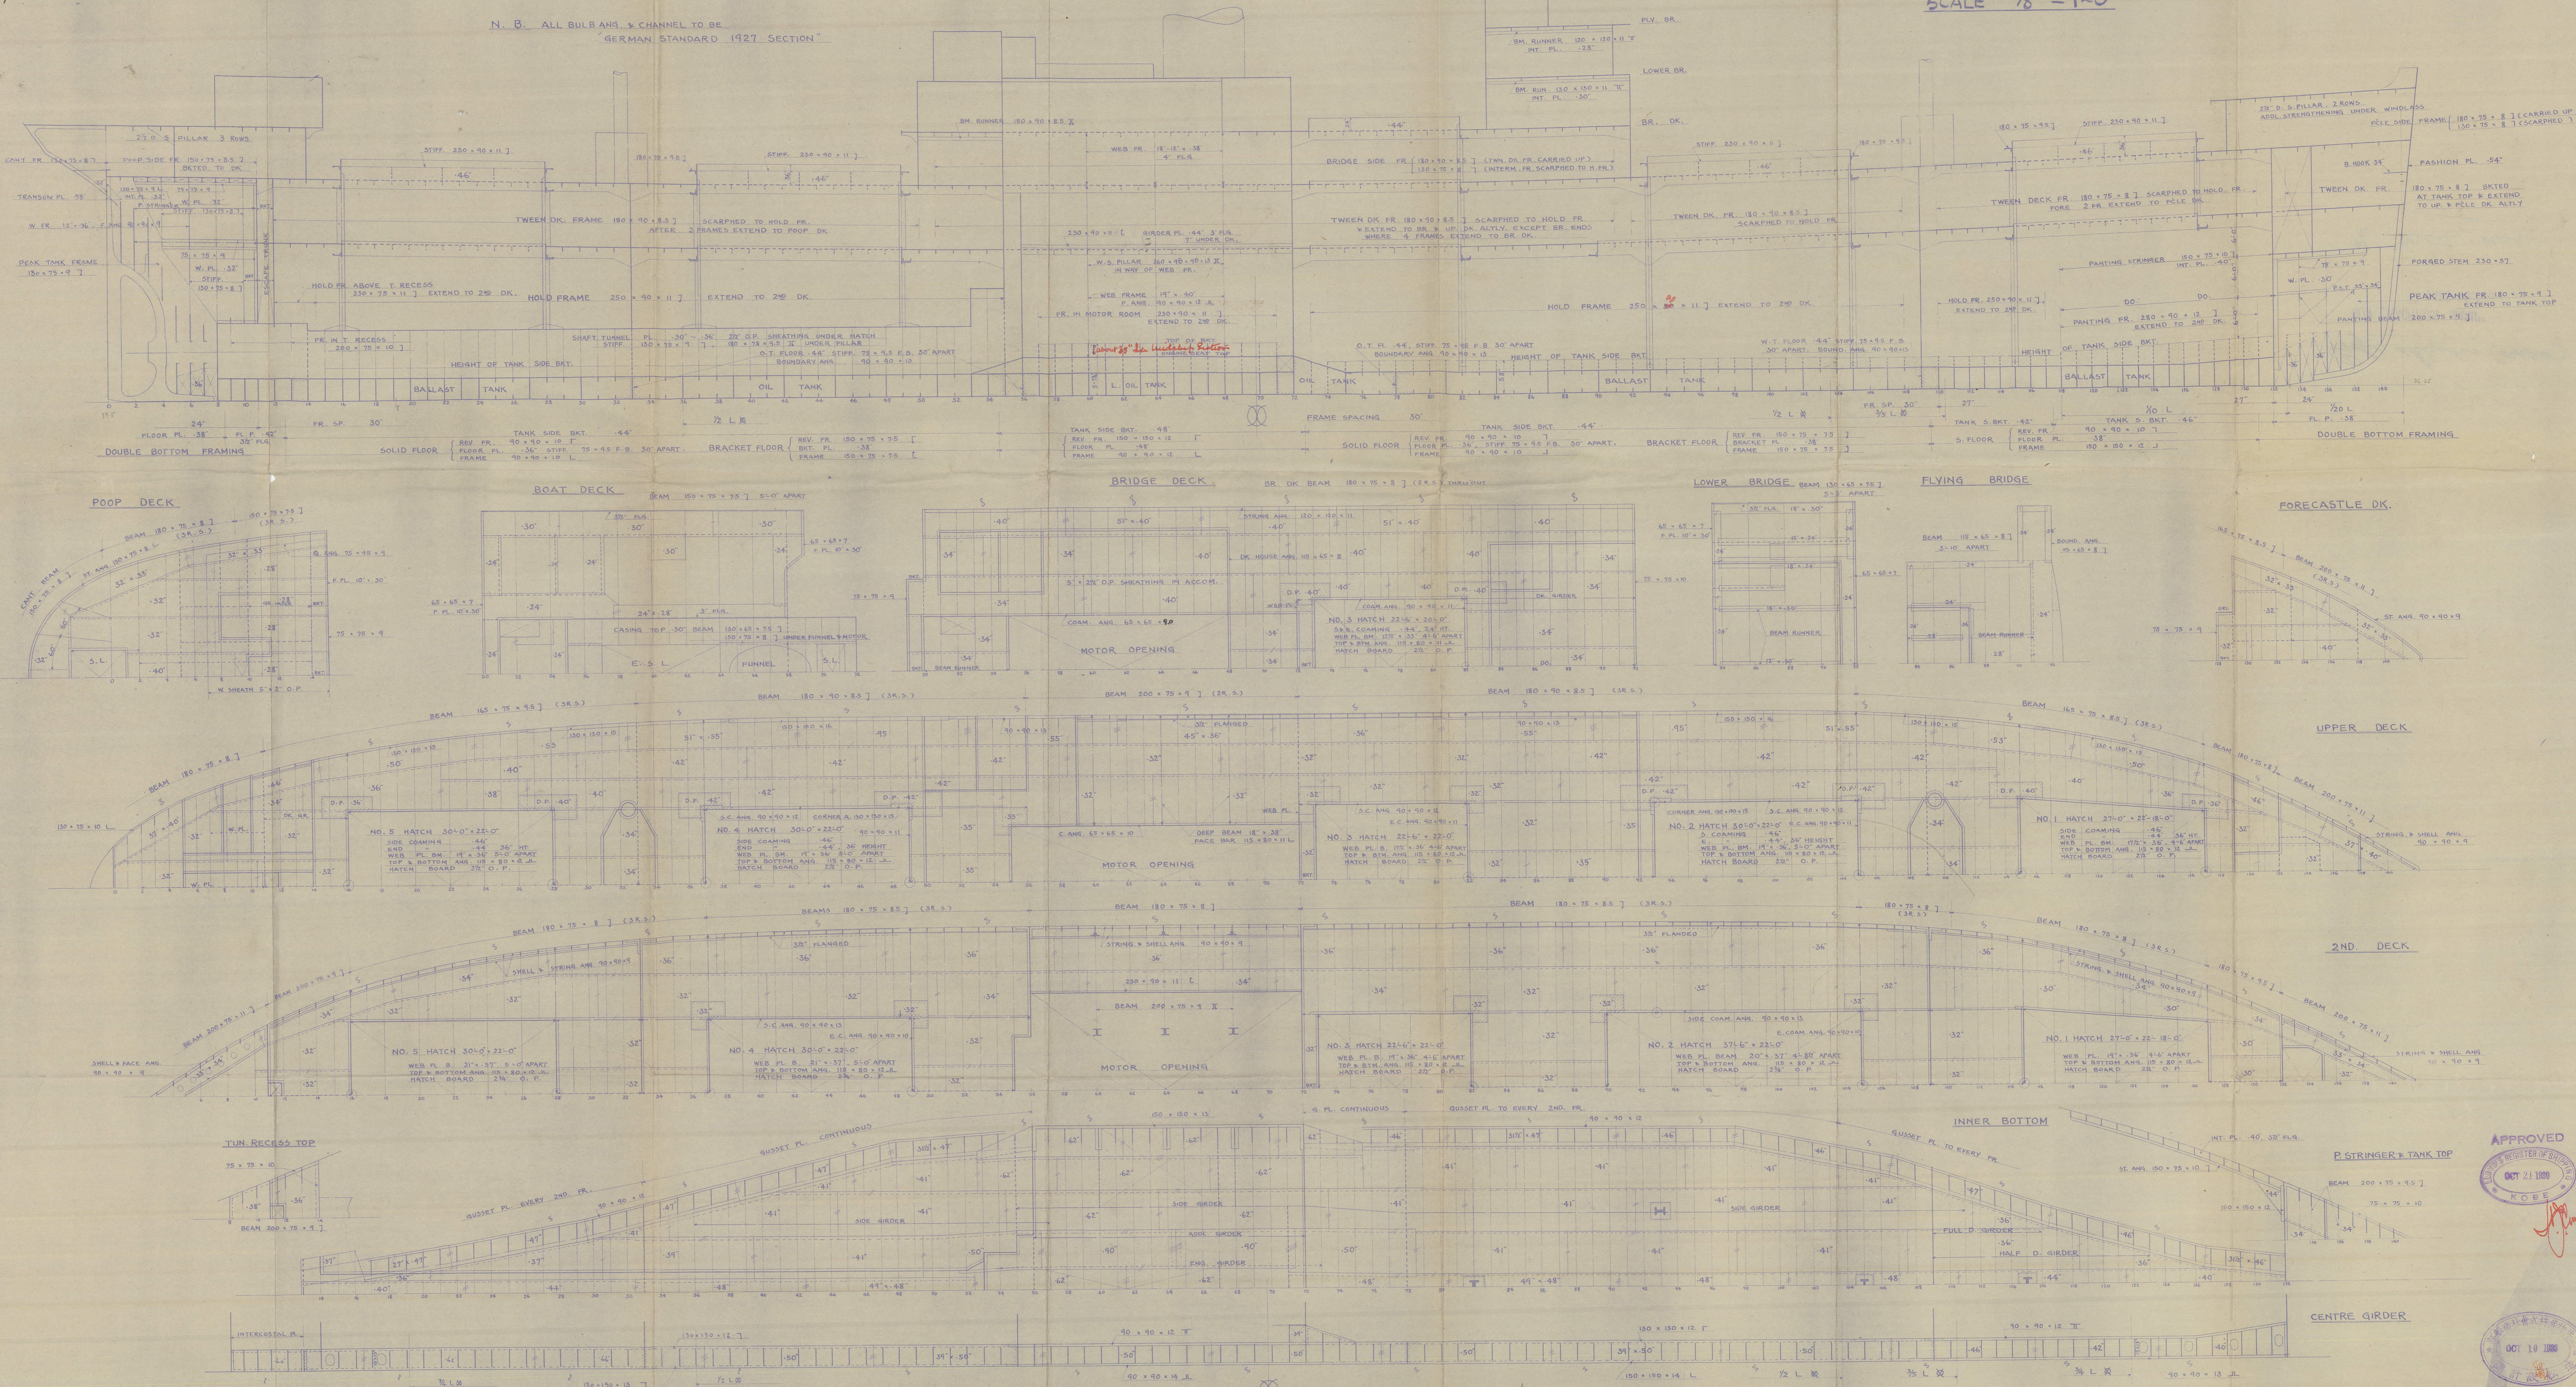

APPROVED
REGISTER OF SHIPS
OCT 21 1930
Kobe

APPROVED
REGISTER OF SHIPS
OCT 10 1930
Kobe

Profile sheets (appos)

M/V "NACHISAN MARU"
YARD NO. 183

1/1 "Matsun Maru"



© 2021

Lloyd's Register
Foundation

007352 007352 0067