



MIDSHIP SECTION.

LBP 351-0, BM 52-3, Bx 52-6, DM 29-4

SCALE 1/2" = 1 FOOT

COPY OF PLAN APPROVED BY LLOYD'S 13.19. & 26.19.

S.V. 17.3.19 & 7.7.19.

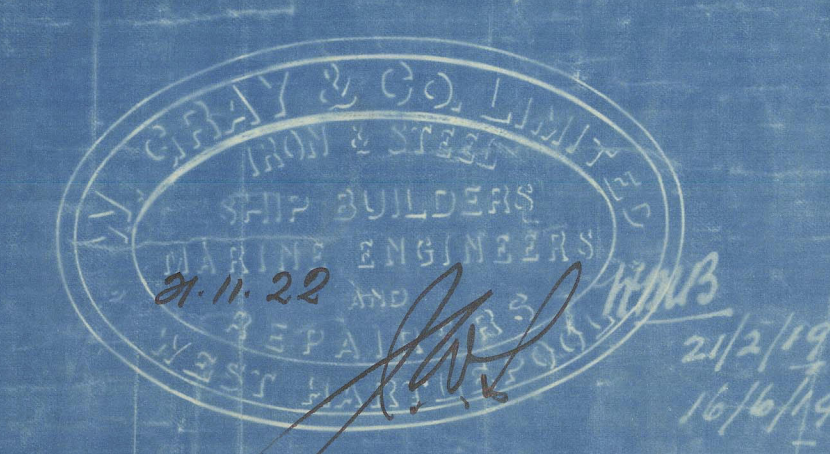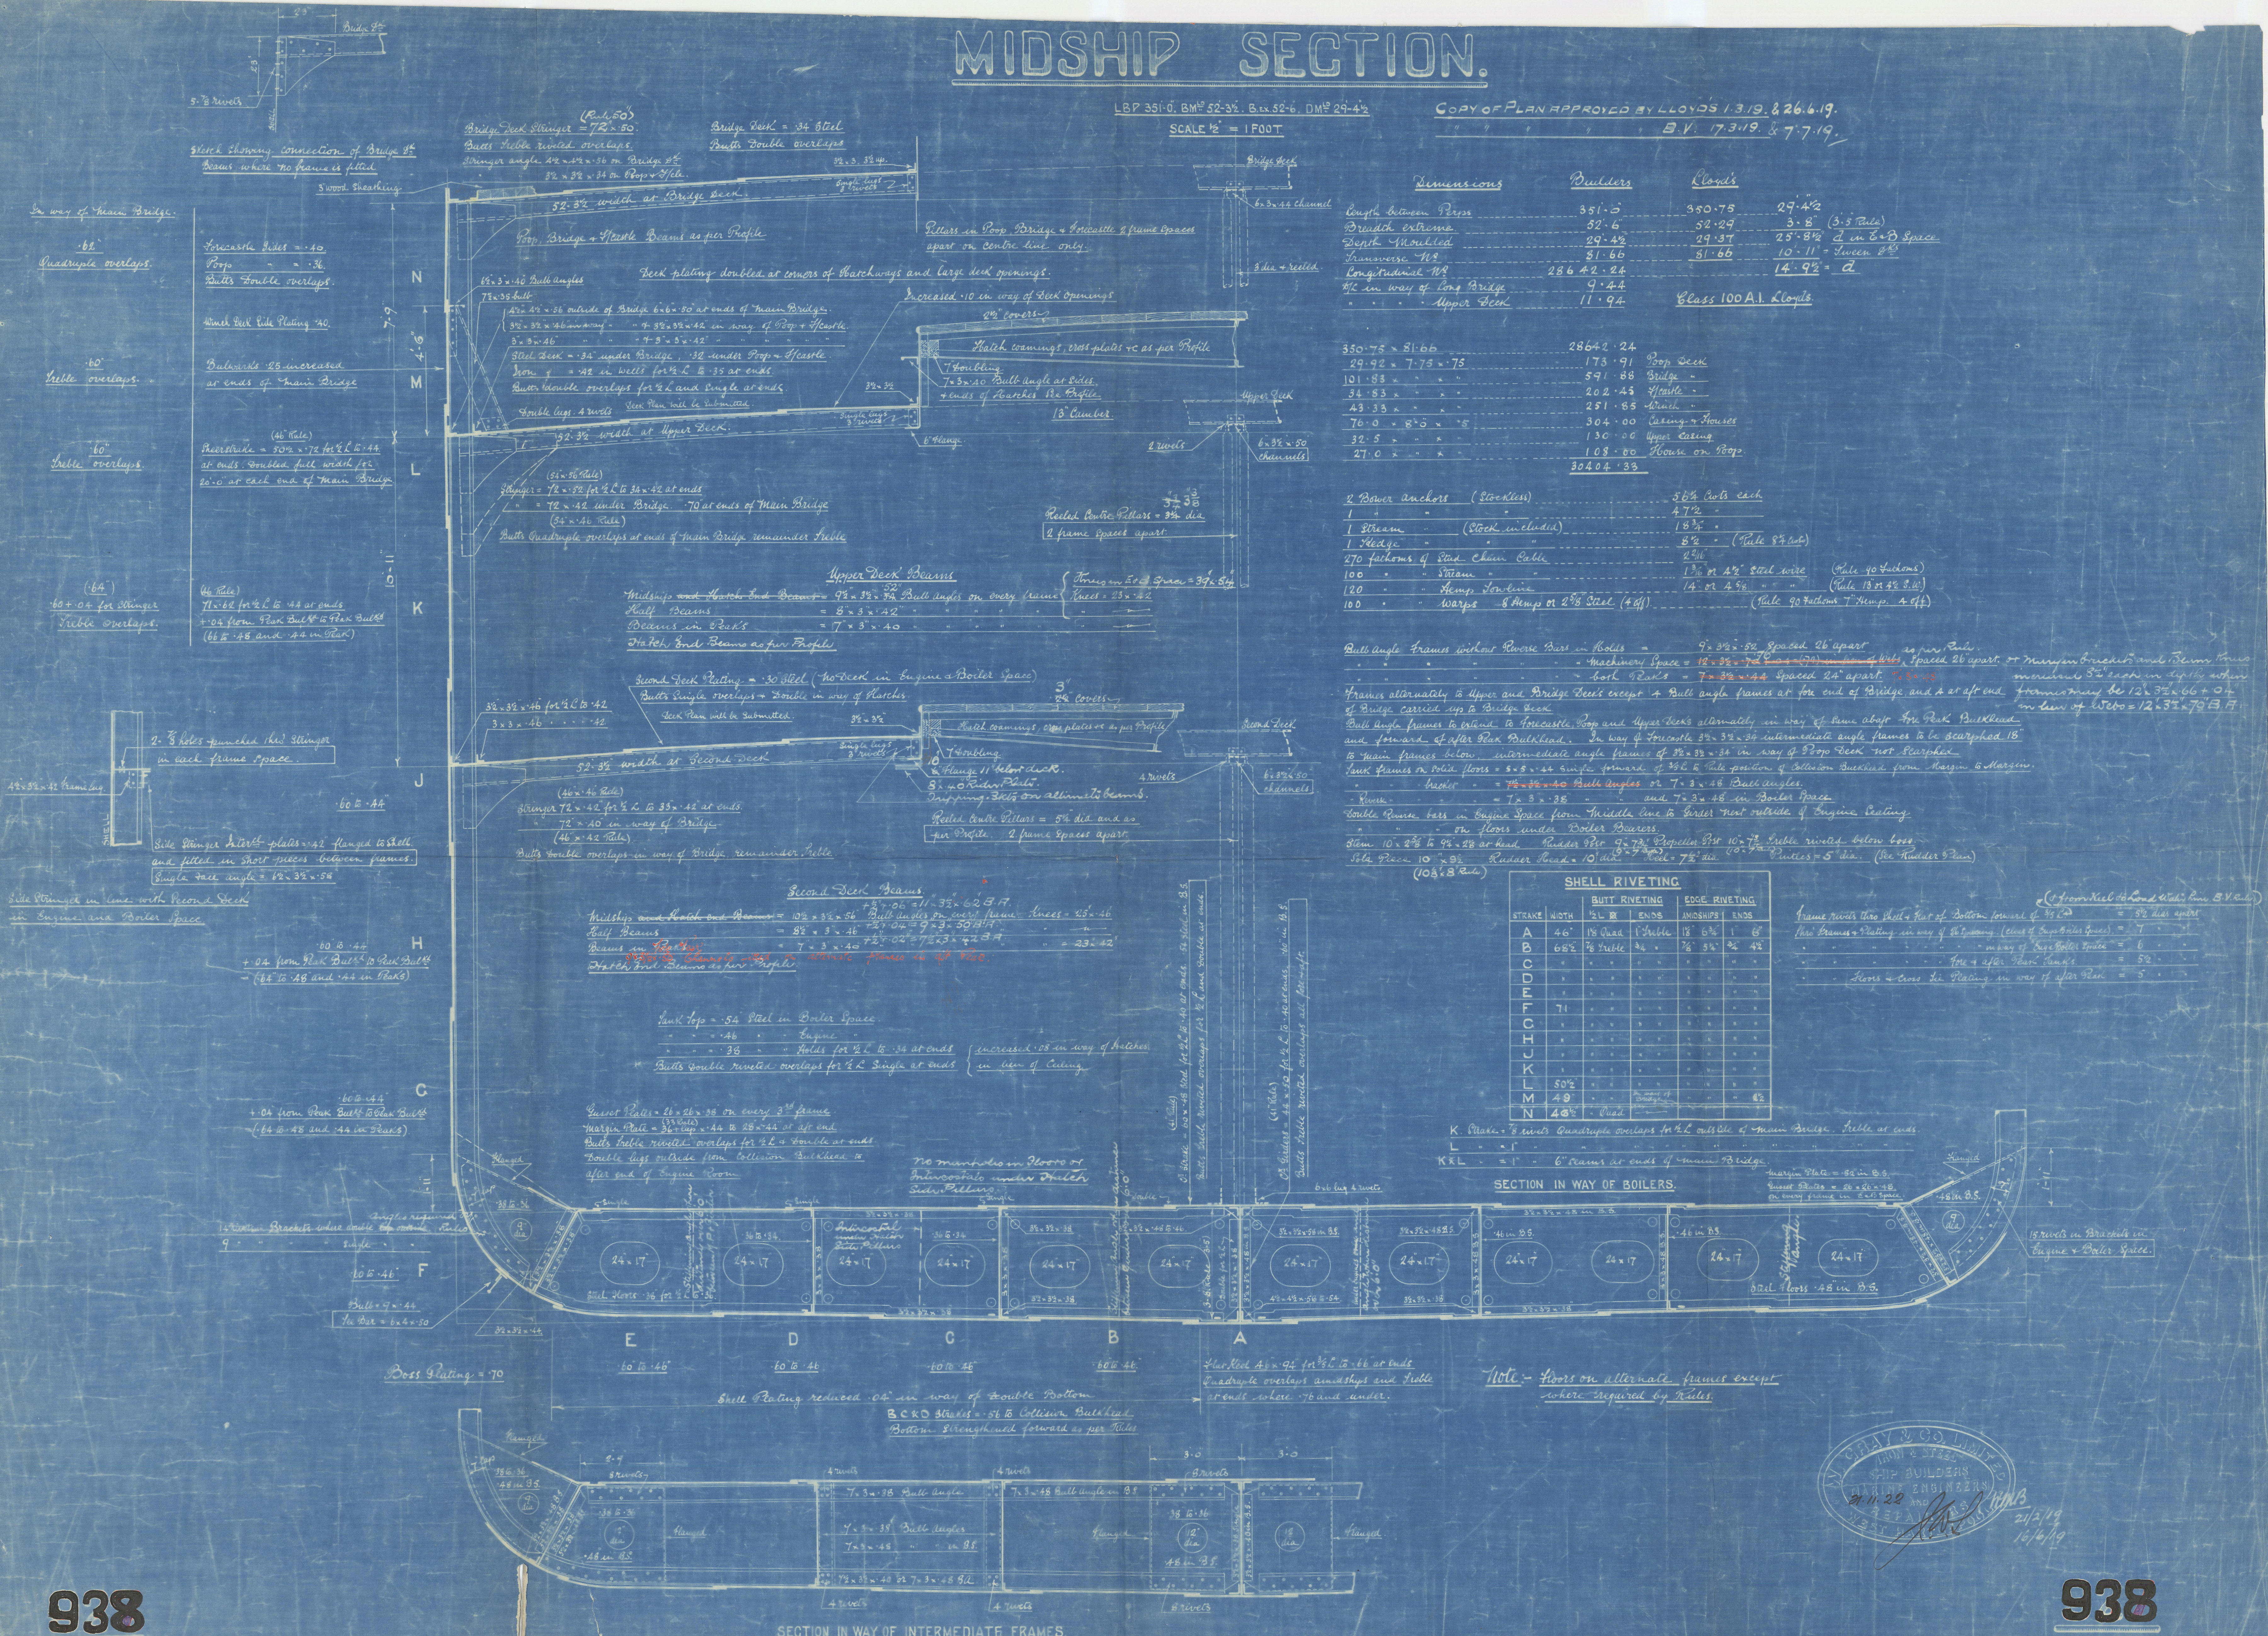

L.A.
" "
S.S. REGISTAN

now "Boussole"

MESSRS. W. GRAY & CO.

Nº 938

MIDSHIP

SECTION

Hpl Rpt. Nº 16044.



© 2021

Lloyd's Register

007352-007362-0203
Foundation