






Free

Butts of new plates
not to be in line


ST ELOI

Bridge Pl. Scale 1" = 1 foot


72-50

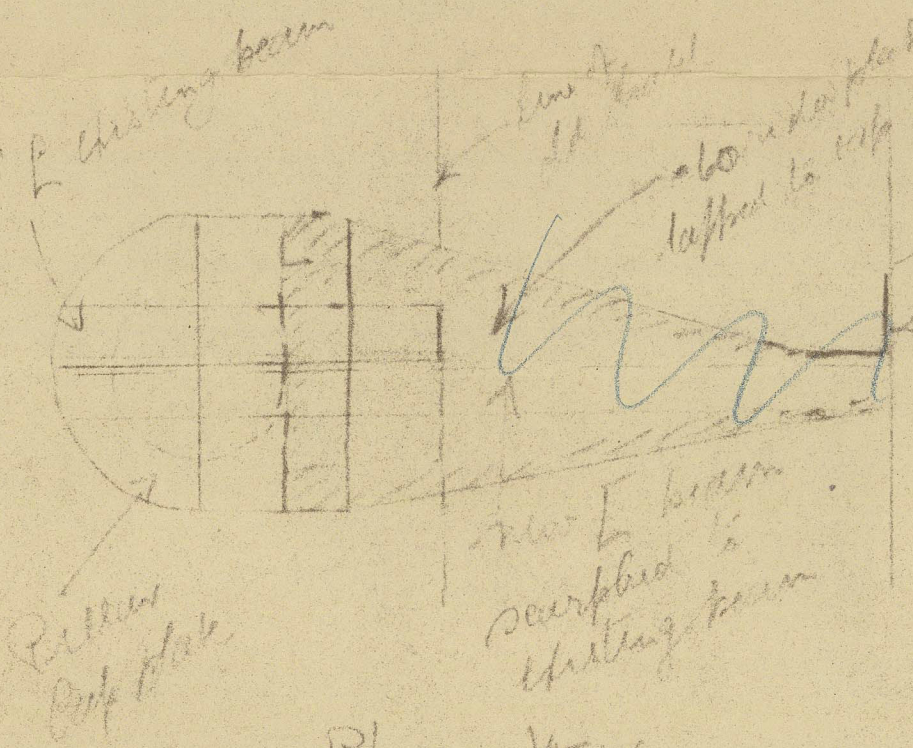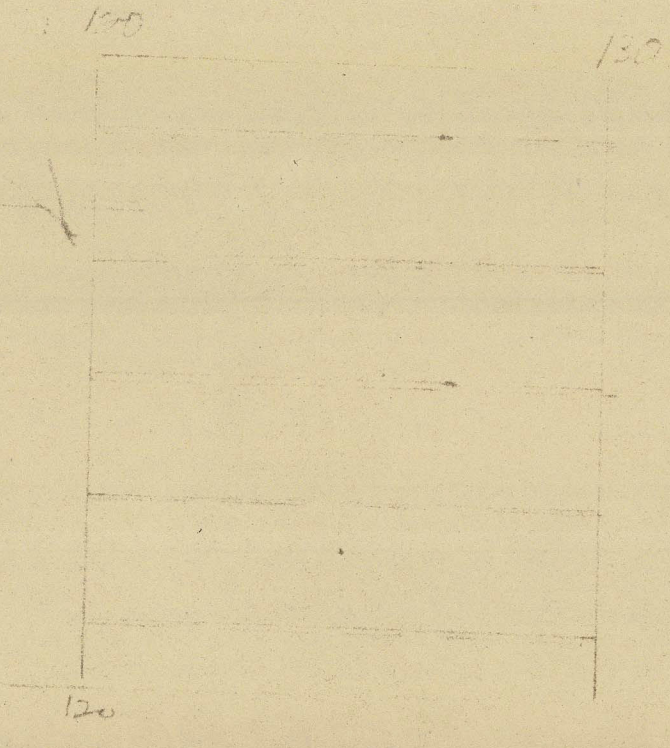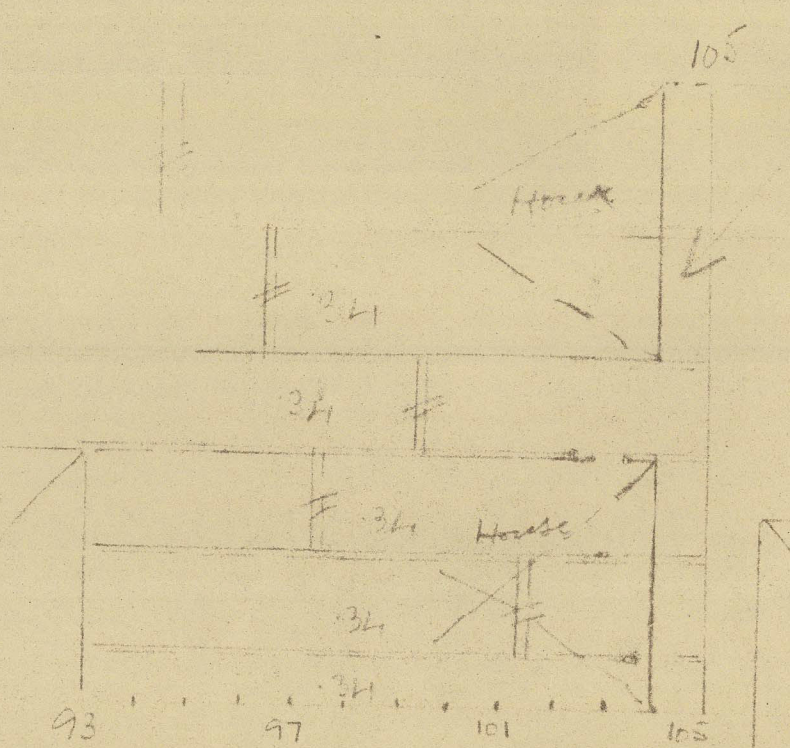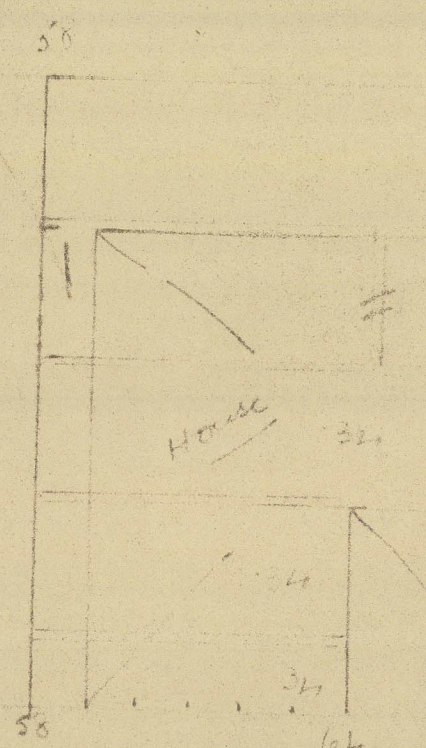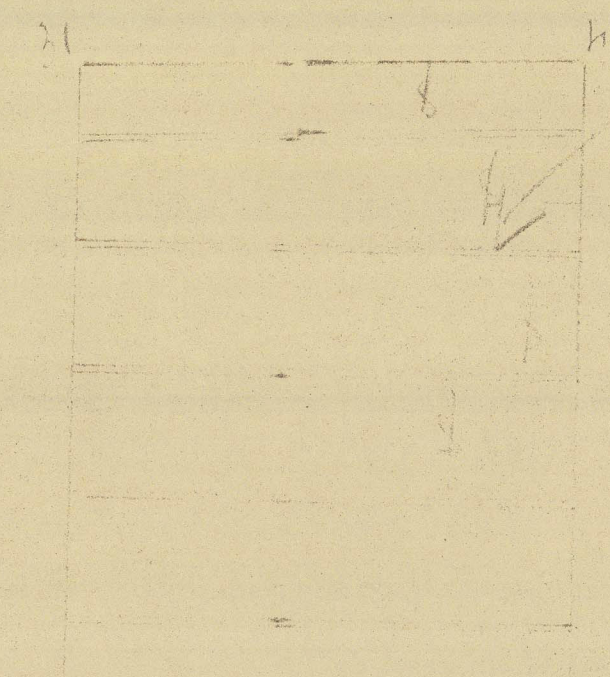

PLAN VIEW

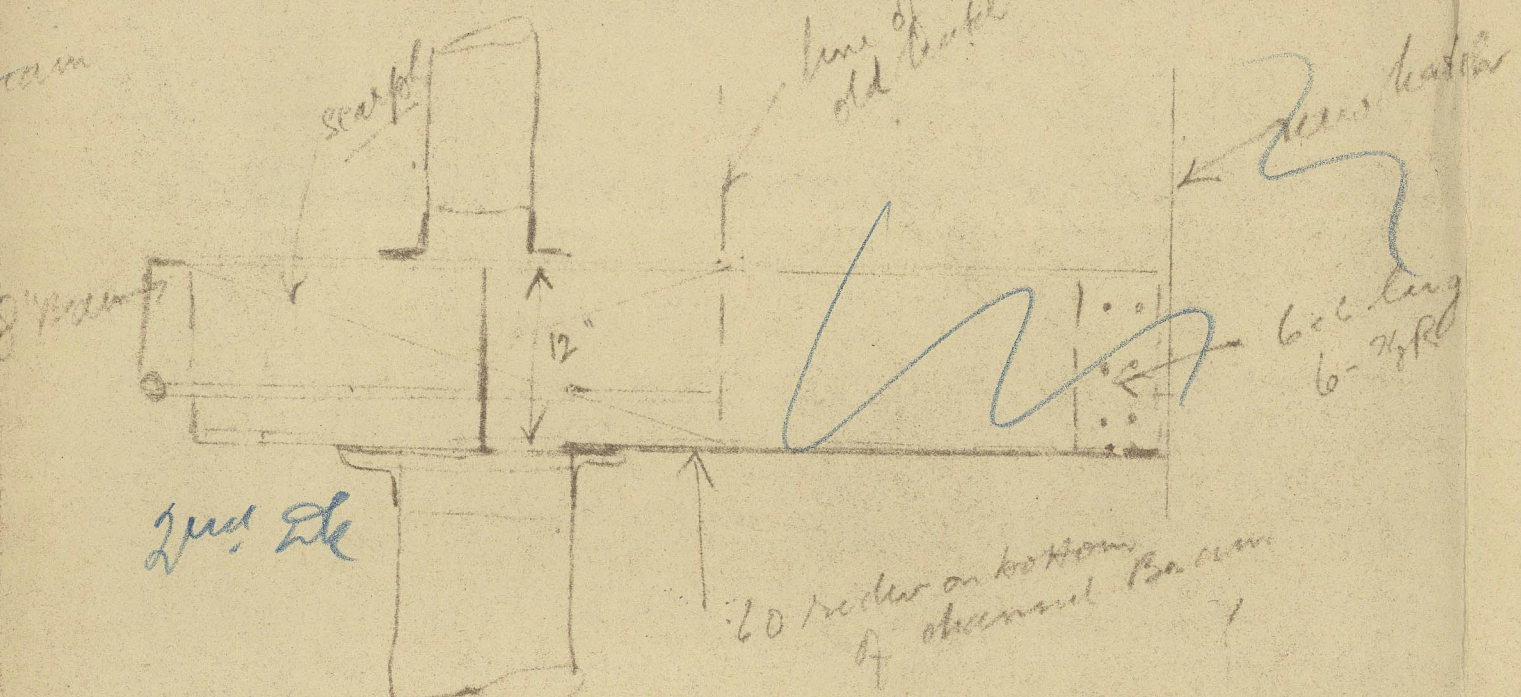

SECTION

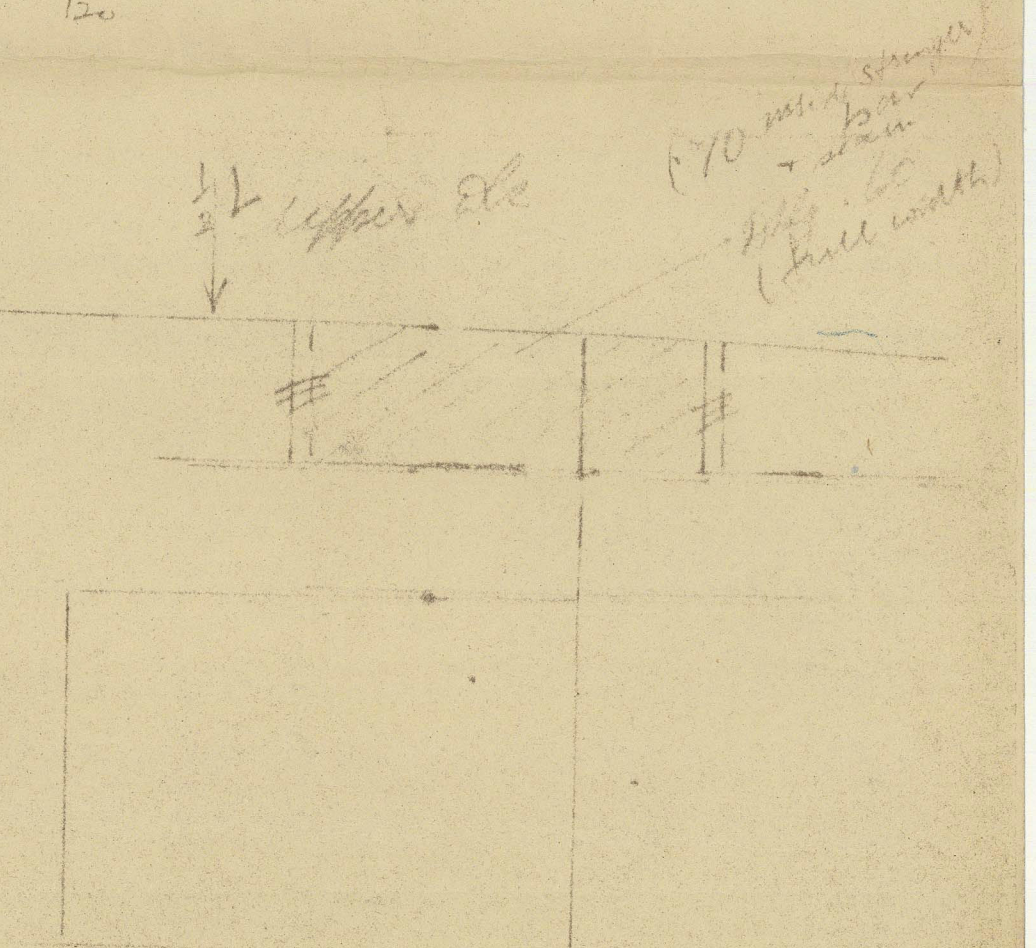


New 1 bridge front on 120 frame

Reels coming 44"
Plating 40"
Stiffeners 7x2-46 L spaced 30"

Existing stiffeners to be made
equivalent to above size
horizontal angle fitted to stiffen plating
if less than above

2nd deck hatch cuts in
way of new trunks hatch
to be re-inforced by
side plates top & bottom

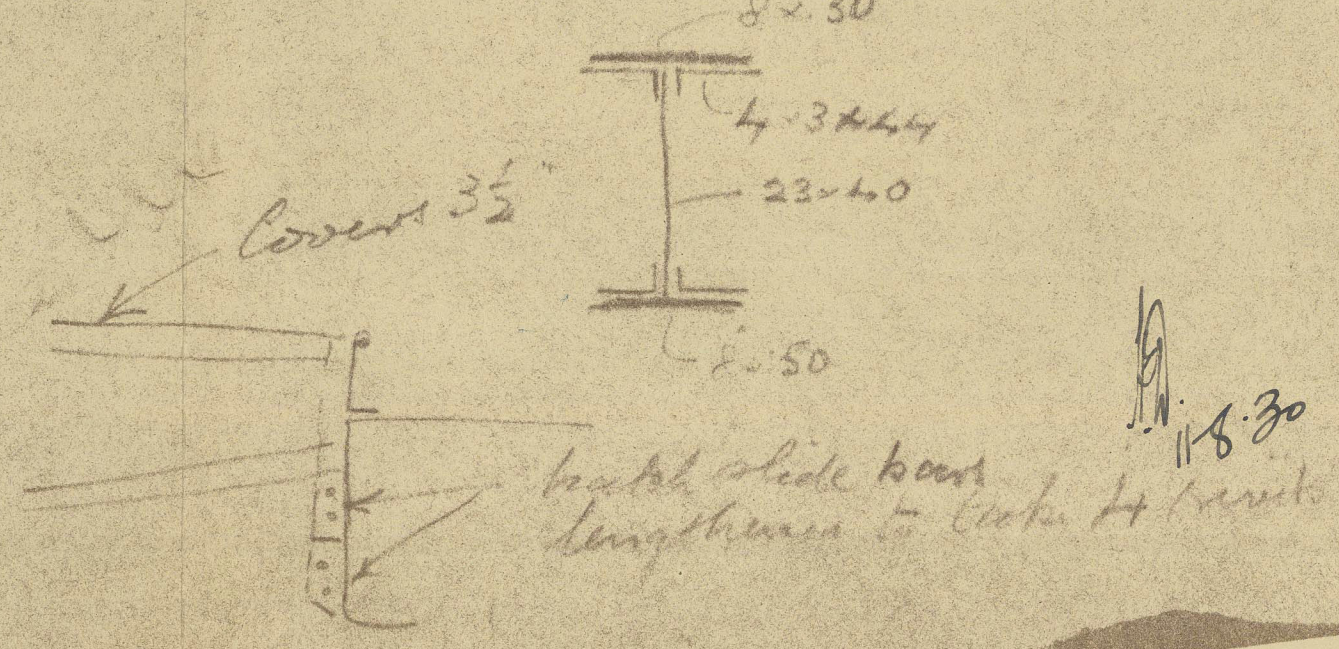

S.S. Beissollet (ex H. Elor) Bdx rfm. No. 4135.



© 2021

007352 - 007362 - 0245

Lloyd's Register
Foundation