

24-1-19

MIDSHIP SECTION. S.S. N° 10 - "A" TYPE.

DIMENSIONS 400'-0" BP x 52'-0" MLD x 31'-0" MLD.

TO CLASS 100 A.I. AT LLOYDS.

SCALE $\frac{1}{2}$ " INCH = 1 FOOT.

NUMERALS


B. MLD. 52.00

D. " 31.00

83.00 TRANSVERSE N° ✓

LENGTH 400.00

33200.00 LONGITUDINAL N° ✓

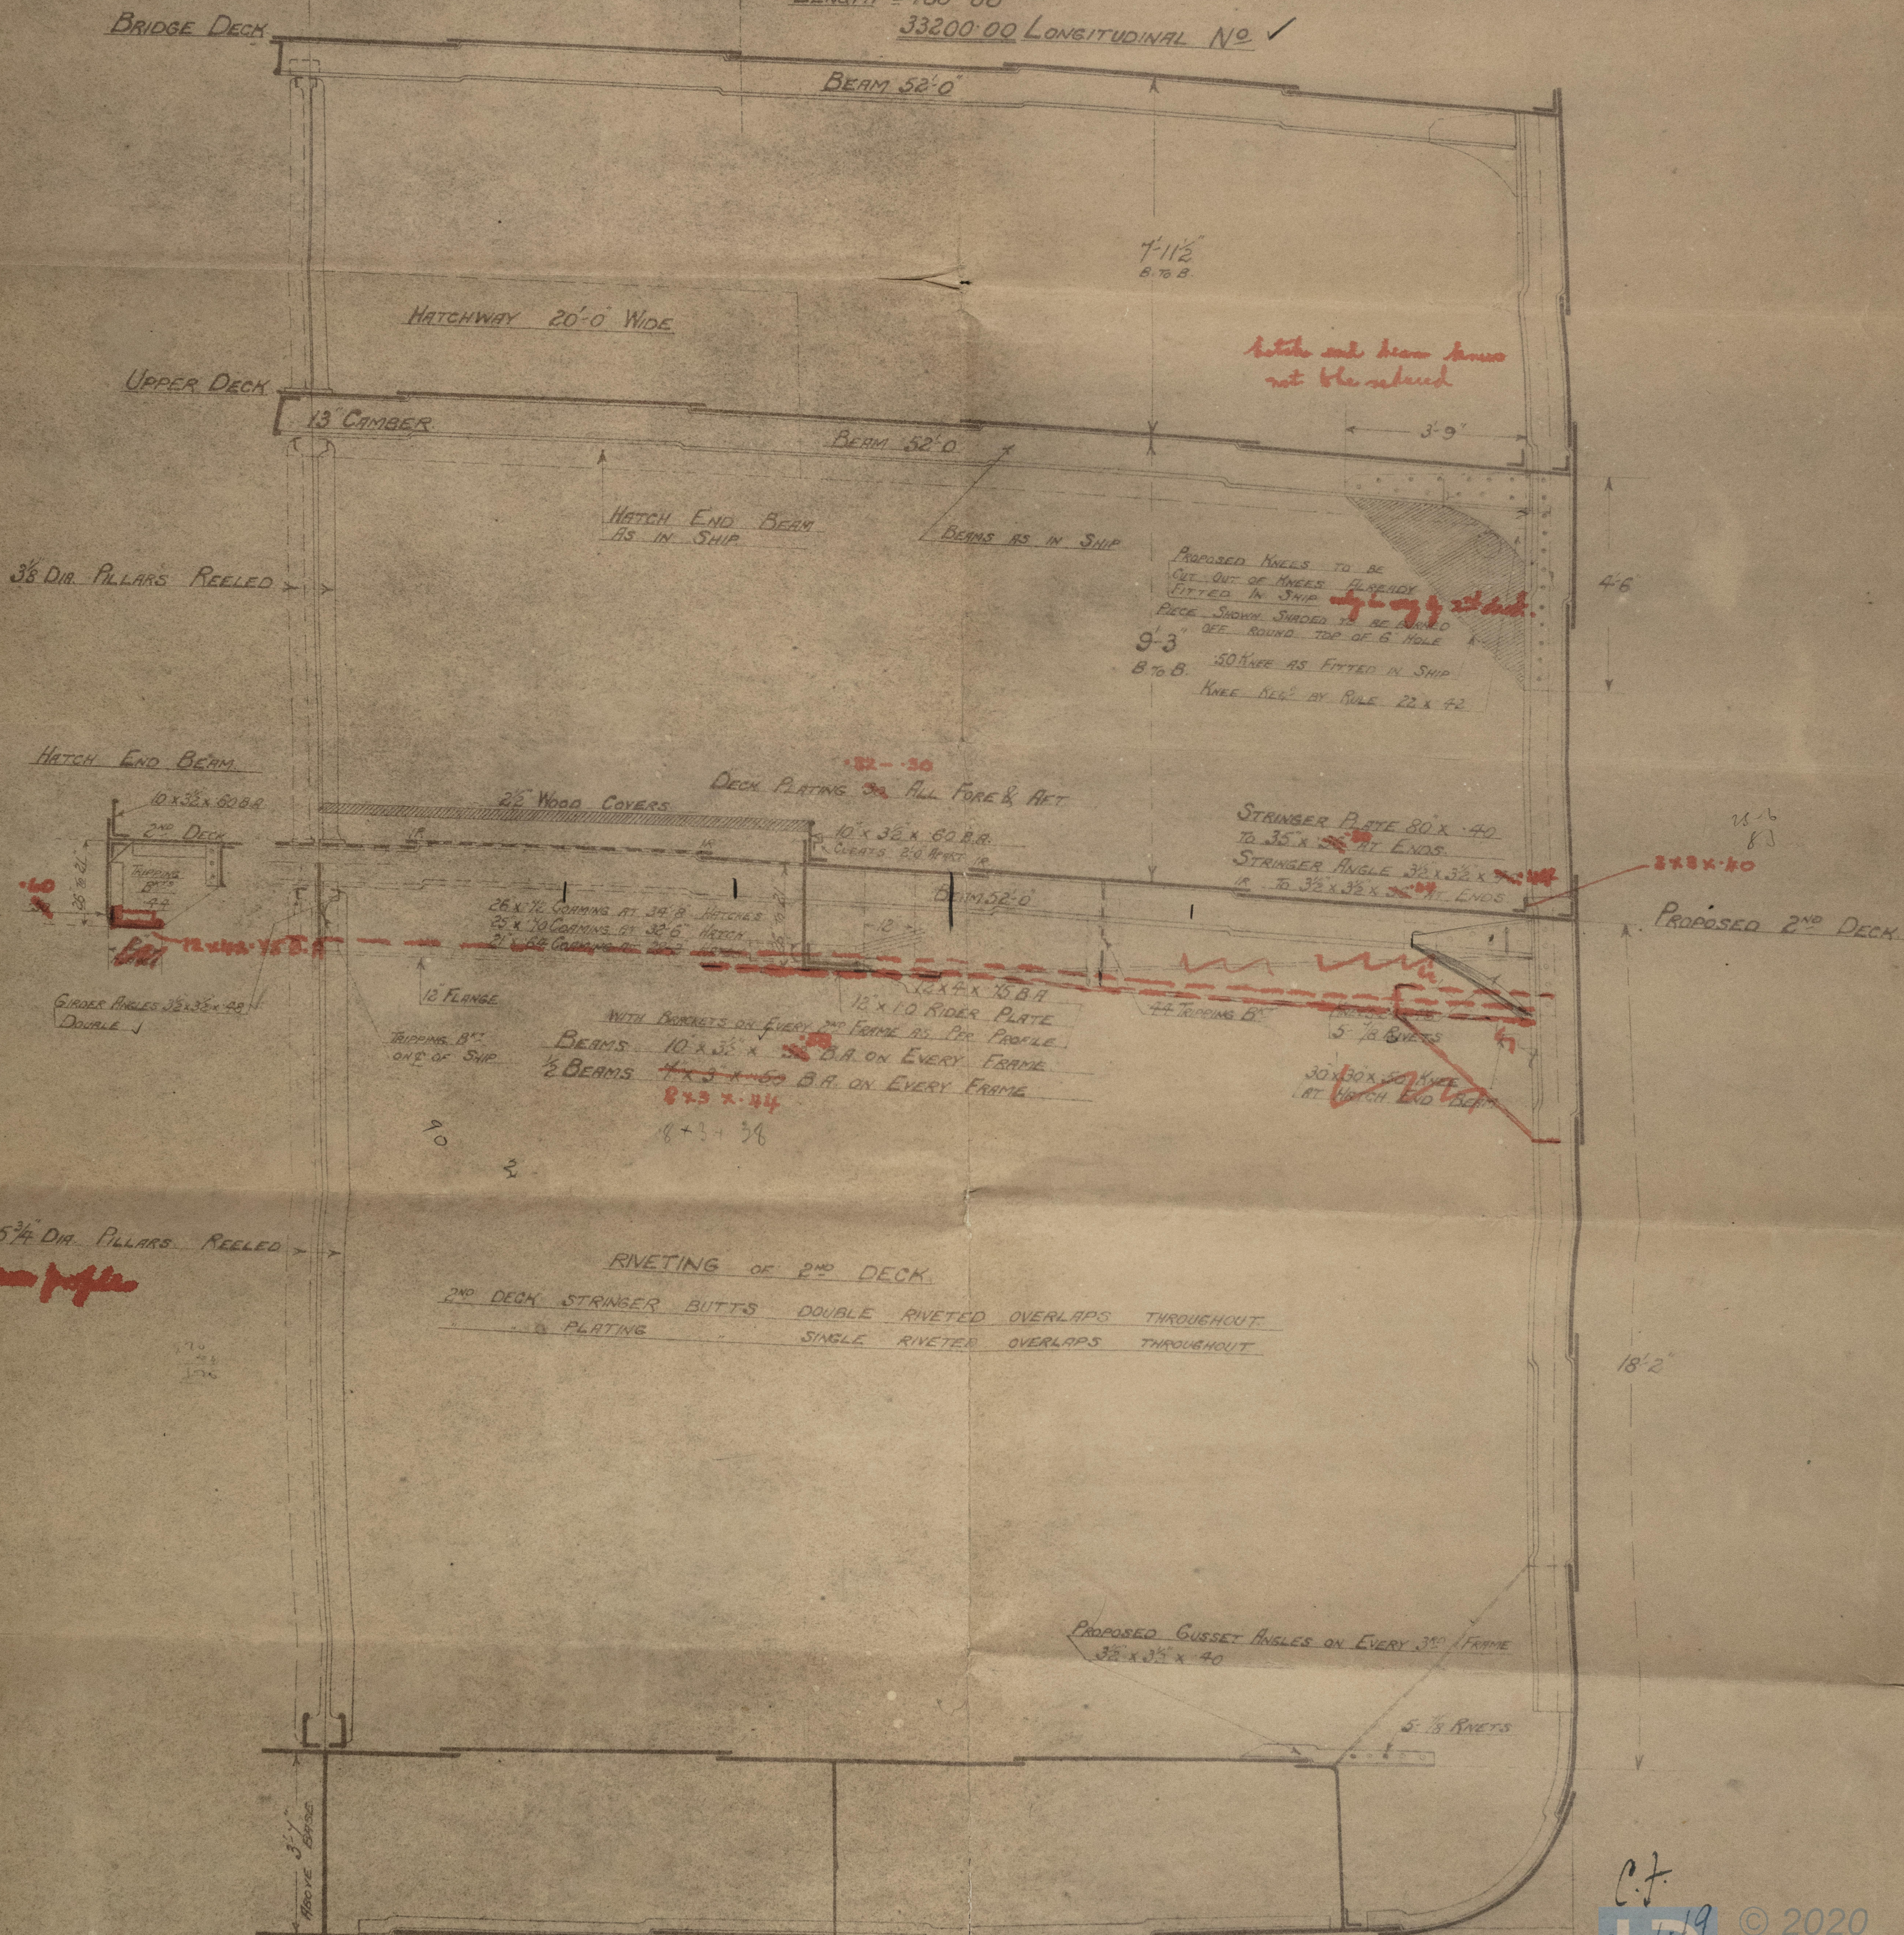

C.F.
24-1-19
R

© 2020


Lloyd's Register
Foundation.

007396-007402-0001

Lloyd Royal Belge
Midships Section
Shewing 2nd Deck
N^o 10



S.S. No 10.
Midship Section.

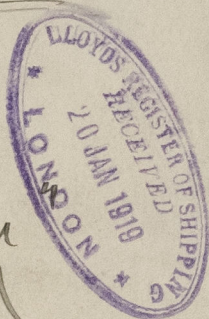

"Syoto Maru

ex.

GLASGOW REPORT No. 39275
S/S Londonier



© 2020

Lloyd's Register
Foundation