
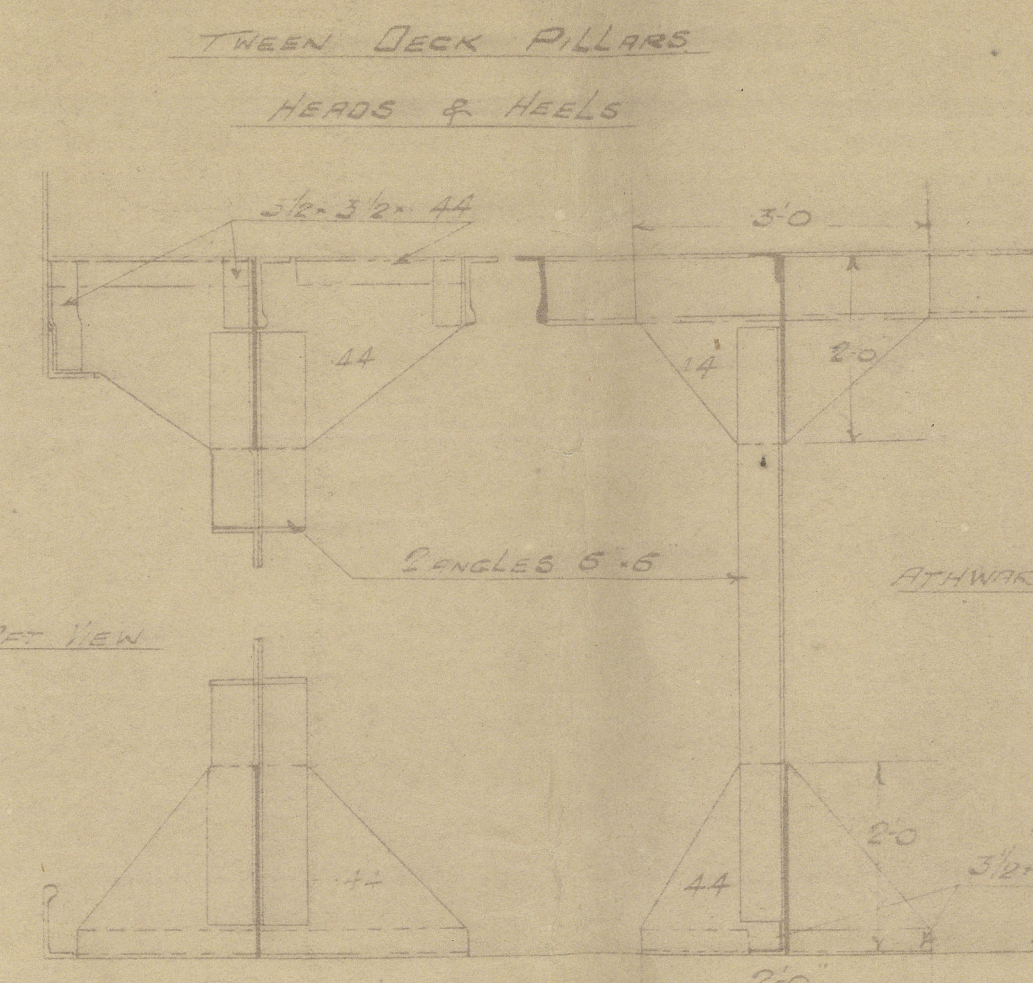
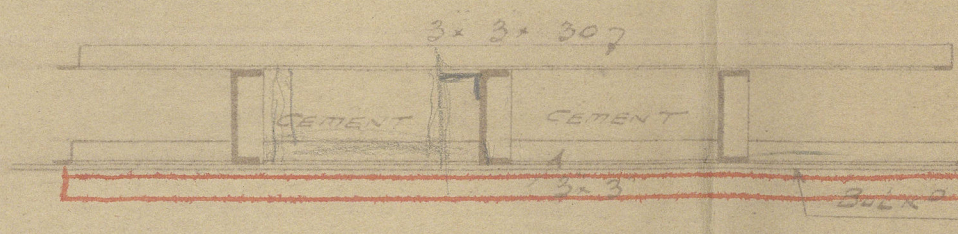
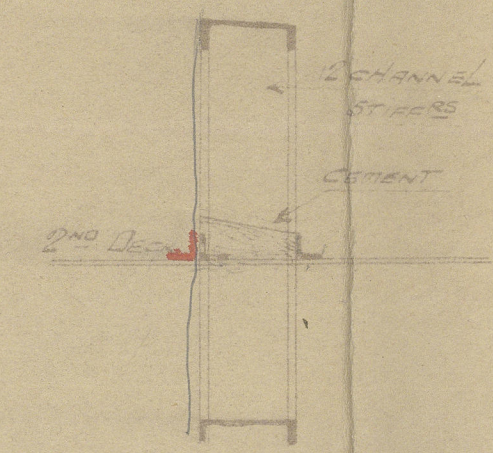


24-1-19

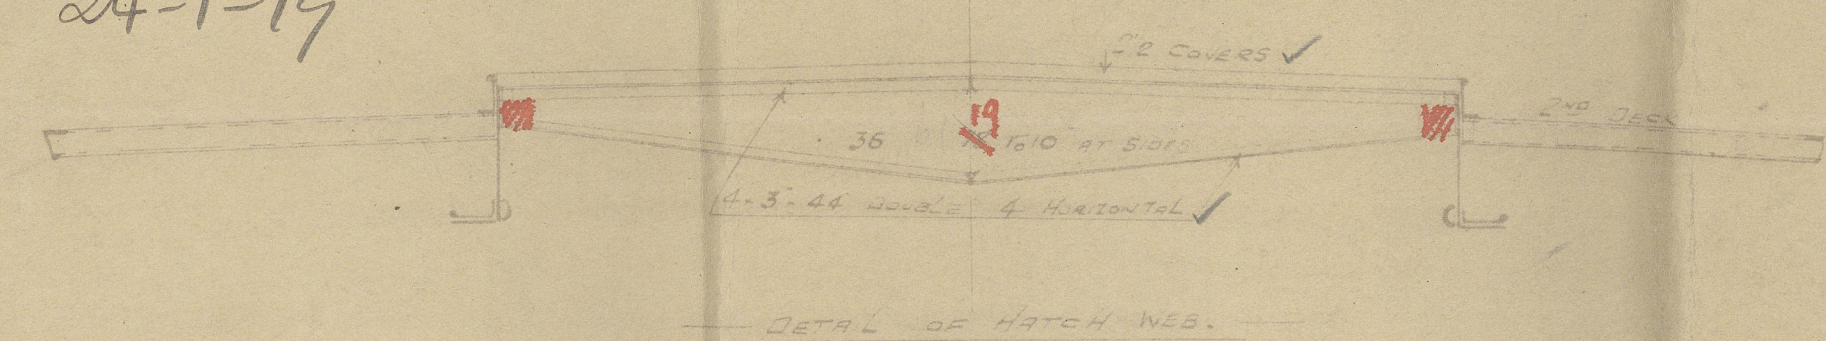


"Syoto Maru"
Glb. 39275.

PROFILE & 2ND DECK

S.S. N° 10.

SCALE 6" = 1' FOOT

DIMENSIONS IN 400' 0" B.P. 32' 0" M.P. 3' 0" N.P.

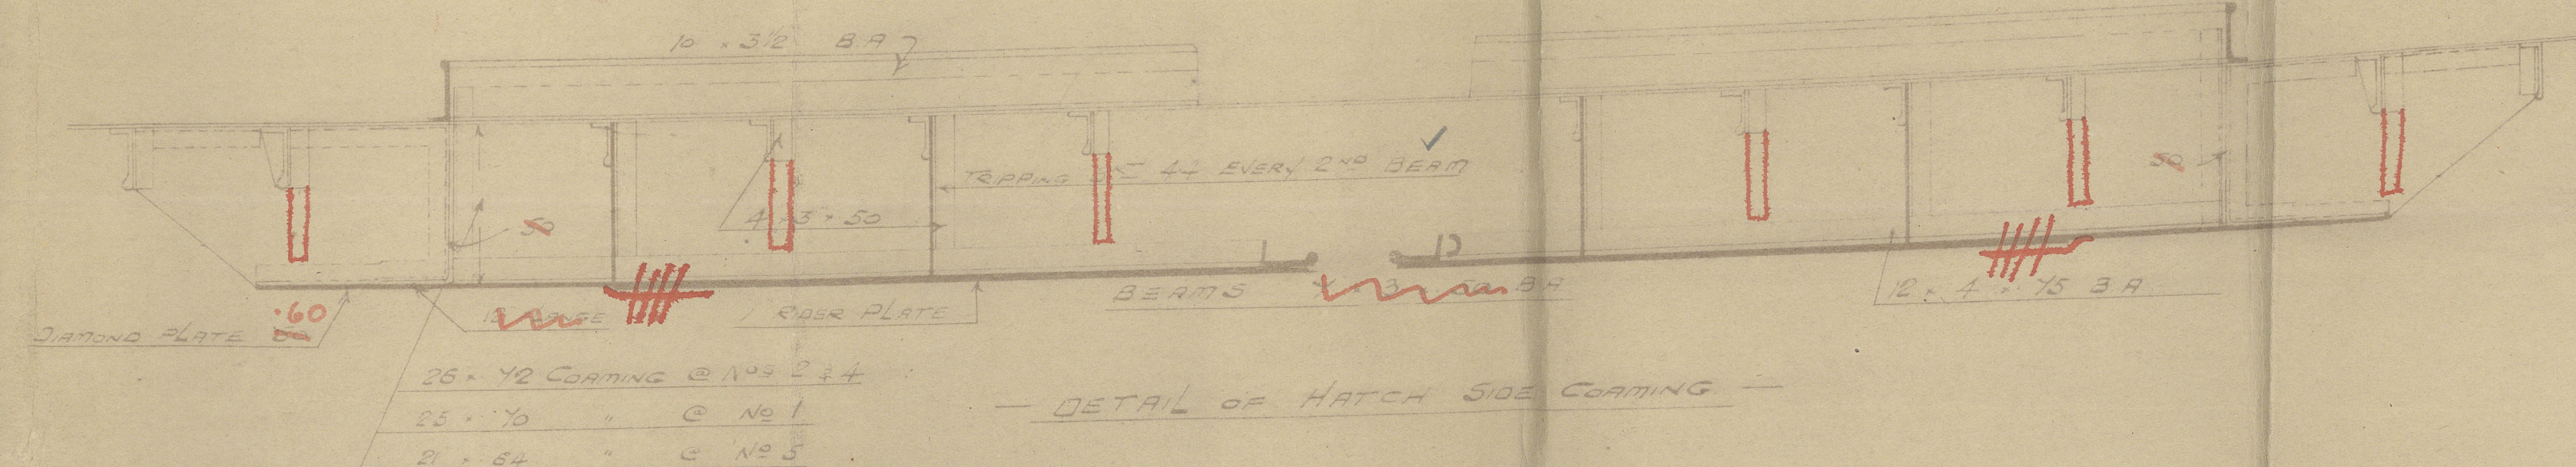

11/3/19
8" x 12" x 1/2" plate
agrees to fit
in from 23.

as per approved
Midship section

double angles to shell
and brackets on
every frame & stringer

C.F.
24-1-19

Lloyd Royal Belg
Profile & Deck Plan


N^o 10
—

GLASGOW REPORT No. 39245.

S.S. Londonier

S.S. No. 10

PROFILE & DECK PLAN

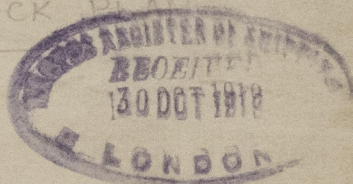

© 2020

Lloyd's Register
Foundation

007396-007402-0042