

S.S. No 754
RUDDER QUADRANT
SCALE 2"=1 FT.

NO HAND GEAR FITTED


DIAR. OF CHAINS — 1 1/16"
DIAR. OF RODS — 1 3/4"
LEADING BLOCK SHEAVES - 23
PINS OF SHEAVES — 2 7/8"

*Sec. 33 par. 5
 to be complied with.*

*An arrangement of blocks and tackles,
 or other suitable alternative to be fitted on the
 ship to the satisfaction of the Surveyors
 as an additional and precautionary
 means of steering.*

'APPROVED
LLOYD'S REGISTER OF SHIPPING

Management per [Signature]
 DATE 26.1.24

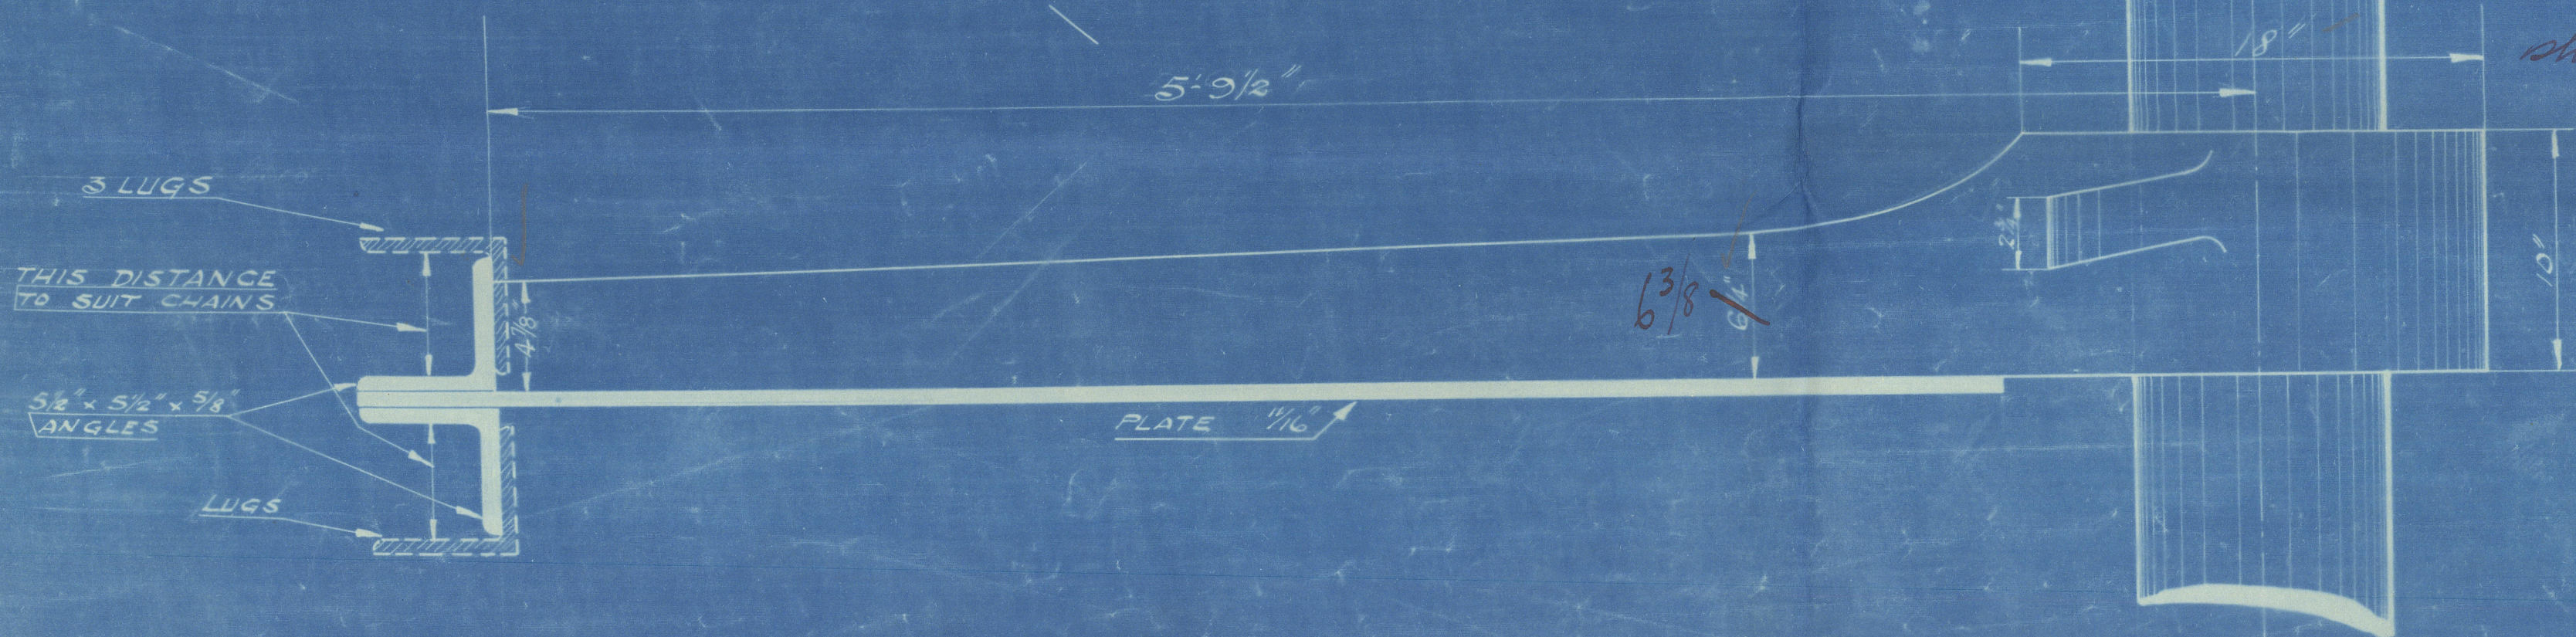

RUDDER. QUADRANT.

LITHGOW'S. LTD. No
754.

S.S. "ZAPALA"

GRK. RPT No. 18226

th/ "Rio CHUBUR"



© 2020

Lloyd's Register
Foundation

007396-007402-0105