

# Lloyd's Register of Shipping.


## SURVEYS FOR FREEBOARD.

(CONDITIONS OF ASSIGNMENT.)

4 JUN 1943

Ship's Name "ANTIC" Port of Survey Hull.  
 Official Number None Surveyor's Signature J. Macleod  
 Nationality and Port of Registry BRITISH - None. Date of Survey During construction

Disposition and dimensions of superstructures, trunks, deckhouses and machinery casings to be inserted in the diagrams and tabular statement :-

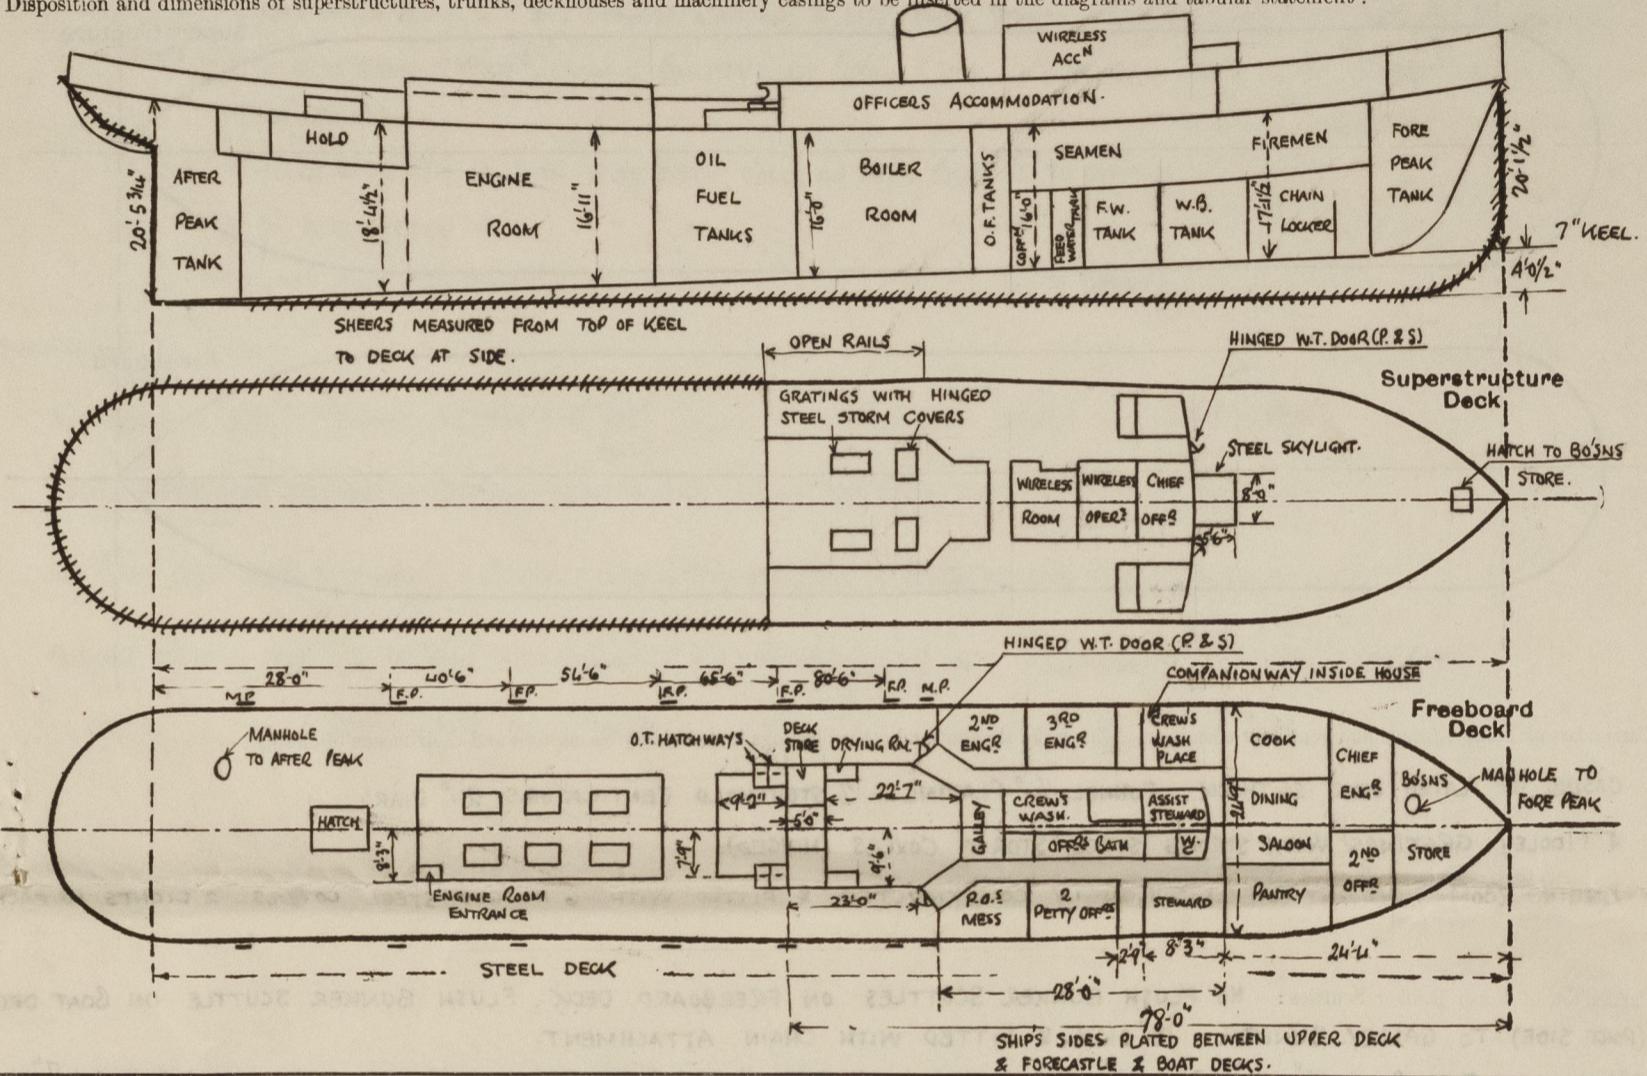

Particulars of Superstructures, Trunks, Casings, Deckhouses.

	Coaming	Plating	Stiffeners	Spacing	End Attachments of Stiffeners	Size of Openings	Height of Sills	Height of Casings
Poop Bulkhead ... ..	✓							
Raised Quarter Deck Bulkhead ...	✓							
Bridge, After Bulkhead ... ..	✓							
Bridge, Forward Bulkhead ... ..	✓							
Forecastle Bulkhead (ON FRAME N <sup>o</sup> 65)	✓	25	2 1/2 x 2 1/2 x 25 Γ	30"	NONE	4'10" x 1'9"	15	7'3"
Trunk, Aft (FRAME N <sup>os</sup> 31-36)...	✓	30	3 x 2 1/2 x 30 Γ	30"	NONE	4 O.T. HATCHWAYS ON TOP OF TRUNK	✓	3'0"
Trunk, Forward ... ..	✓							
Exposed Machinery Casings on Freeboard or Raised Quarter Decks ...	18" x 32	28	3 1/2 x 2 1/2 x 30 Γ 7" x 3" x 40 Γ	APPROX 26"	BKTS AT TOP	4'0" x 1'9"	24"	7'3"
Exposed Machinery Casings on Superstructure Decks ... ..	✓							
Machinery Casings within Superstructures not fitted with Class I Closing Appliances ... ..	✓							
Deckhouses on Flush Deck Ships ...	✓							

Particulars of Closing Appliances (state if capable of being manipulated from both sides).

Poop Bulkhead ... ..	✓
Raised Quarter Deck Bulkhead ...	✓
Bridge, After Bulkhead ... ..	✓
Bridge, Forward Bulkhead ... ..	✓
Forecastle Bulkhead ... ..	✓
Exposed Machinery Casings on Freeboard or Raised Quarter Decks ...	TO SALOON, ACCOMMODATION & WASH PLACES ETC. WOOD DOORS 4'10" x 1'9" x 1 3/8" THICK WITH 15" SILLS. TO DECK STORE (PORT) STEEL DOOR 4'0" x 1'9" x 24" SILL. TO DRYING ROOM (P. & S) STEEL DOORS 4'3" x 1'9" x 21" SILL. TO GALLEY (P. & S) STEEL DOORS (IN HALVES) 5'0" x 1'9" x 15" SILL. TO FOOD STORE (STBD) W.T. DOOR 4'0" x 2'3" x 24" SILL.
Exposed Machinery Casings on Superstructure Decks ... ..	TO BOILER ROOM (P. & S). STEEL DOOR 4'0" x 1'9" x 24" SILL.
Machinery Casings within Superstructures not fitted with Class I Closing Appliances ... ..	ENTRANCE DOOR OF COMPANION ON UPPER DECK FORWARD (PORT) WOOD DOOR 4'7" x 1'9" x 1 3/8" THICK WITH 18" SILL. ALL DOORS FITTED WITH SPRING LOCKS OPERATED FROM BOTH SIDES.
Deckhouses on Flush Deck Ships ...	✓



PARTICULARS OF PROTECTION TO OPENINGS, ETC.

HATCHWAYS ON FREEBOARD AND SUPERSTRUCTURE DECKS.							
Description of Hatchway ... ..	TRUNK TOP		UPPER DECK		UPPER DECK.		FORECASTLE DECK
	4 O.T. HATCHWAYS TO AFTER OIL FUEL TANKS		HATCH TO	HOLD AFT.	2 O.T. HATCHWAYS TO SIDE OIL FUEL TANKS		HATCHWAY TO BOYS'S STORE
Dimensions of Hatchway ... ..	2 @ 2'0" x 2'6" 2 @ 2'6" x 1'9"		8'0" x	6'0"	11 1/2" x 9 1/2"		2'9" x 2'9"
COAMINGS	Height above Deck ...	48"	27"		15"		12"
	Thickness	.30	.40		.30		.375
	Stiffeners ...	.30	.40		.30		.375
	Brackets, Stays ...	NONE	NONE		NONE		NONE
HATCH BEAMS	Number ...	NONE	NONE		NONE		NONE
	Bearing Surface ...						
FORE AND AFTERS	Number ...	NONE	NONE		NONE		NONE
	Bearing Surface ...	✓	✓		✓		✓
HATCH COVERS	Material ...	STEEL COVER PLATE - 50	PLATE		STEEL COVER PLATE - 375		STEEL COVER PLATE
	Thickness ...	SECURED BY 7/8" DIAR.	3"		SECURED BY 7/8" DIAR.		SECURED BY 7/8" DIAR.
	How fitted ...	EYEBOLTS WITH	F. & A.		EYEBOLTS WITH		EYEBOLTS WITH
	Bearing Surface ...	GUNMETAL TOGGLES	3"		GUNMETAL TOGGLES		GUNMETAL TOGGLES.
Spacing of Cleats ...	✓		24"		✓		✓
Number of Tarpaulins ...	✓		2		✓		✓
*Are wood fore and afters steel shod at all bearing surfaces? <i>Yes.</i> Are battens and wedges efficient and in good condition? <i>Yes.</i> Are tarpaulins in good condition and in accordance with rule requirements? <i>Yes.</i> Are lashings provided in accordance with rule requirements? <i>Yes.</i>							

Particulars of any special features :-

Endorsement at first survey and at surveys for renewal of Certificate :-

The fittings and appliances are in accordance with the particulars shown on this form (or as now modified) and are in good condition.

