


— SCALE  $\frac{1}{8}" = 1 \text{ FOOT}$  —

Equipment to be  
Submitted.

26. 4. 12  
27. 6. 12  
9. 7. 12  
15. 7. 12  
23. 7. 12

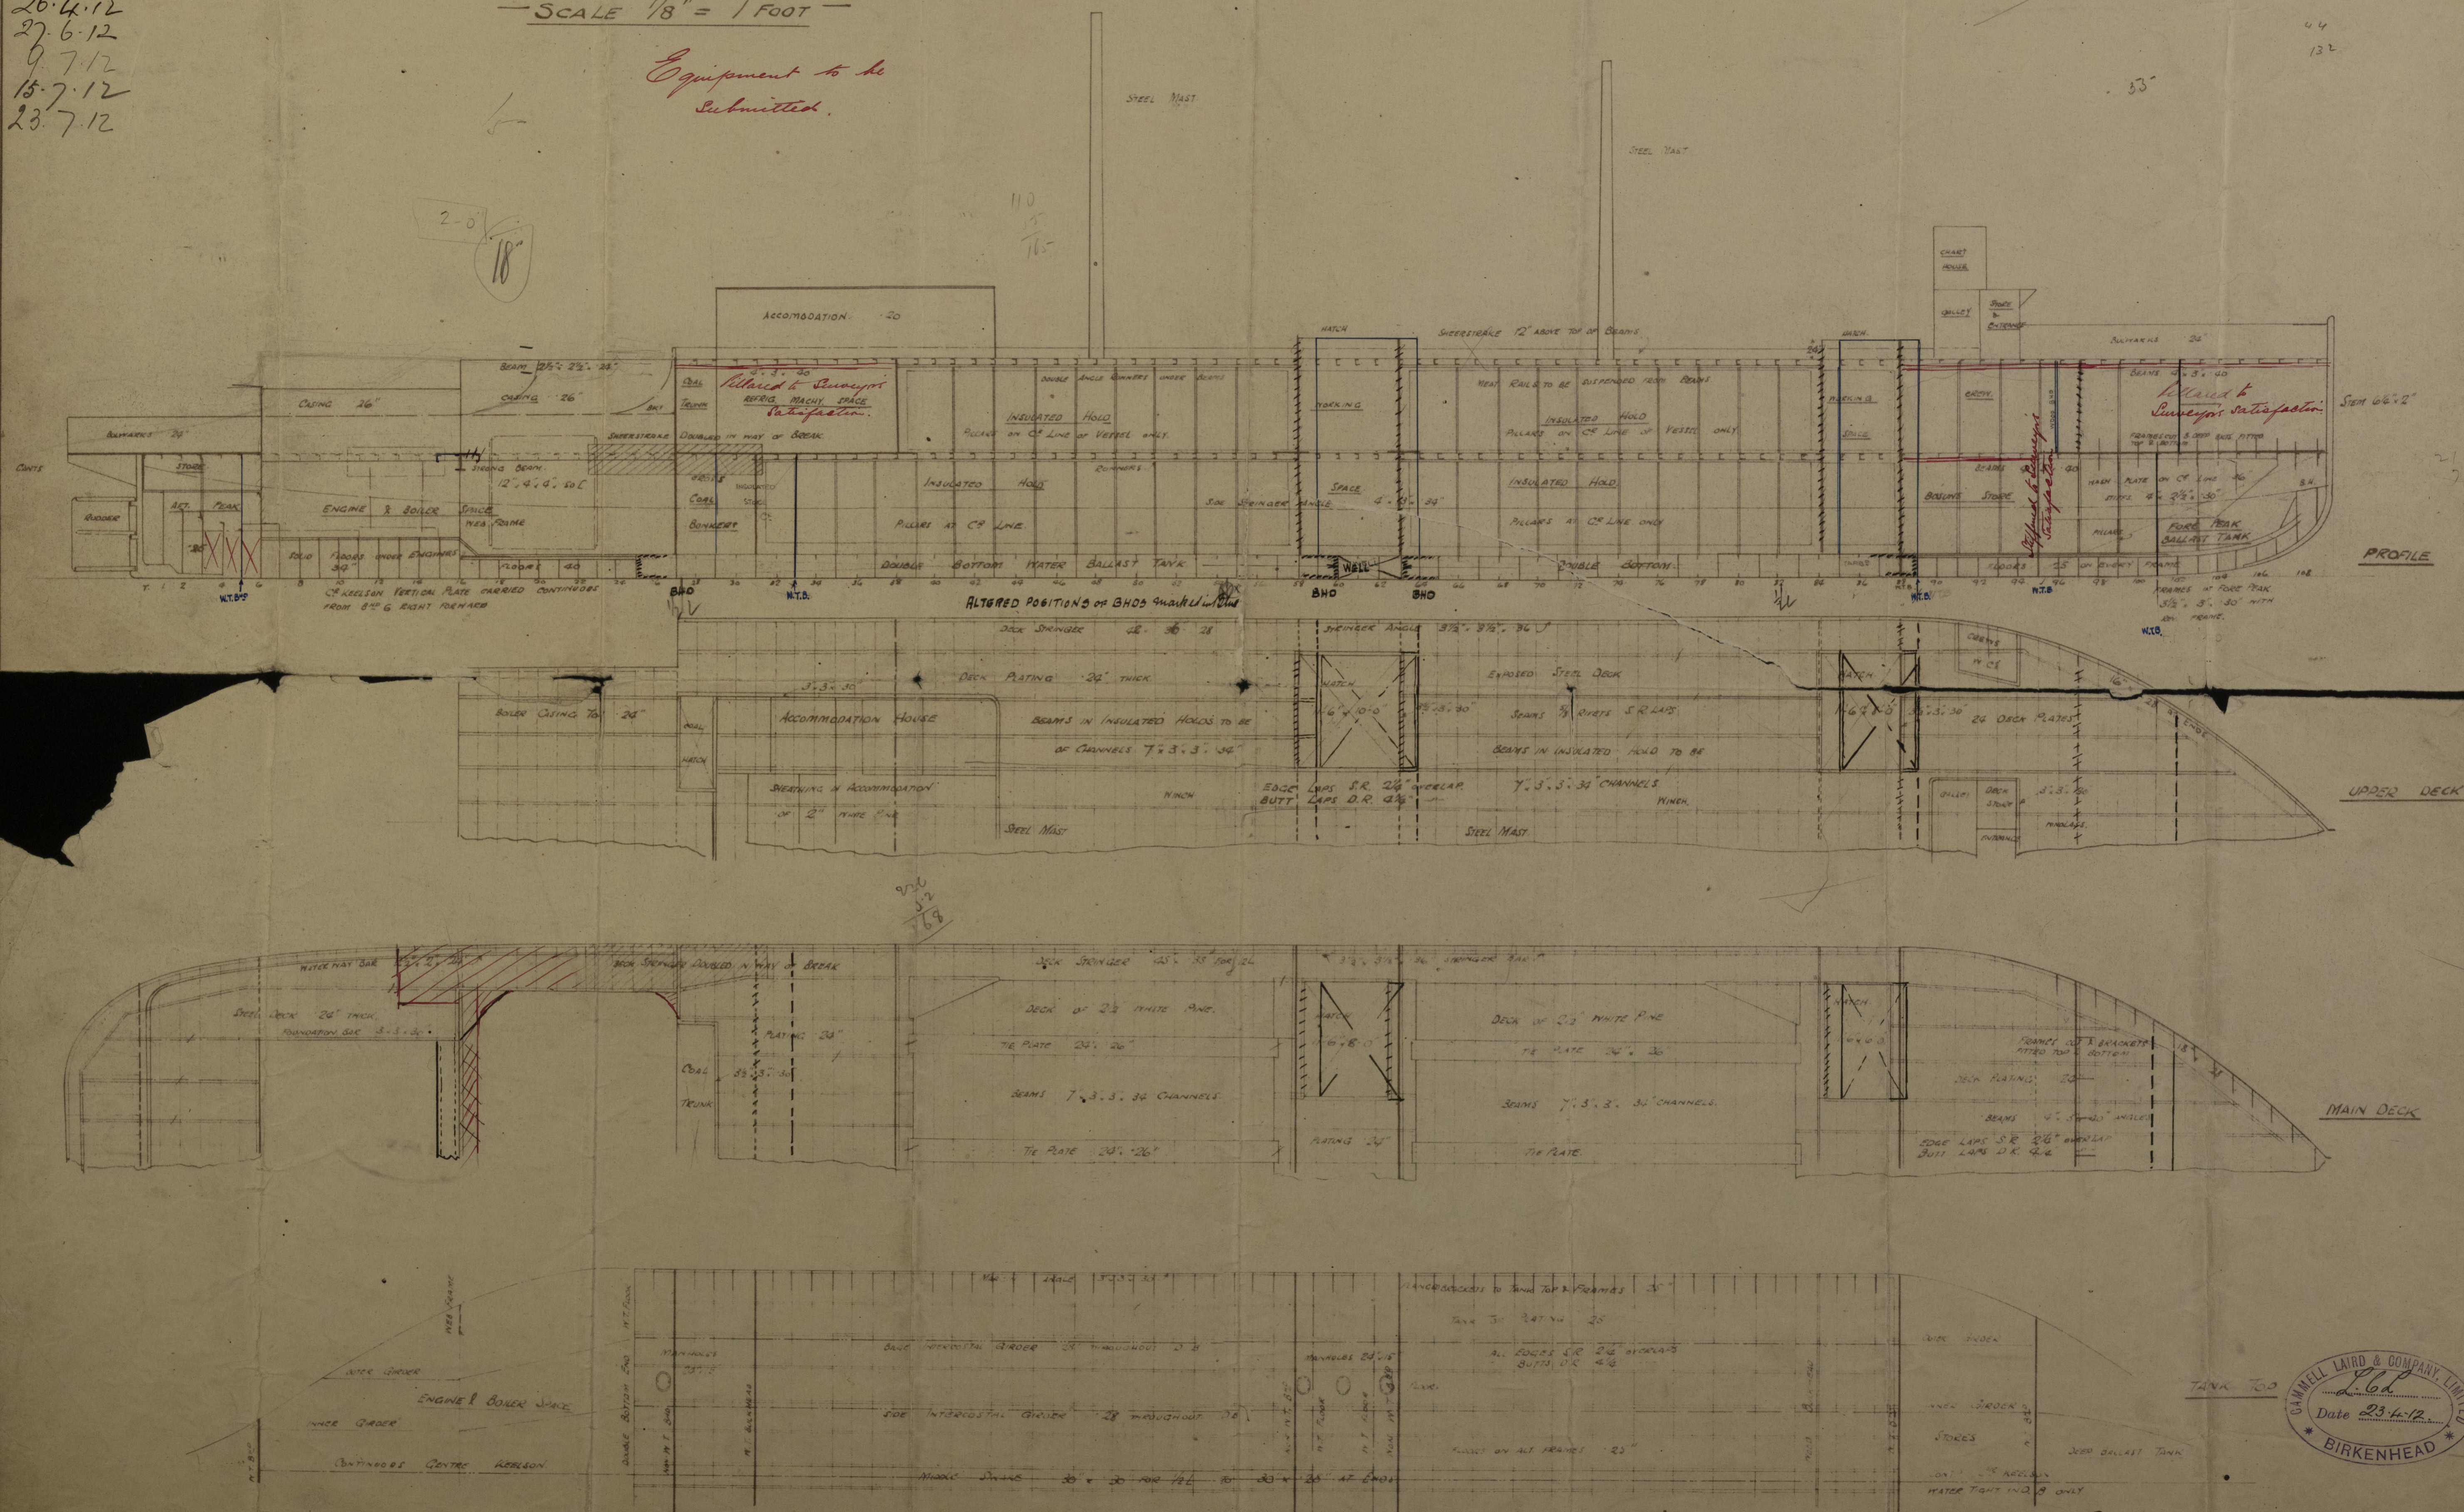

26.4.12.

PLAN NO. 1442 © 2020

GAMMELL LAIRD & COMPANY, LIMITED  
*L.L.L.*  
 Date *23.4.12*  
 BIRKENHEAD

"Britanica  
BRITANICA  
EX. ex.  
P. J. Doon

C. Laura Hecla.  
No 40.

PROFILE

Civ Rpt No 69371.

14 JUN 1912

20 JUL 1912

9- JUL 1912

13 JUL 1912

14 SEP 1912

25 APR 1912

20 AUG 1914



© 2020

Lloyd's Register  
Foundation