

18.6.12

# NO 790 STEM, STERN POST & RUDDER


SCALE  $\frac{1}{2}'' = 1$  FOOT

MATERIAL TO BE OF BEST FORGED SCRAP IRON TO LLOYDS REQUIREMENTS


Not exceeding 10 Knots

SPEED =  $9\frac{1}{2}$  KNOTS

## DETAIL OF TOP PINTLE

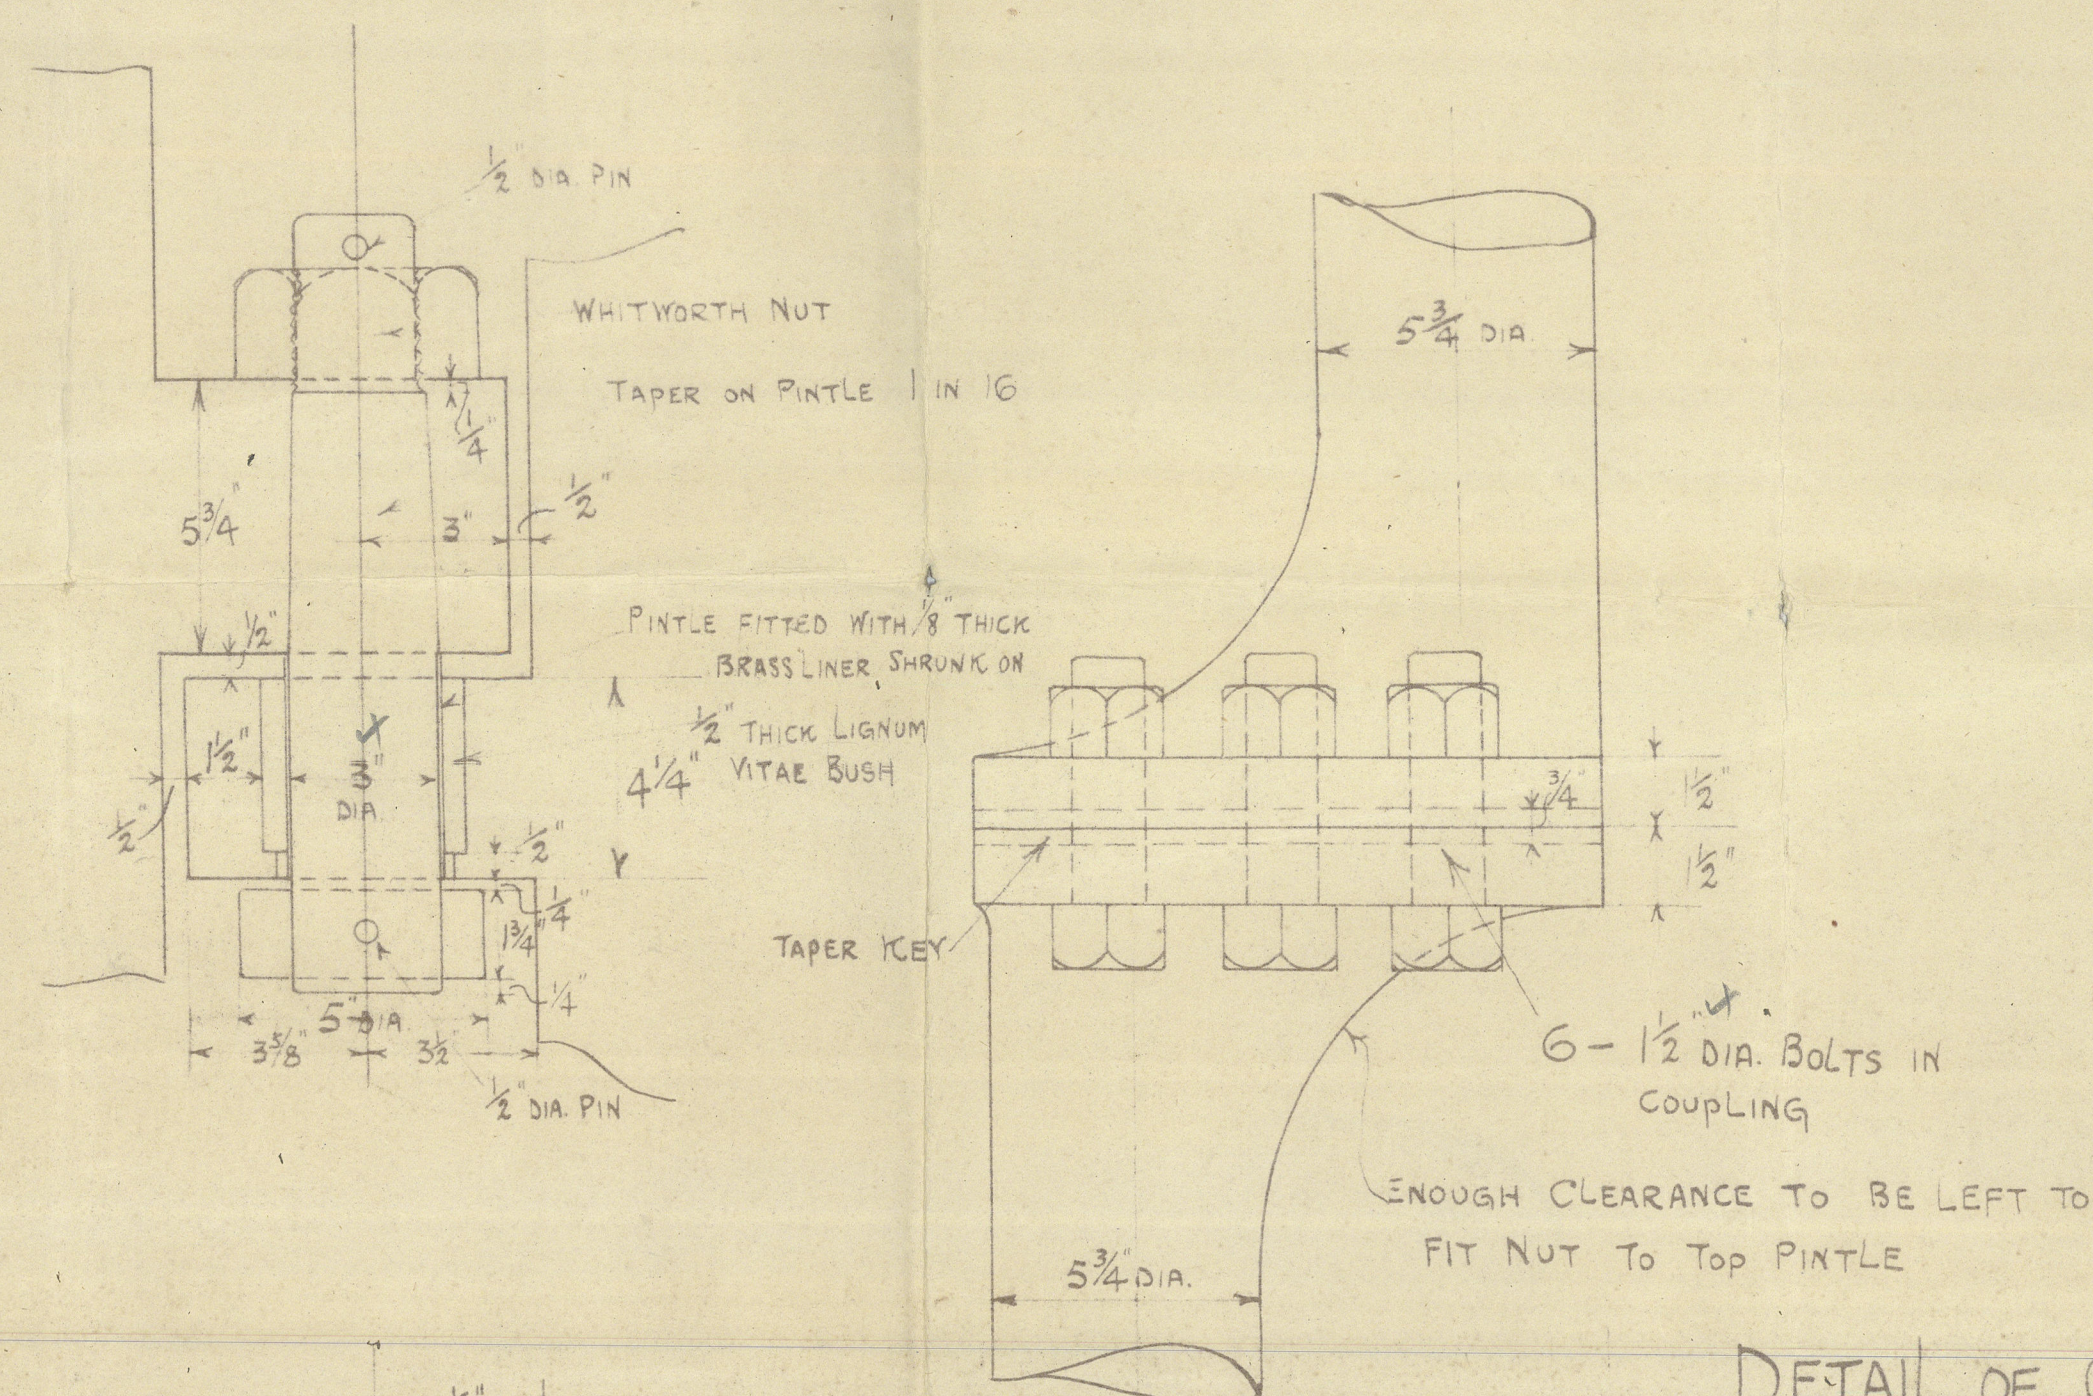


## DETAIL OF COUPLING

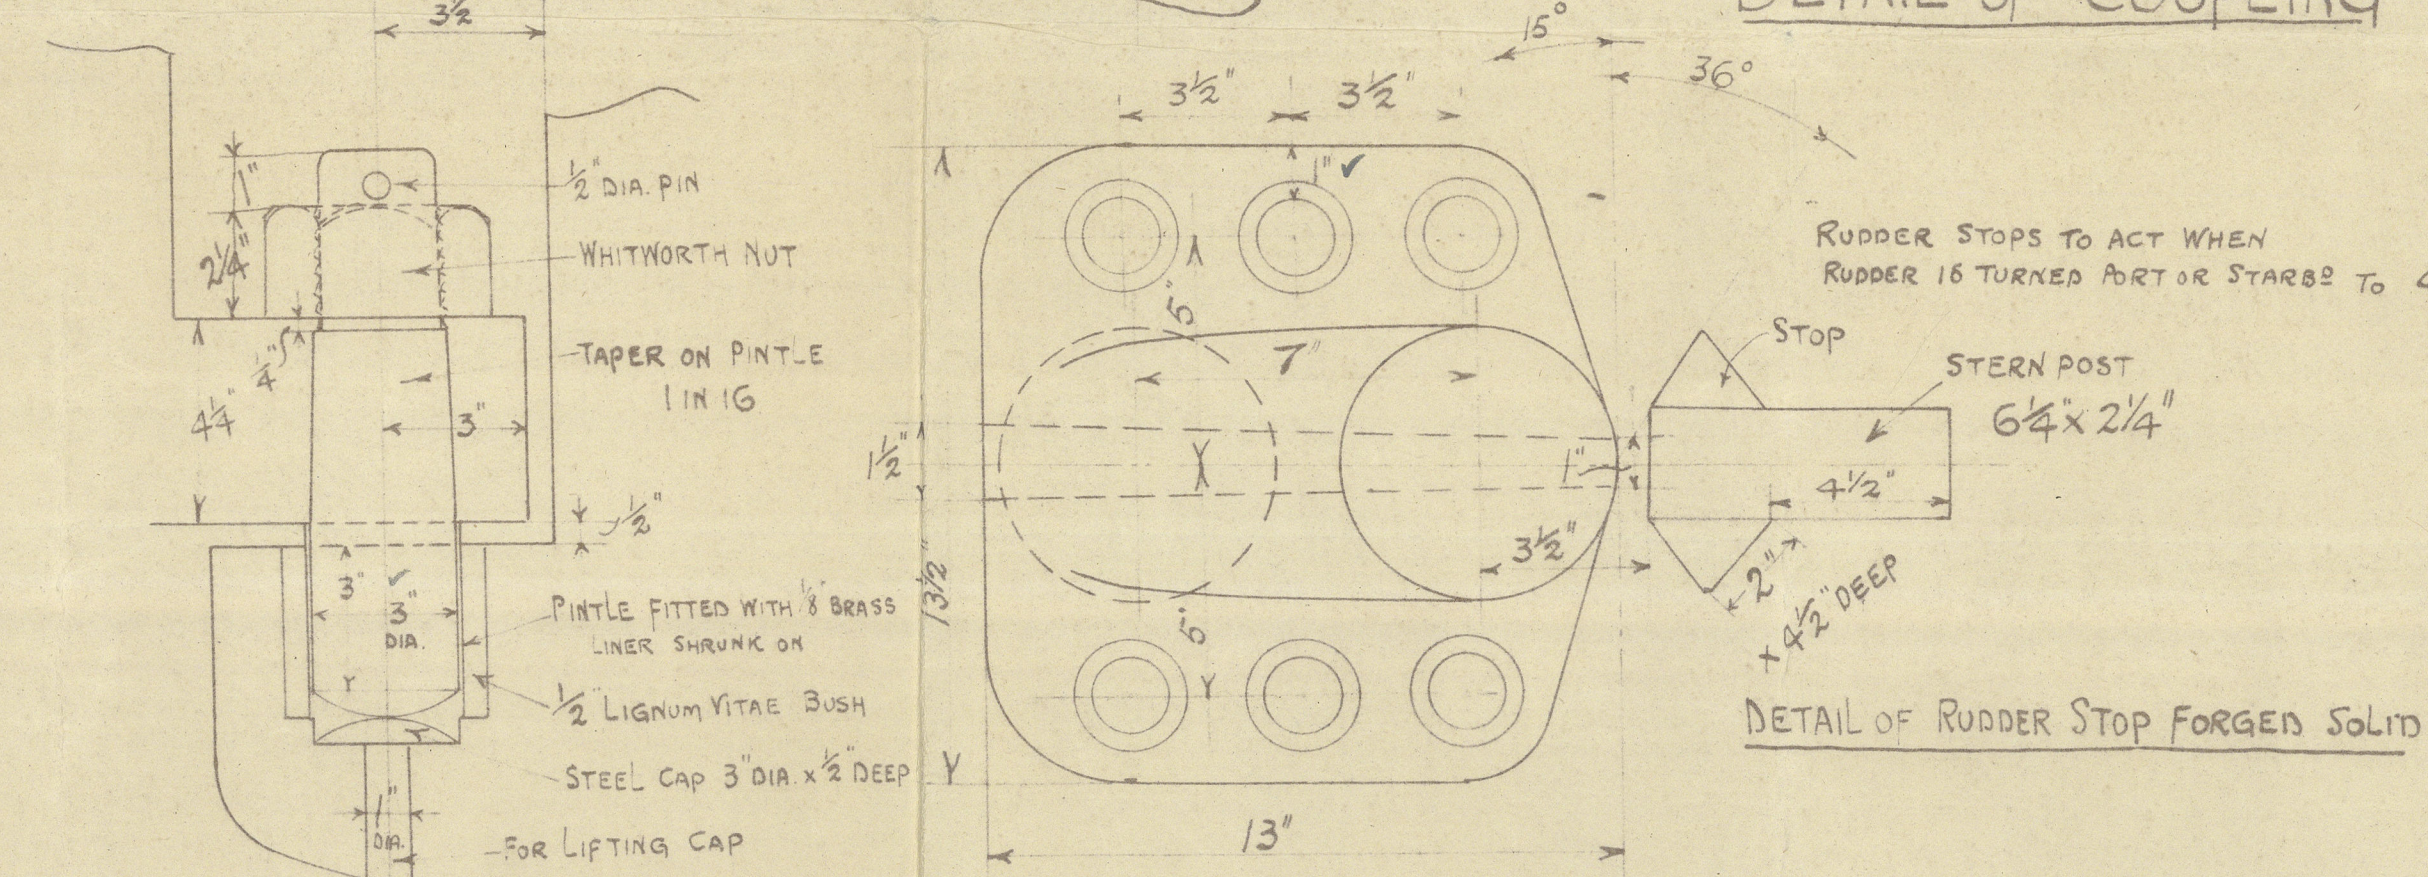


## DETAIL OF RUDDER STOP FORGED SOLID

## DETAIL OF BOTTOM PINTLE

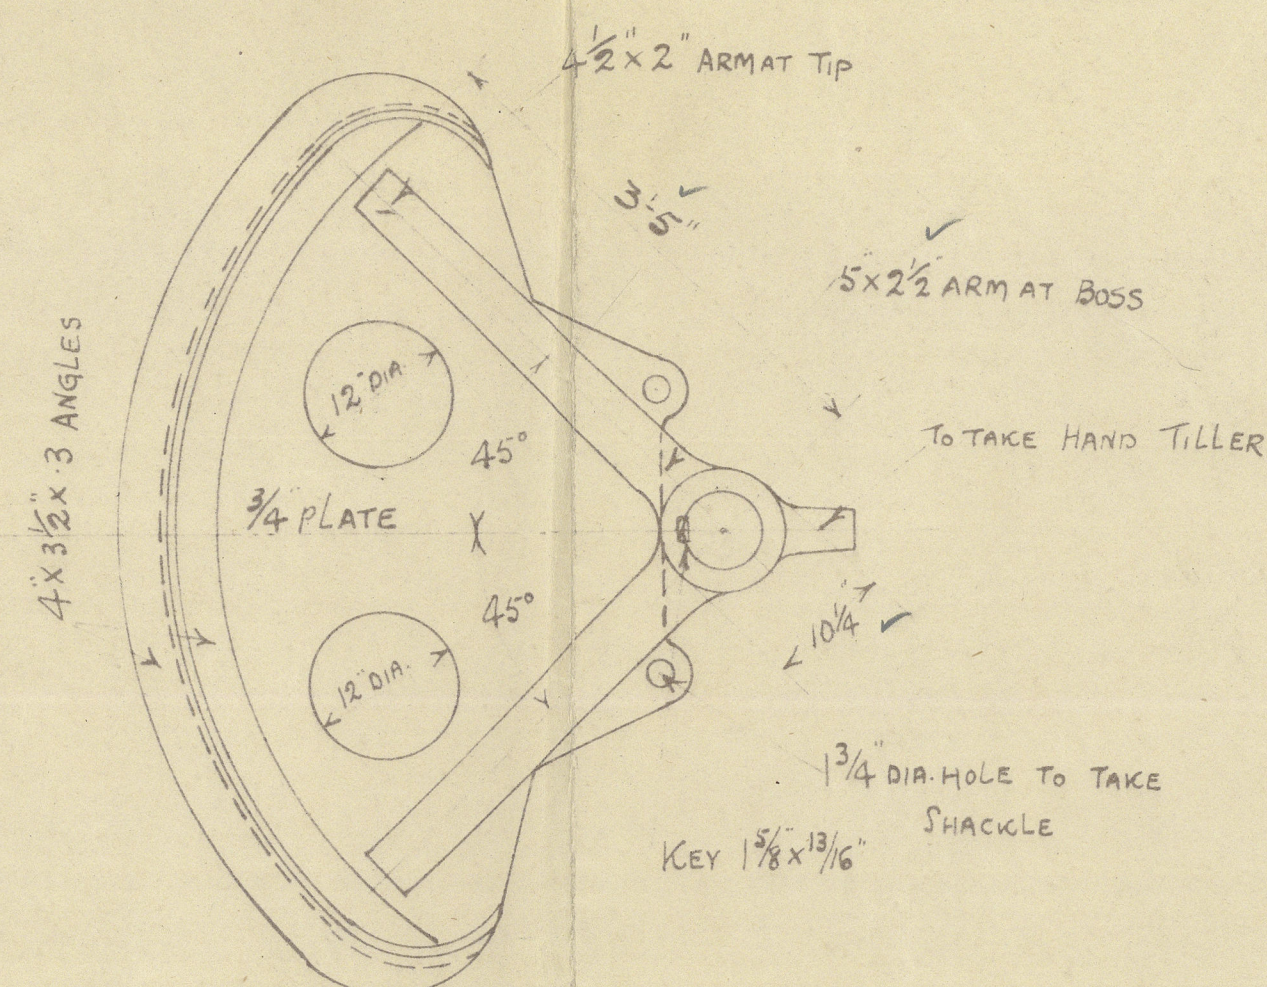


## PLAN OF QUADRANT

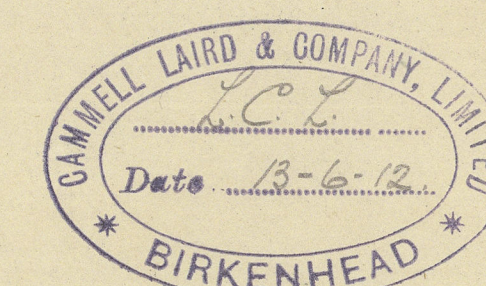

C.F.  
18/6/12

## DETAIL OF STEM

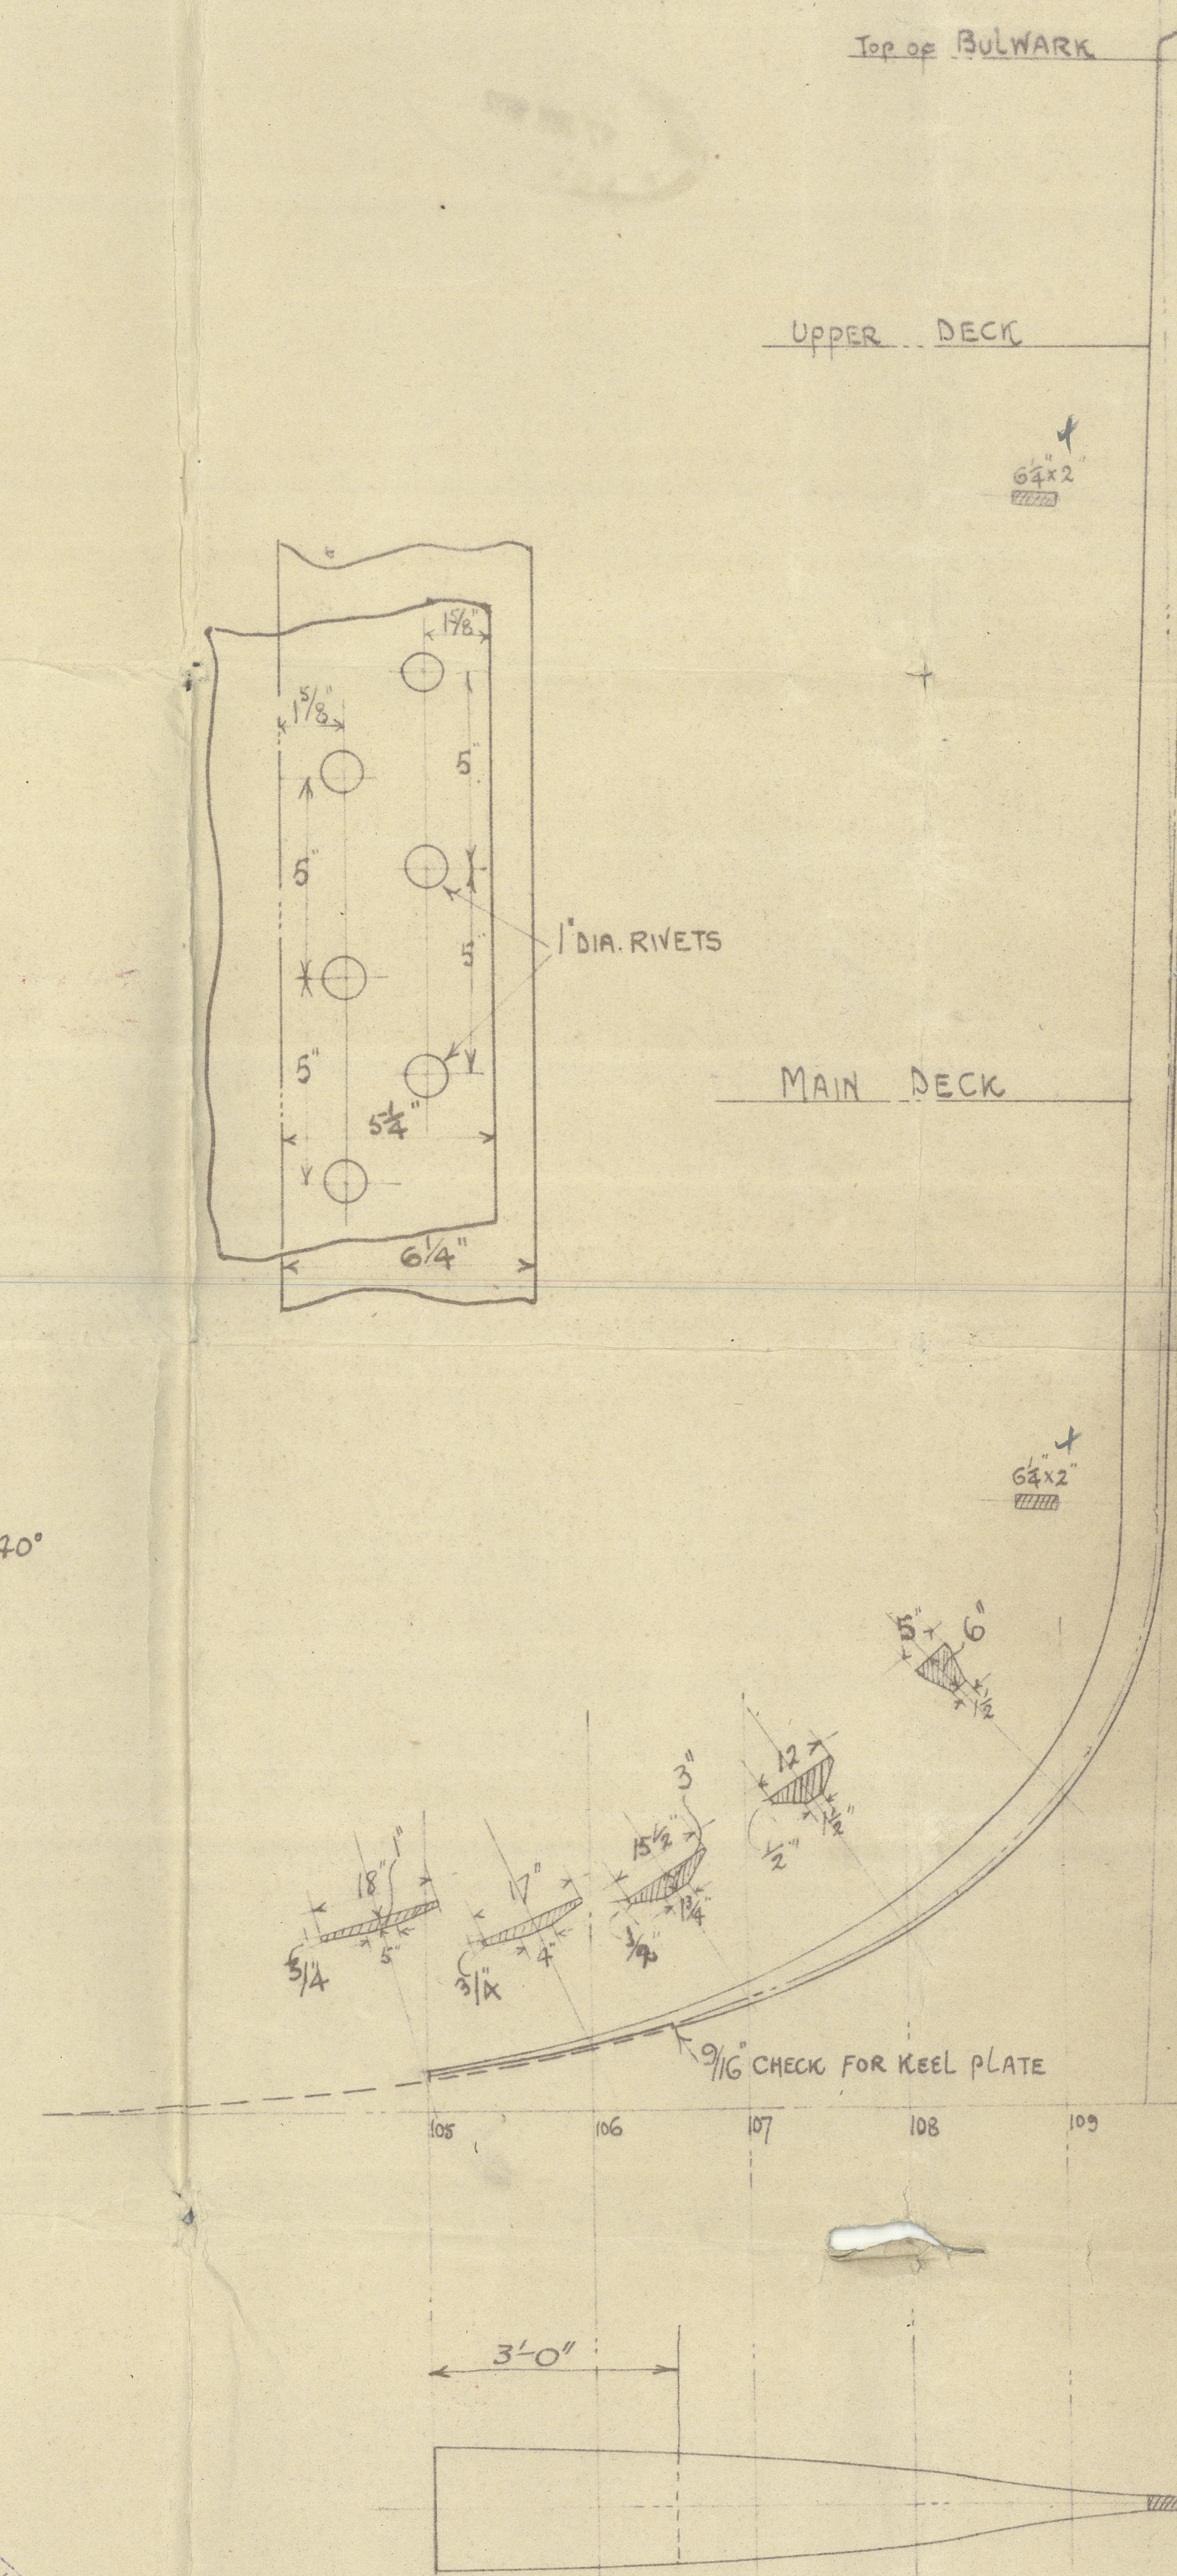

PLAN NO 14



1790

Stern frame

See

Rudder

Britannic  
ex  
1/1 'Doon

L. Laird Hecla N. 790.

Stern frame trudder.

His Rps N. 69371.



© 2020

Lloyd's Register  
Foundation

007396-007402-0237



10790

C. L. Co's



© 2020

Lloyd's Register  
Foundation